


PARTIAL ATTIC FLOOR PLAN

SCALE 1/8" = 1'-0"

LEGEND SHEET



ROOM	CARE
102	
101	
100	
99	
98	
97	

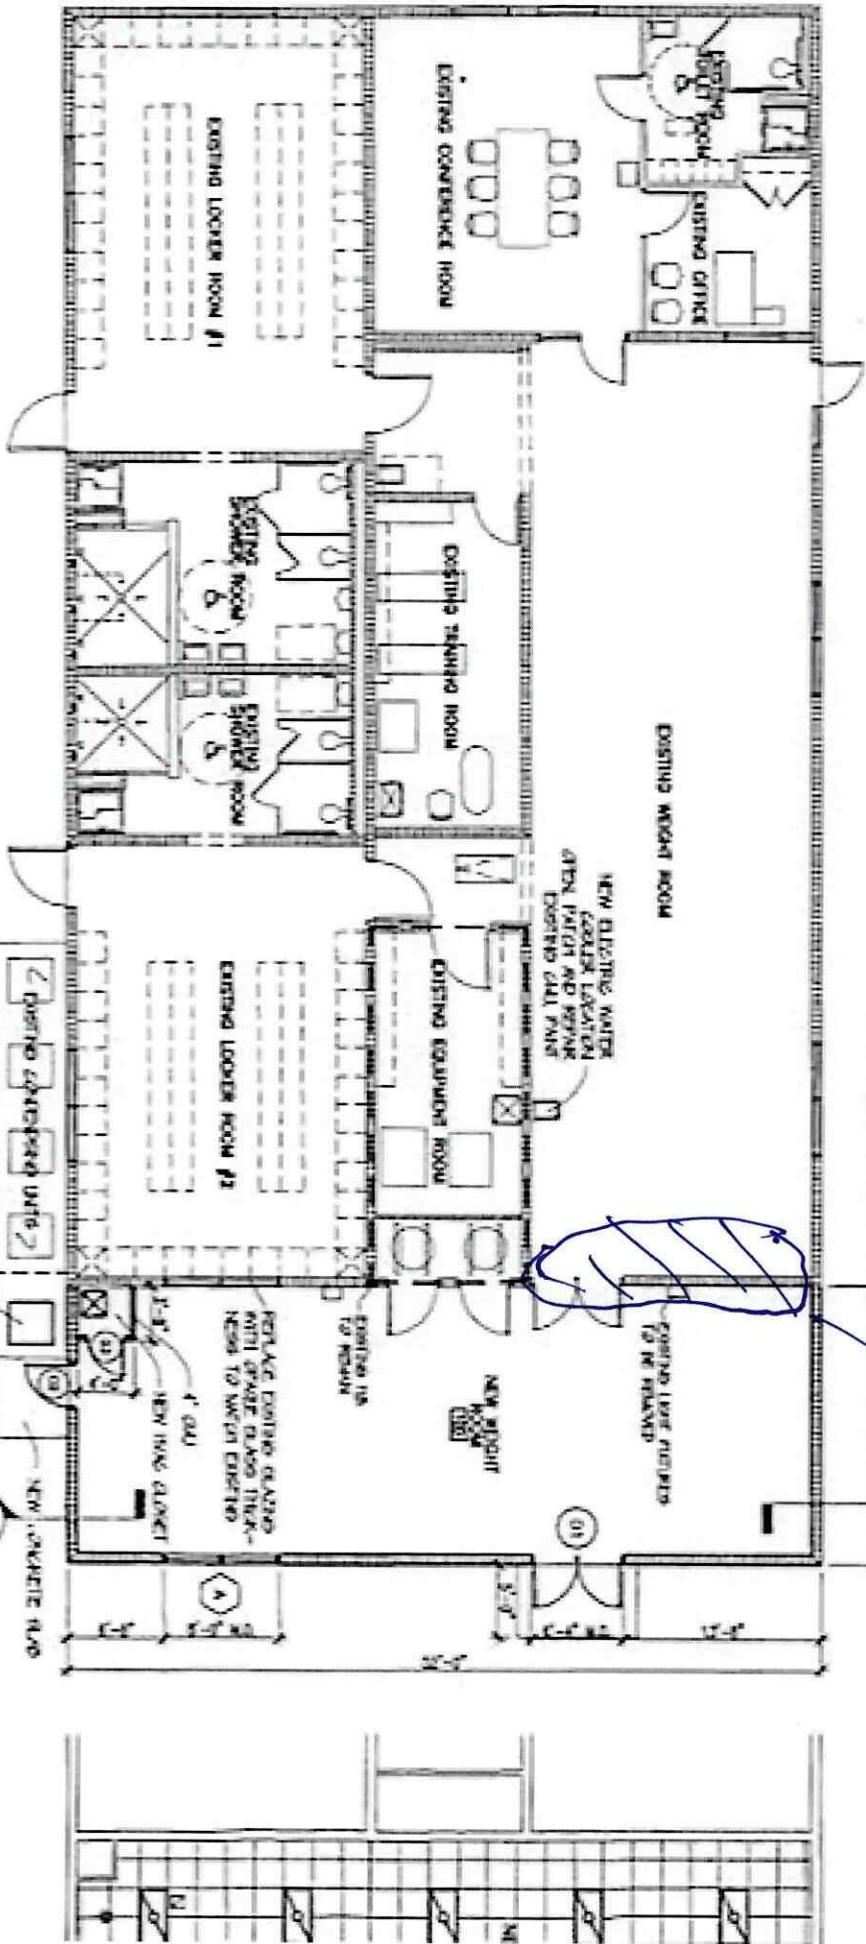

FLOOR PLAN

SCALE 1/8" = 1'-0"


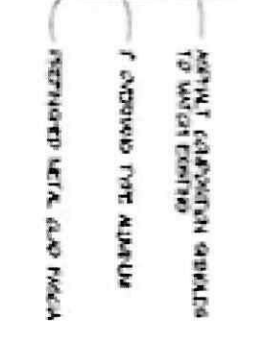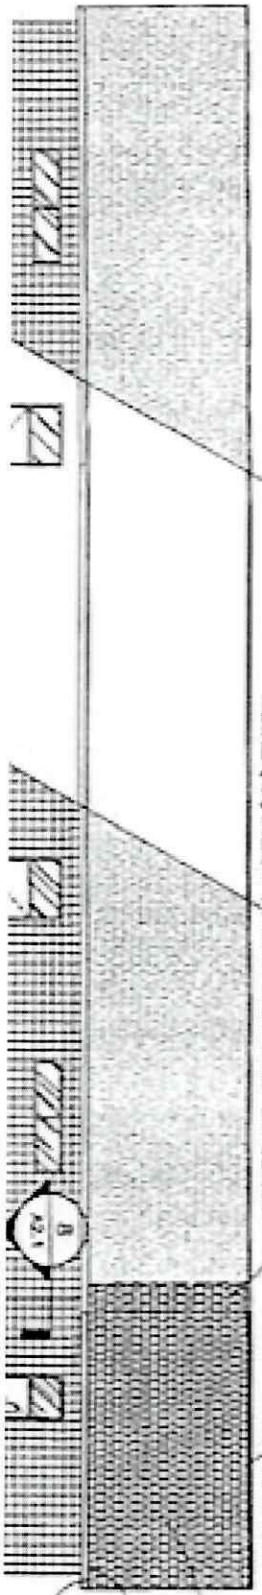

REFLECTED

SCALE 1/8" = 1'-0"

 CEILING JOIST

REMOVE