


NOTE:
DORMER DIMENSIONS TO OUTSIDE OF 2X FRAMING
CENTERED ON WALL BELOW (AS SHOWN)

1 ATTIC PLAN
SCALE: 3/32" = 1'-0"

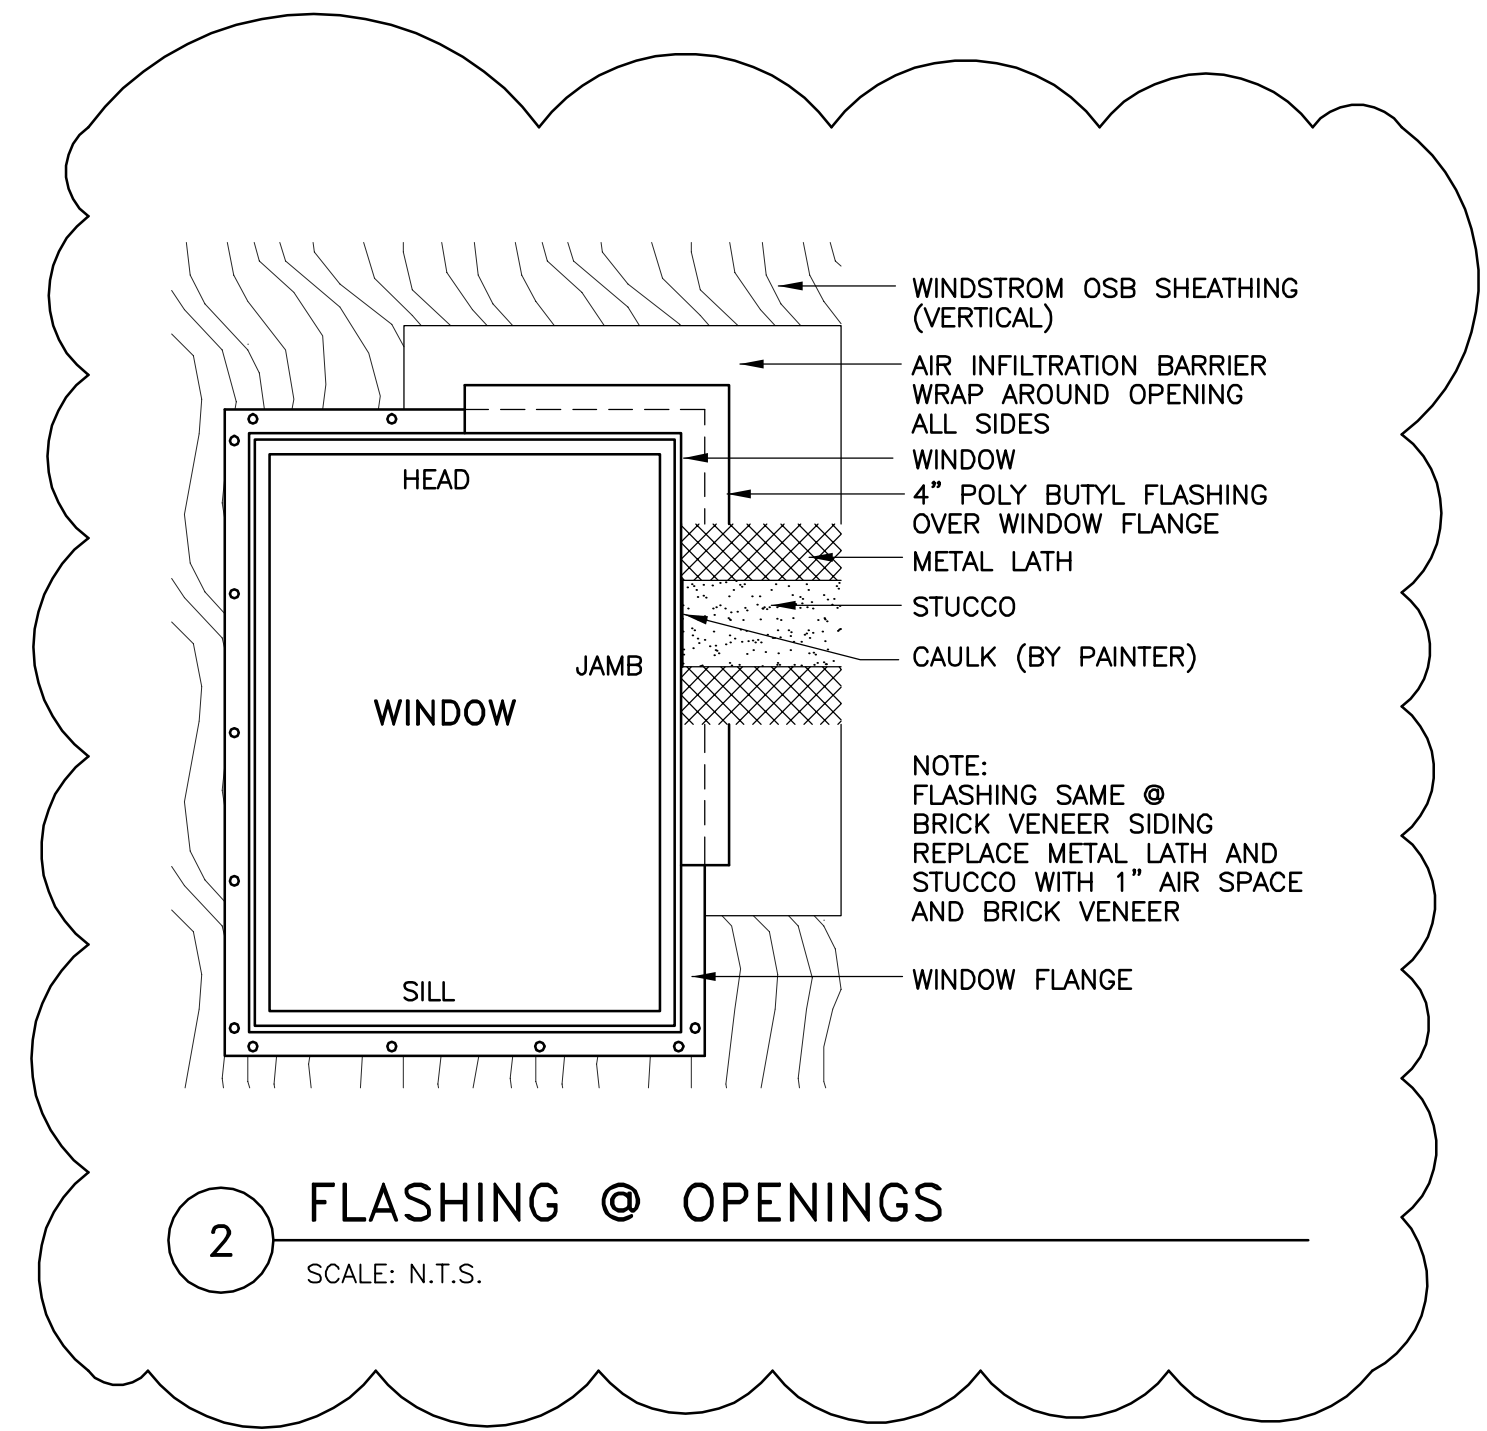

**ANDERSON MEMORY CARE
AT SUMMERFIELD
4104 DAUPHINE STREET SLIDELL, LOUISIANA**

DATE: 6 JULY 2010
PROJECT: 10-181

