



2 KITCHEN, REC ROOM
SCALE: 3/8" = 1'-0"

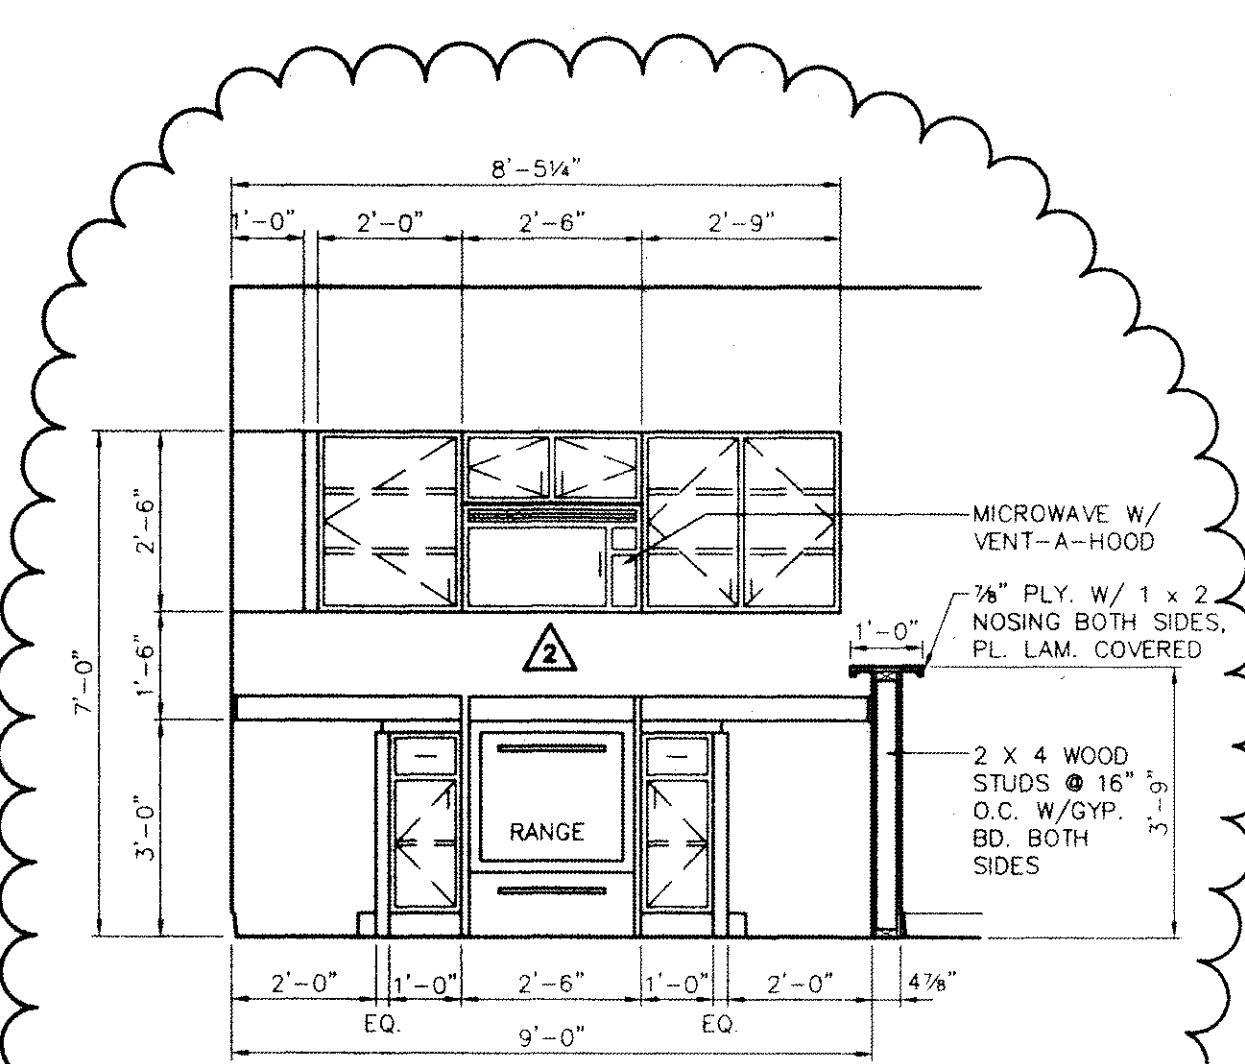


3 KITCHEN, REC ROOM
SCALE: 3/8" = 1'-0"

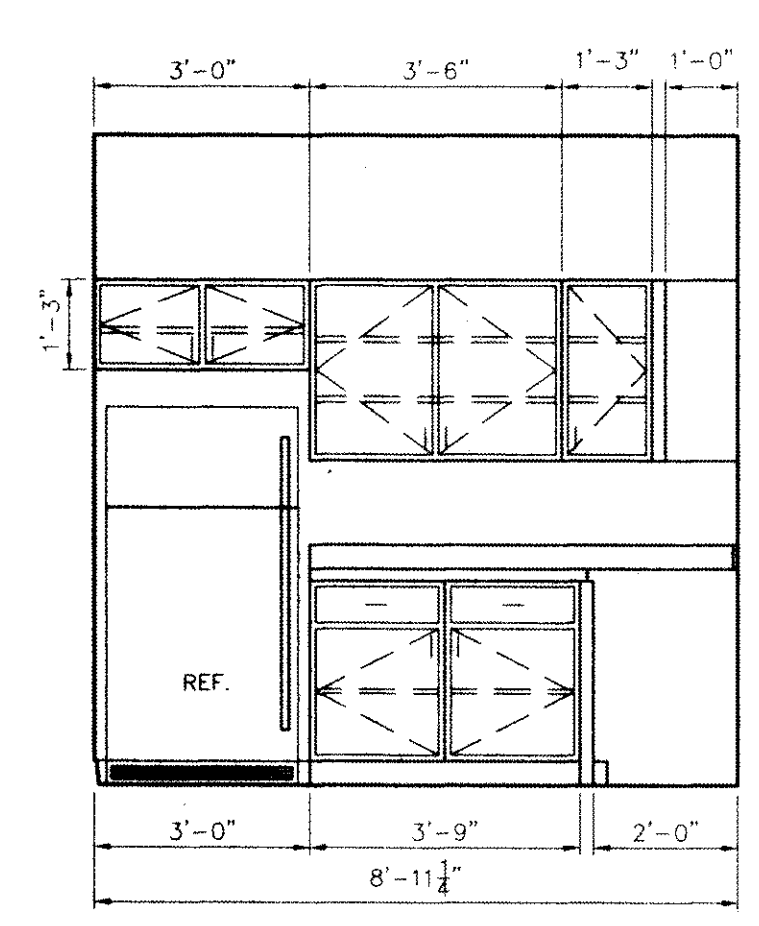

4 KITCHEN, REC ROOM
SCALE: 3/8" = 1'-0"

1 FIRST FLOOR PLAN-CLUBHOUSE
SCALE: 1/4" = 1'-0"

NOTES:
 1. ALL PLUMBING FIXTURE CONTROLS TO BE LEVER OPERATED BY NO MORE THAN 5 POUNDS PRESSURE MEETING ANSI A117 AND ASME/ANSI A112.18.
 2. PROVIDE WALLPAPER ALL WALLS IN BOTH RESTROOMS ON FIRST FLOOR CLUBHOUSE.

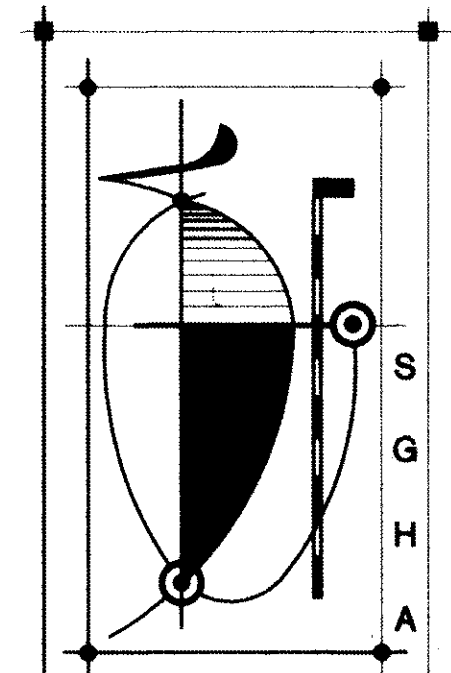


STEPHEN G. HILL ARCHITECT
 SIXTY SEVEN UNION AVE
 MEMPHIS TN 38103
 901-529-8117
 FAX: 901-523-0135
 CELL: 901-301-2874
 shill1@midssouth.rr.com

HOUSTON LEEVE TRAILS
 APARTMENTS
 SHELBY COUNTY, TENNESSEE

REVISIONS

REVISION NO. 1	11-23-99
REVISION NO. 2	1-7-00

FIRST FLOOR PLAN
 KITCHEN ELEVATIONS
 CLUBHOUSE
 DRAWN SGH
 CHECKED SGH
 DATE 9-28-99

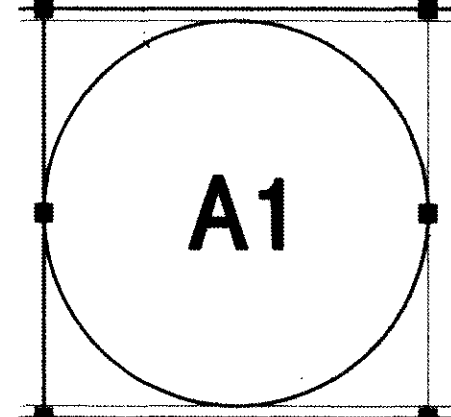

99105.13

© 1999 STEPHEN G. HILL ARCHITECT