

1  
A2







SECOND FLOOR PLAN-CLUBHOUSE

SCALE: 1/4" = 1'-0"


AREA SECOND FLOOR

ENCLOSED SPACE: 1,218 S.F.

EXTERIOR WALLS: 1,260 S.F.

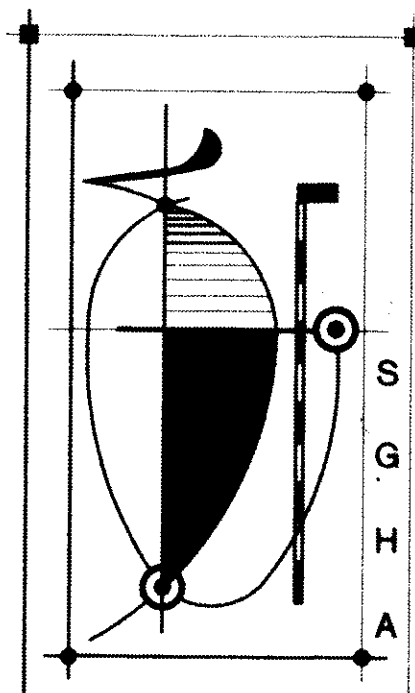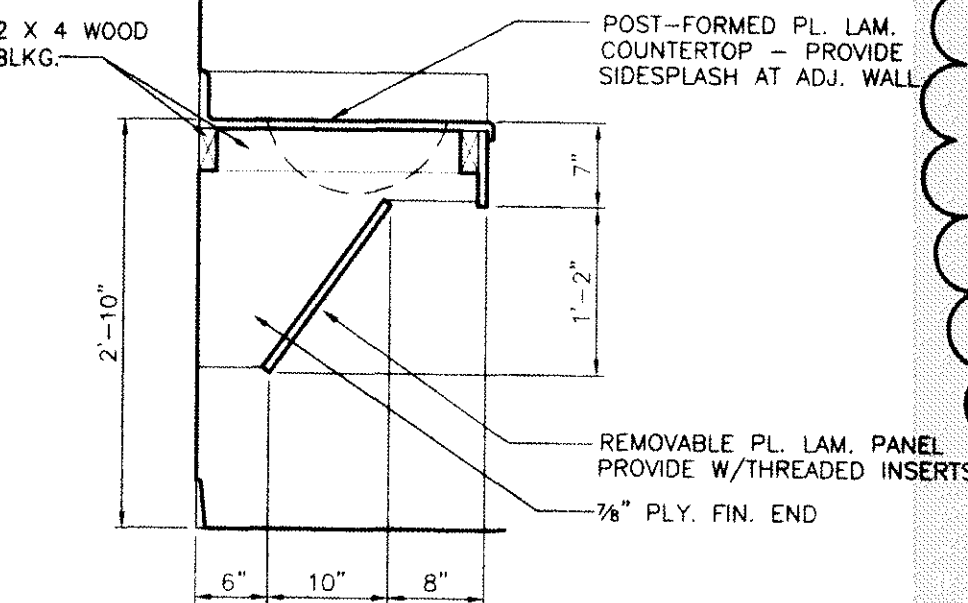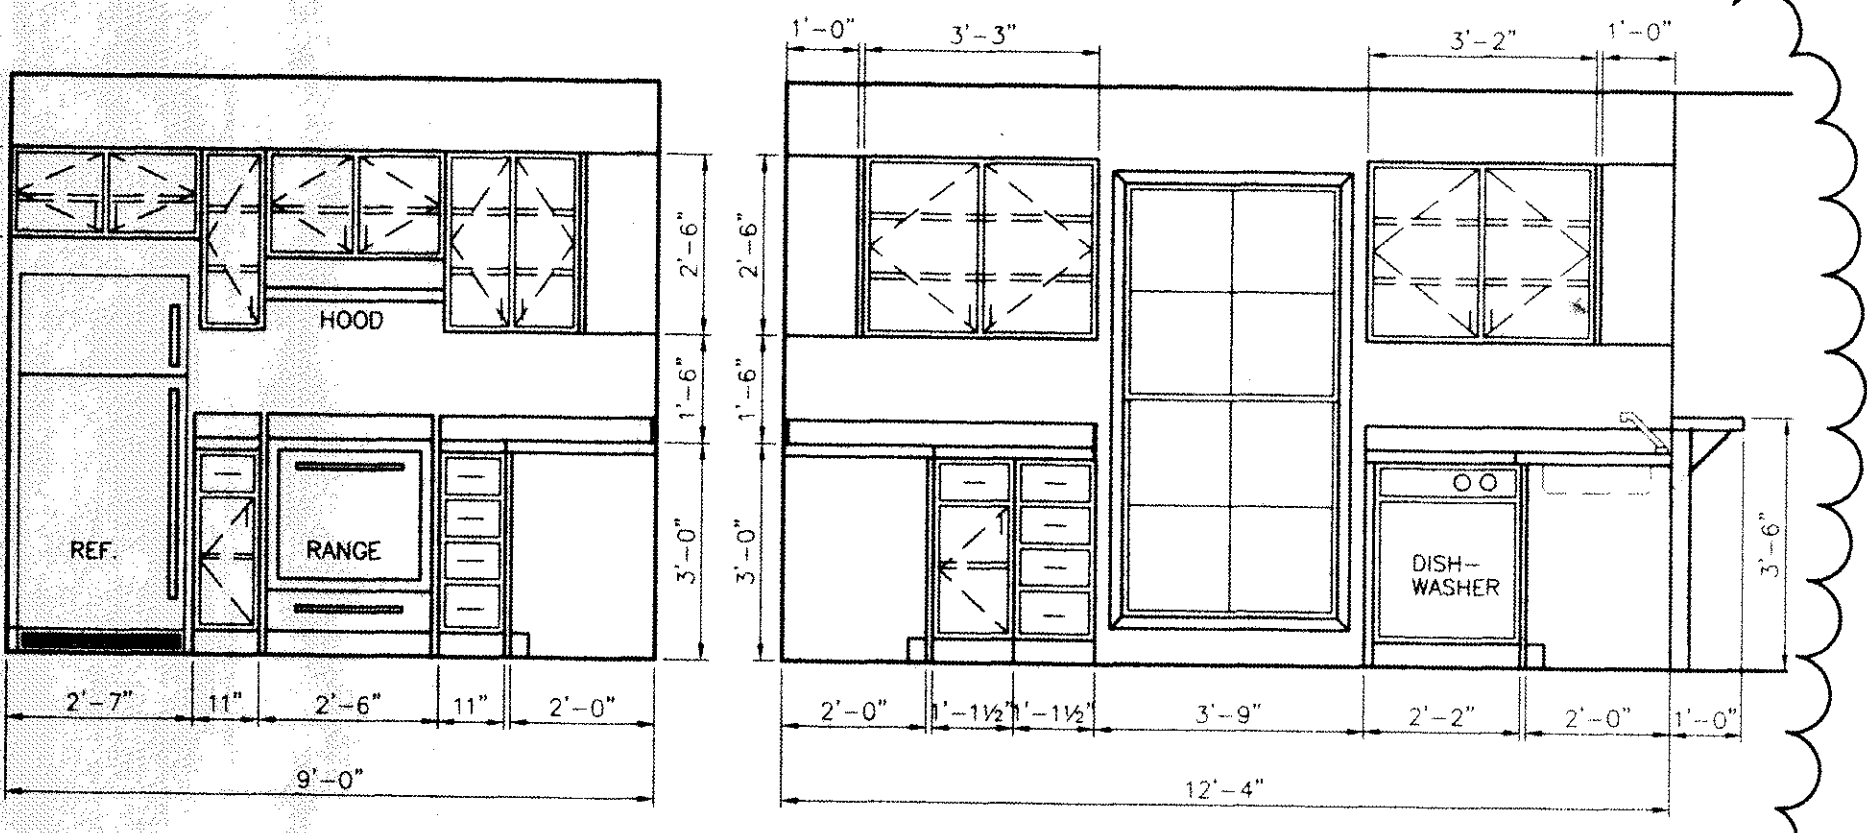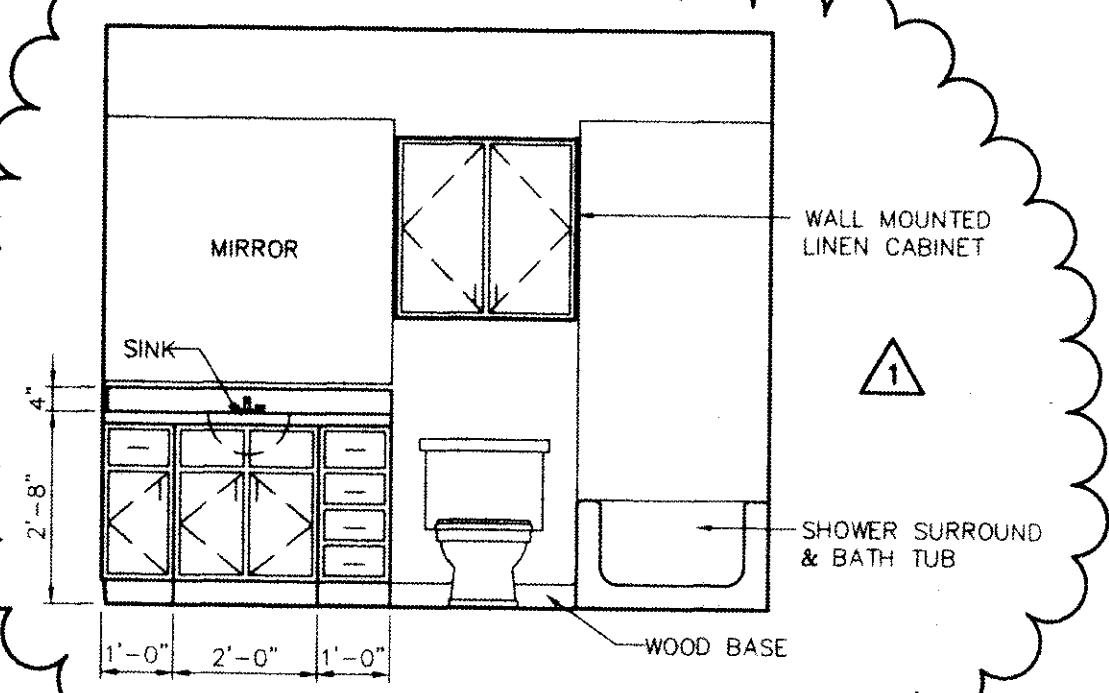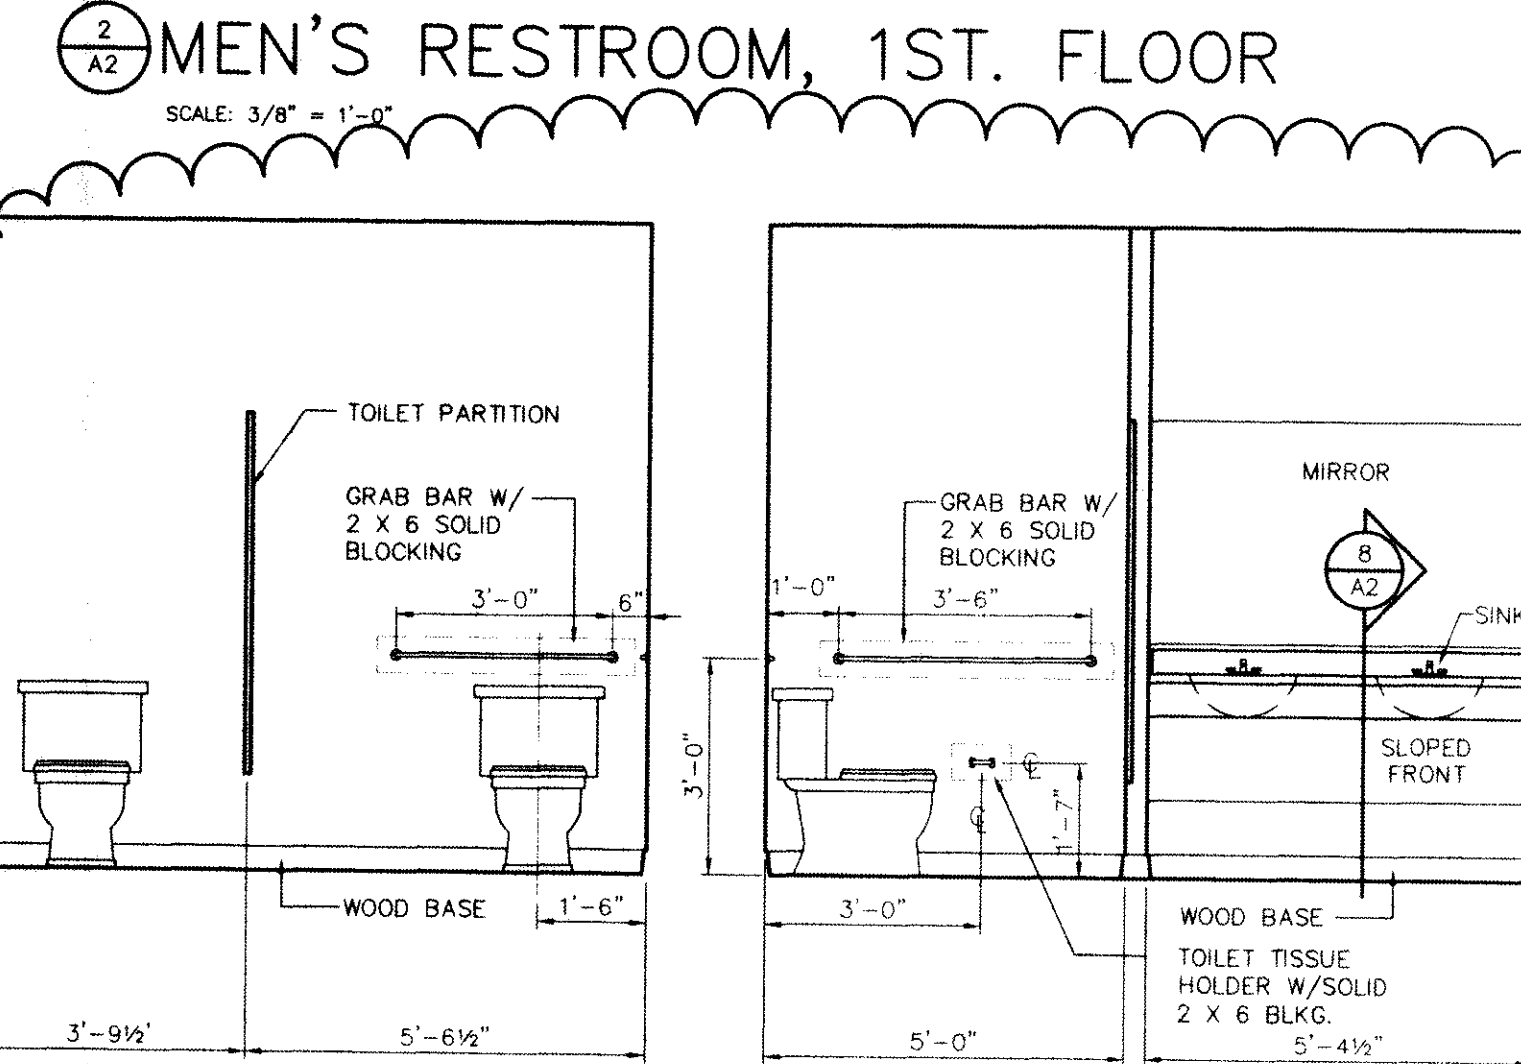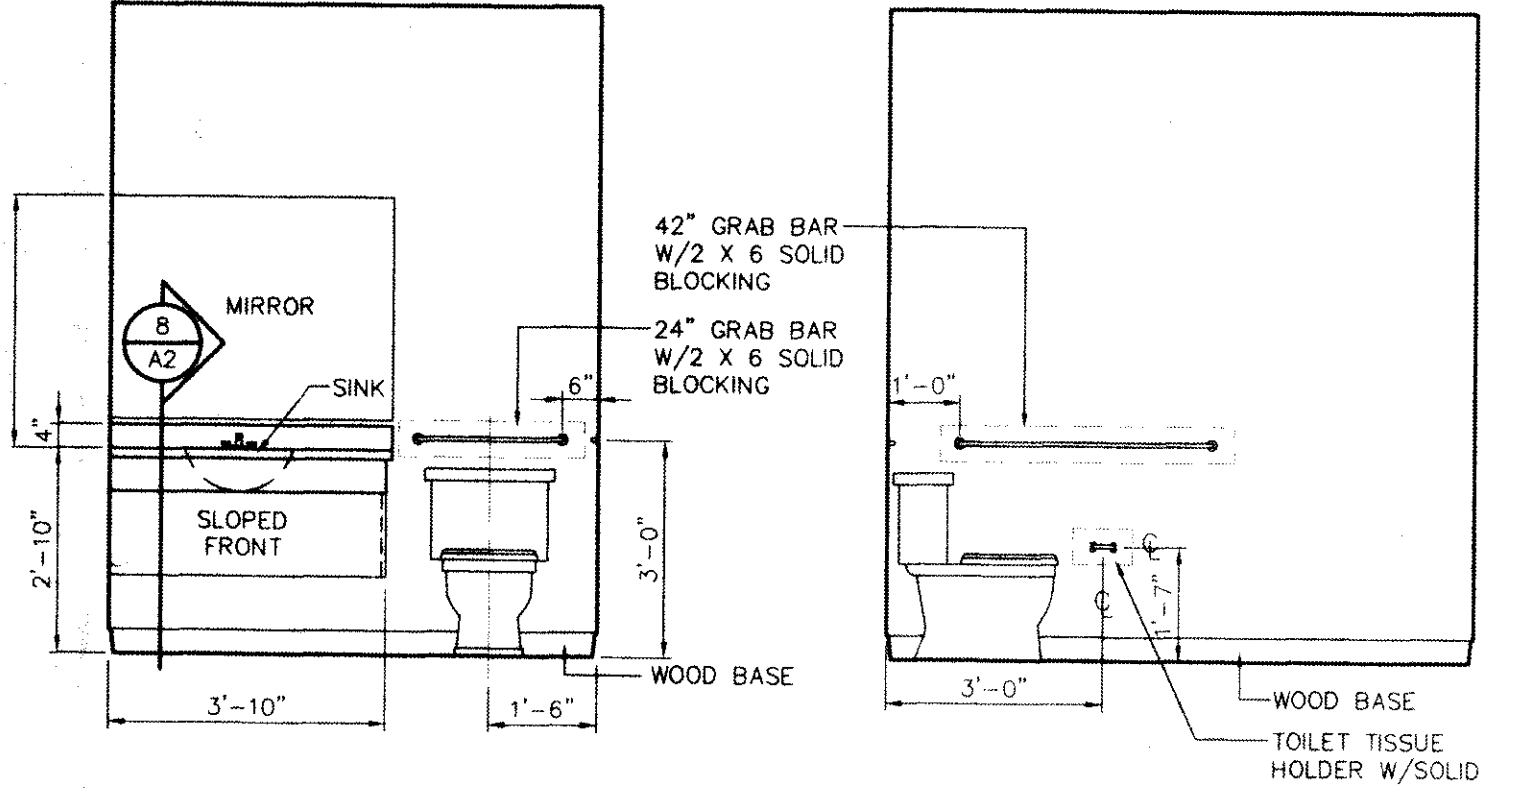

STEPHEN G. HILL ARCHITECT  
SIXTY SEVEN UNION AVE  
MEMPHIS TN 38103  
901-529-8117  
FAX: 901-523-0135  
CELL: 901-301-2874  
shill1@midssouth.rr.com

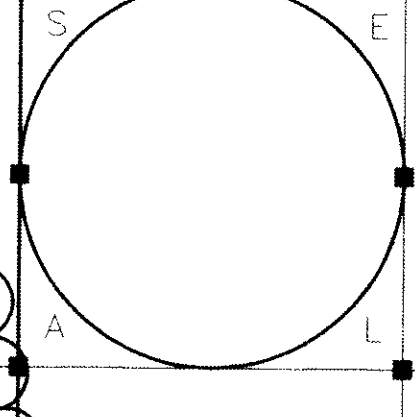

HOUSTON LEEVE TRAILS APARTMENTS  
SHELBY COUNTY, TENNESSEE

REVISIONS


1	REVISION NO. 1	11-23-99
2	REVISION NO. 2	1-7-00

SECOND FLOOR PLAN

INTERIOR ELEVATIONS

CLUBHOUSE

DRAWN	SGH
CHECKED	SGH
DATE	9-28-99

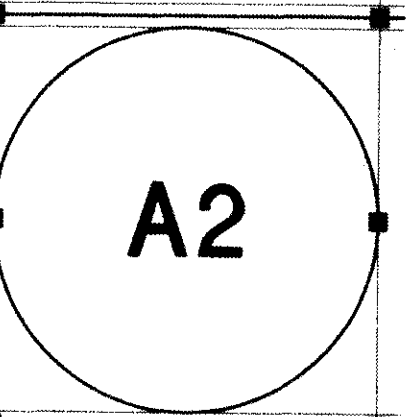

99105.13

© 1999 STEPHEN G. HILL ARCHITECT