


SECOND FLOOR PLAN — BUILDING TYPE B

1/8" = 1'-0"

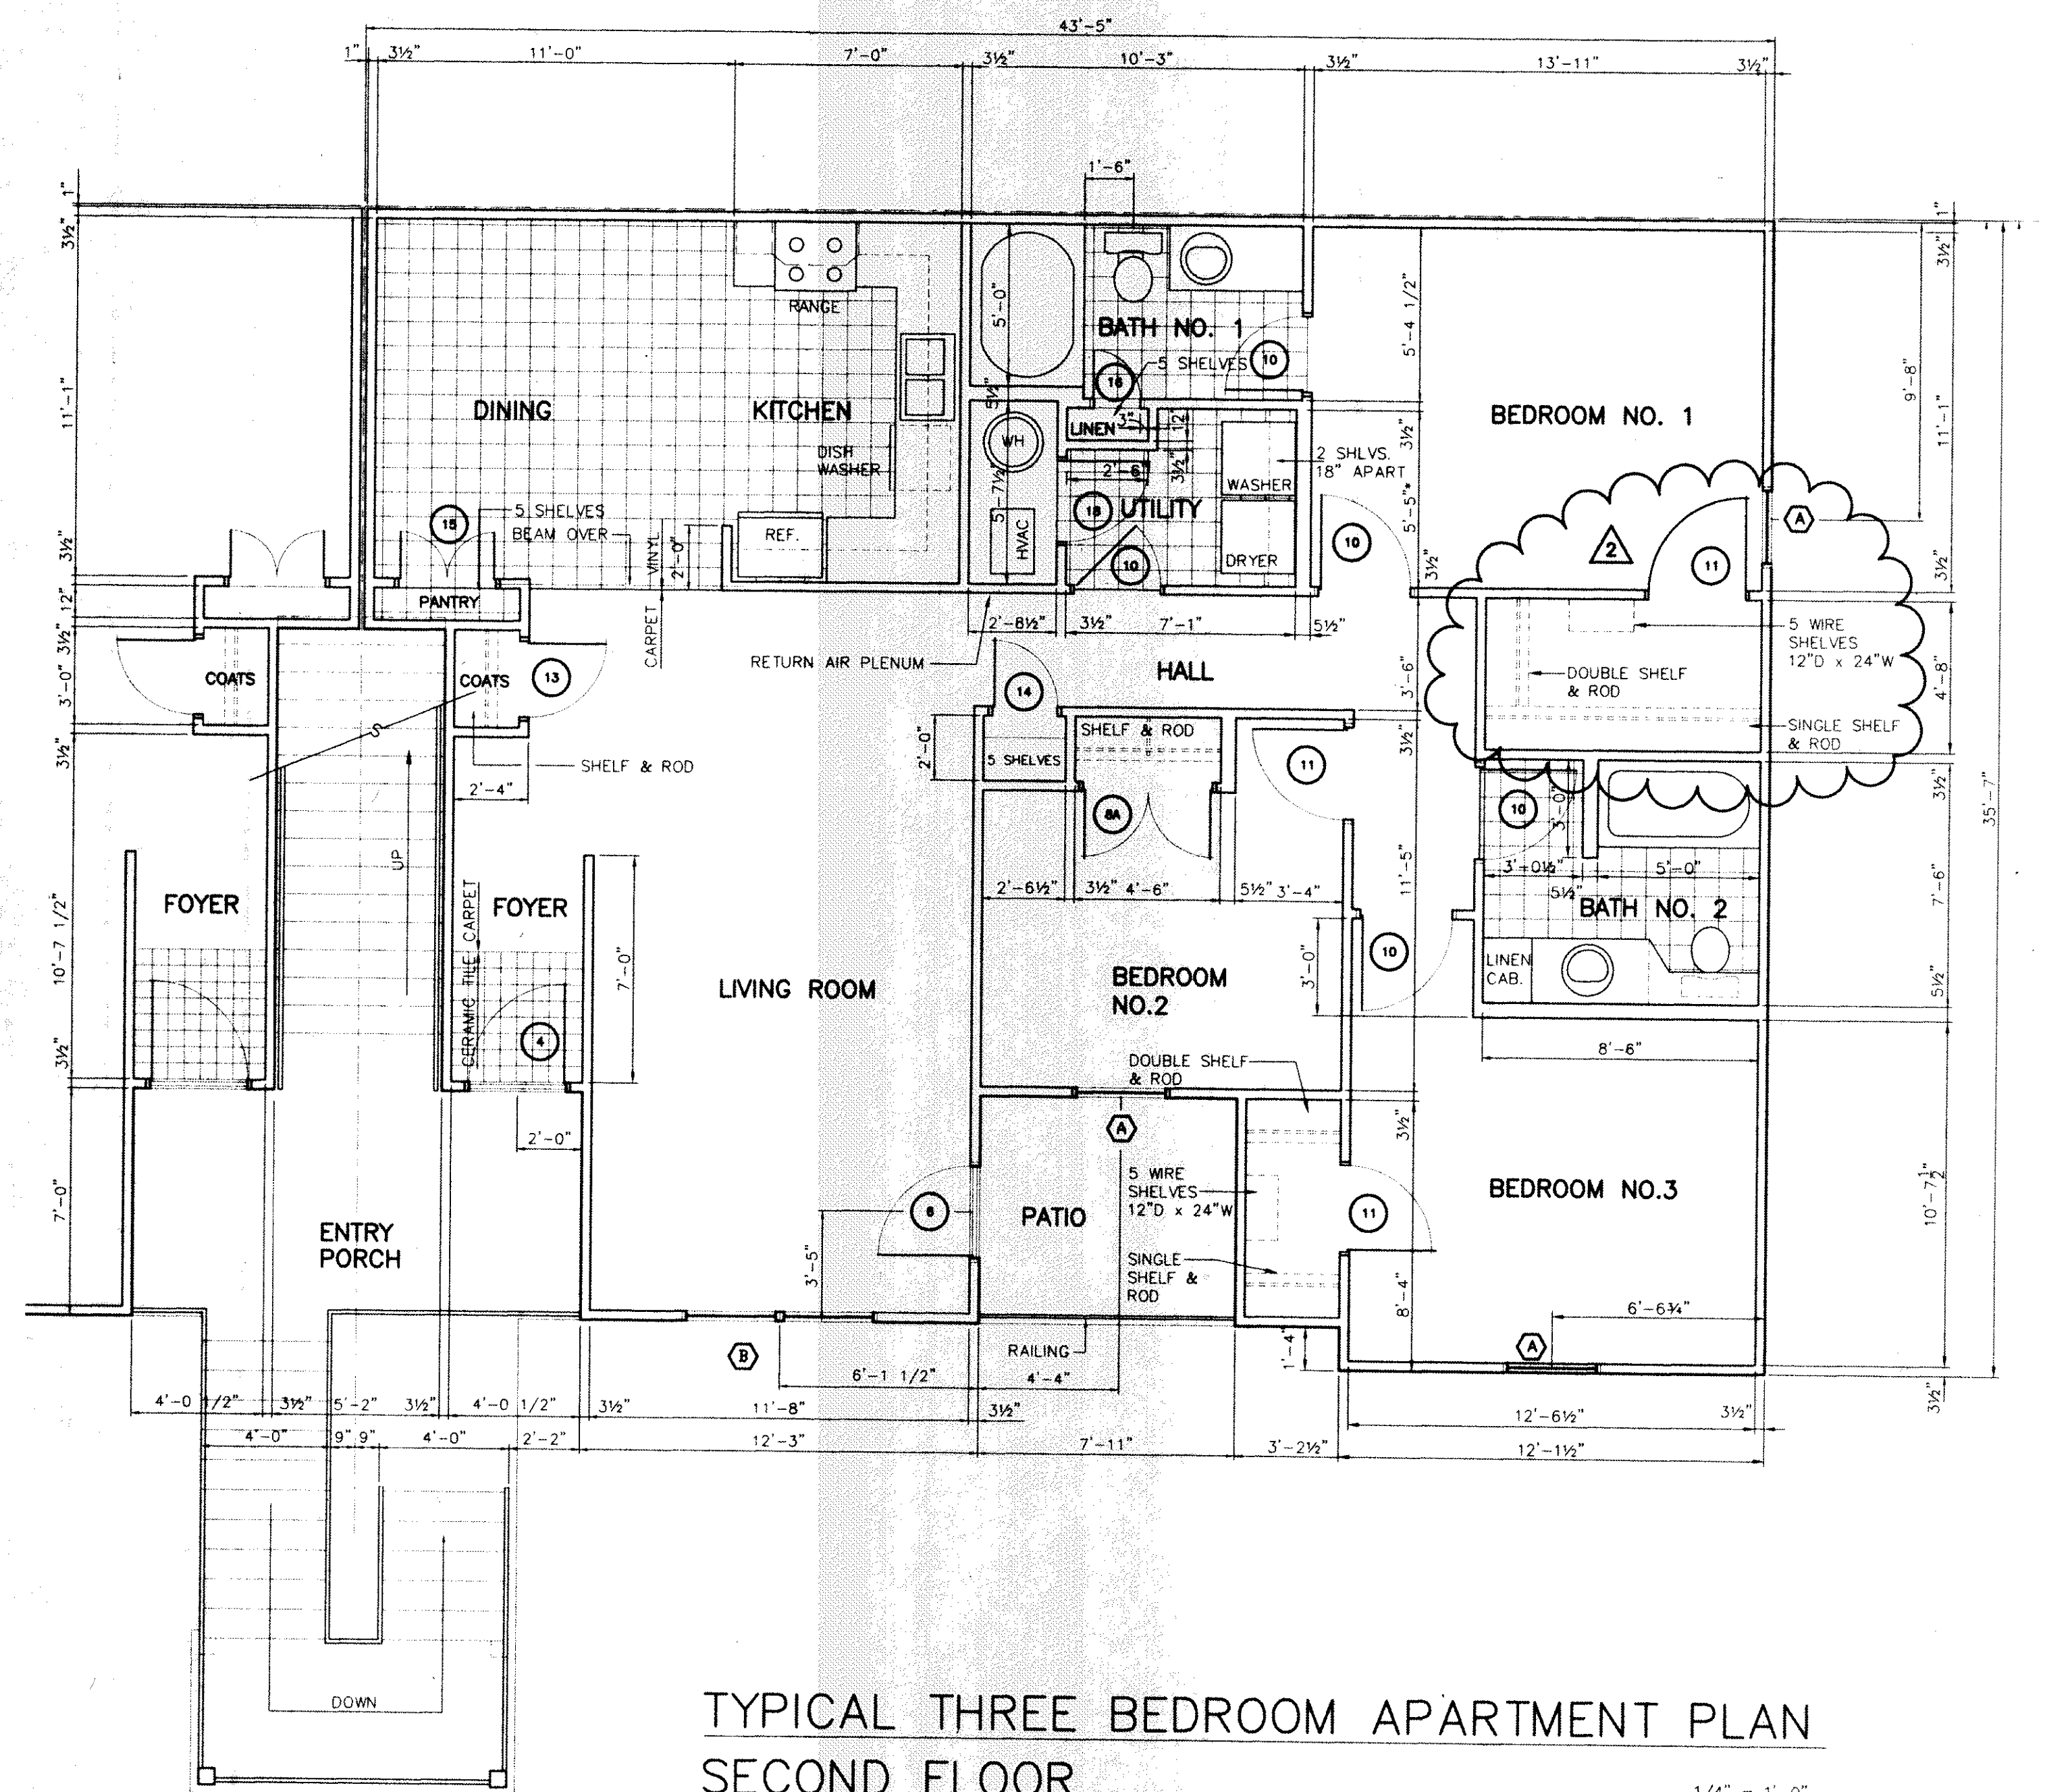


TYPICAL THREE BEDROOM APARTMENT PLAN
SECOND FLOOR

1/4" = 1'-0"

NOTES:

1. CONDITIONED AREA (EXCLUDING EXTERIOR WALLS) = 1310 SQUARE FEET.

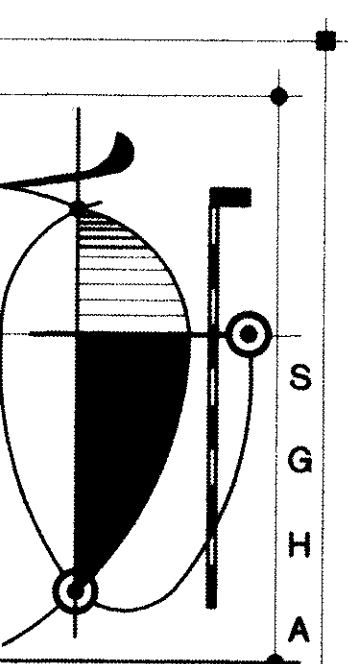


STEPHEN G. HILL
ARCHITECT
SIXTY SEVEN UNION AVE
MEMPHIS TN 38103
901-529-8117
FAX: 901-523-0135
CELL: 901-301-2874
shill1@midsouth.rr.com

HOUSTON LEEVE TRAILS
APARTMENTS
SHELBY COUNTY, TENNESSEE

REVISIONS
A REVISION NO. 2
1-7-00

SECOND FLOOR PLAN
BUILDING TYPE "B"

DRAWN SGH
CHECKED SGH
DATE 9-28-99

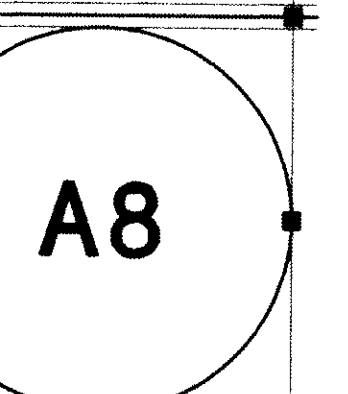

99105.13

© 1999 STEPHEN G. HILL ARCHITECT