



1
A10 **ROOF PLAN**
SCALE: 1/8" = 1'-0"


NOTE: BUILDING "A" SHOWN, BUILDING "B" SIMILAR

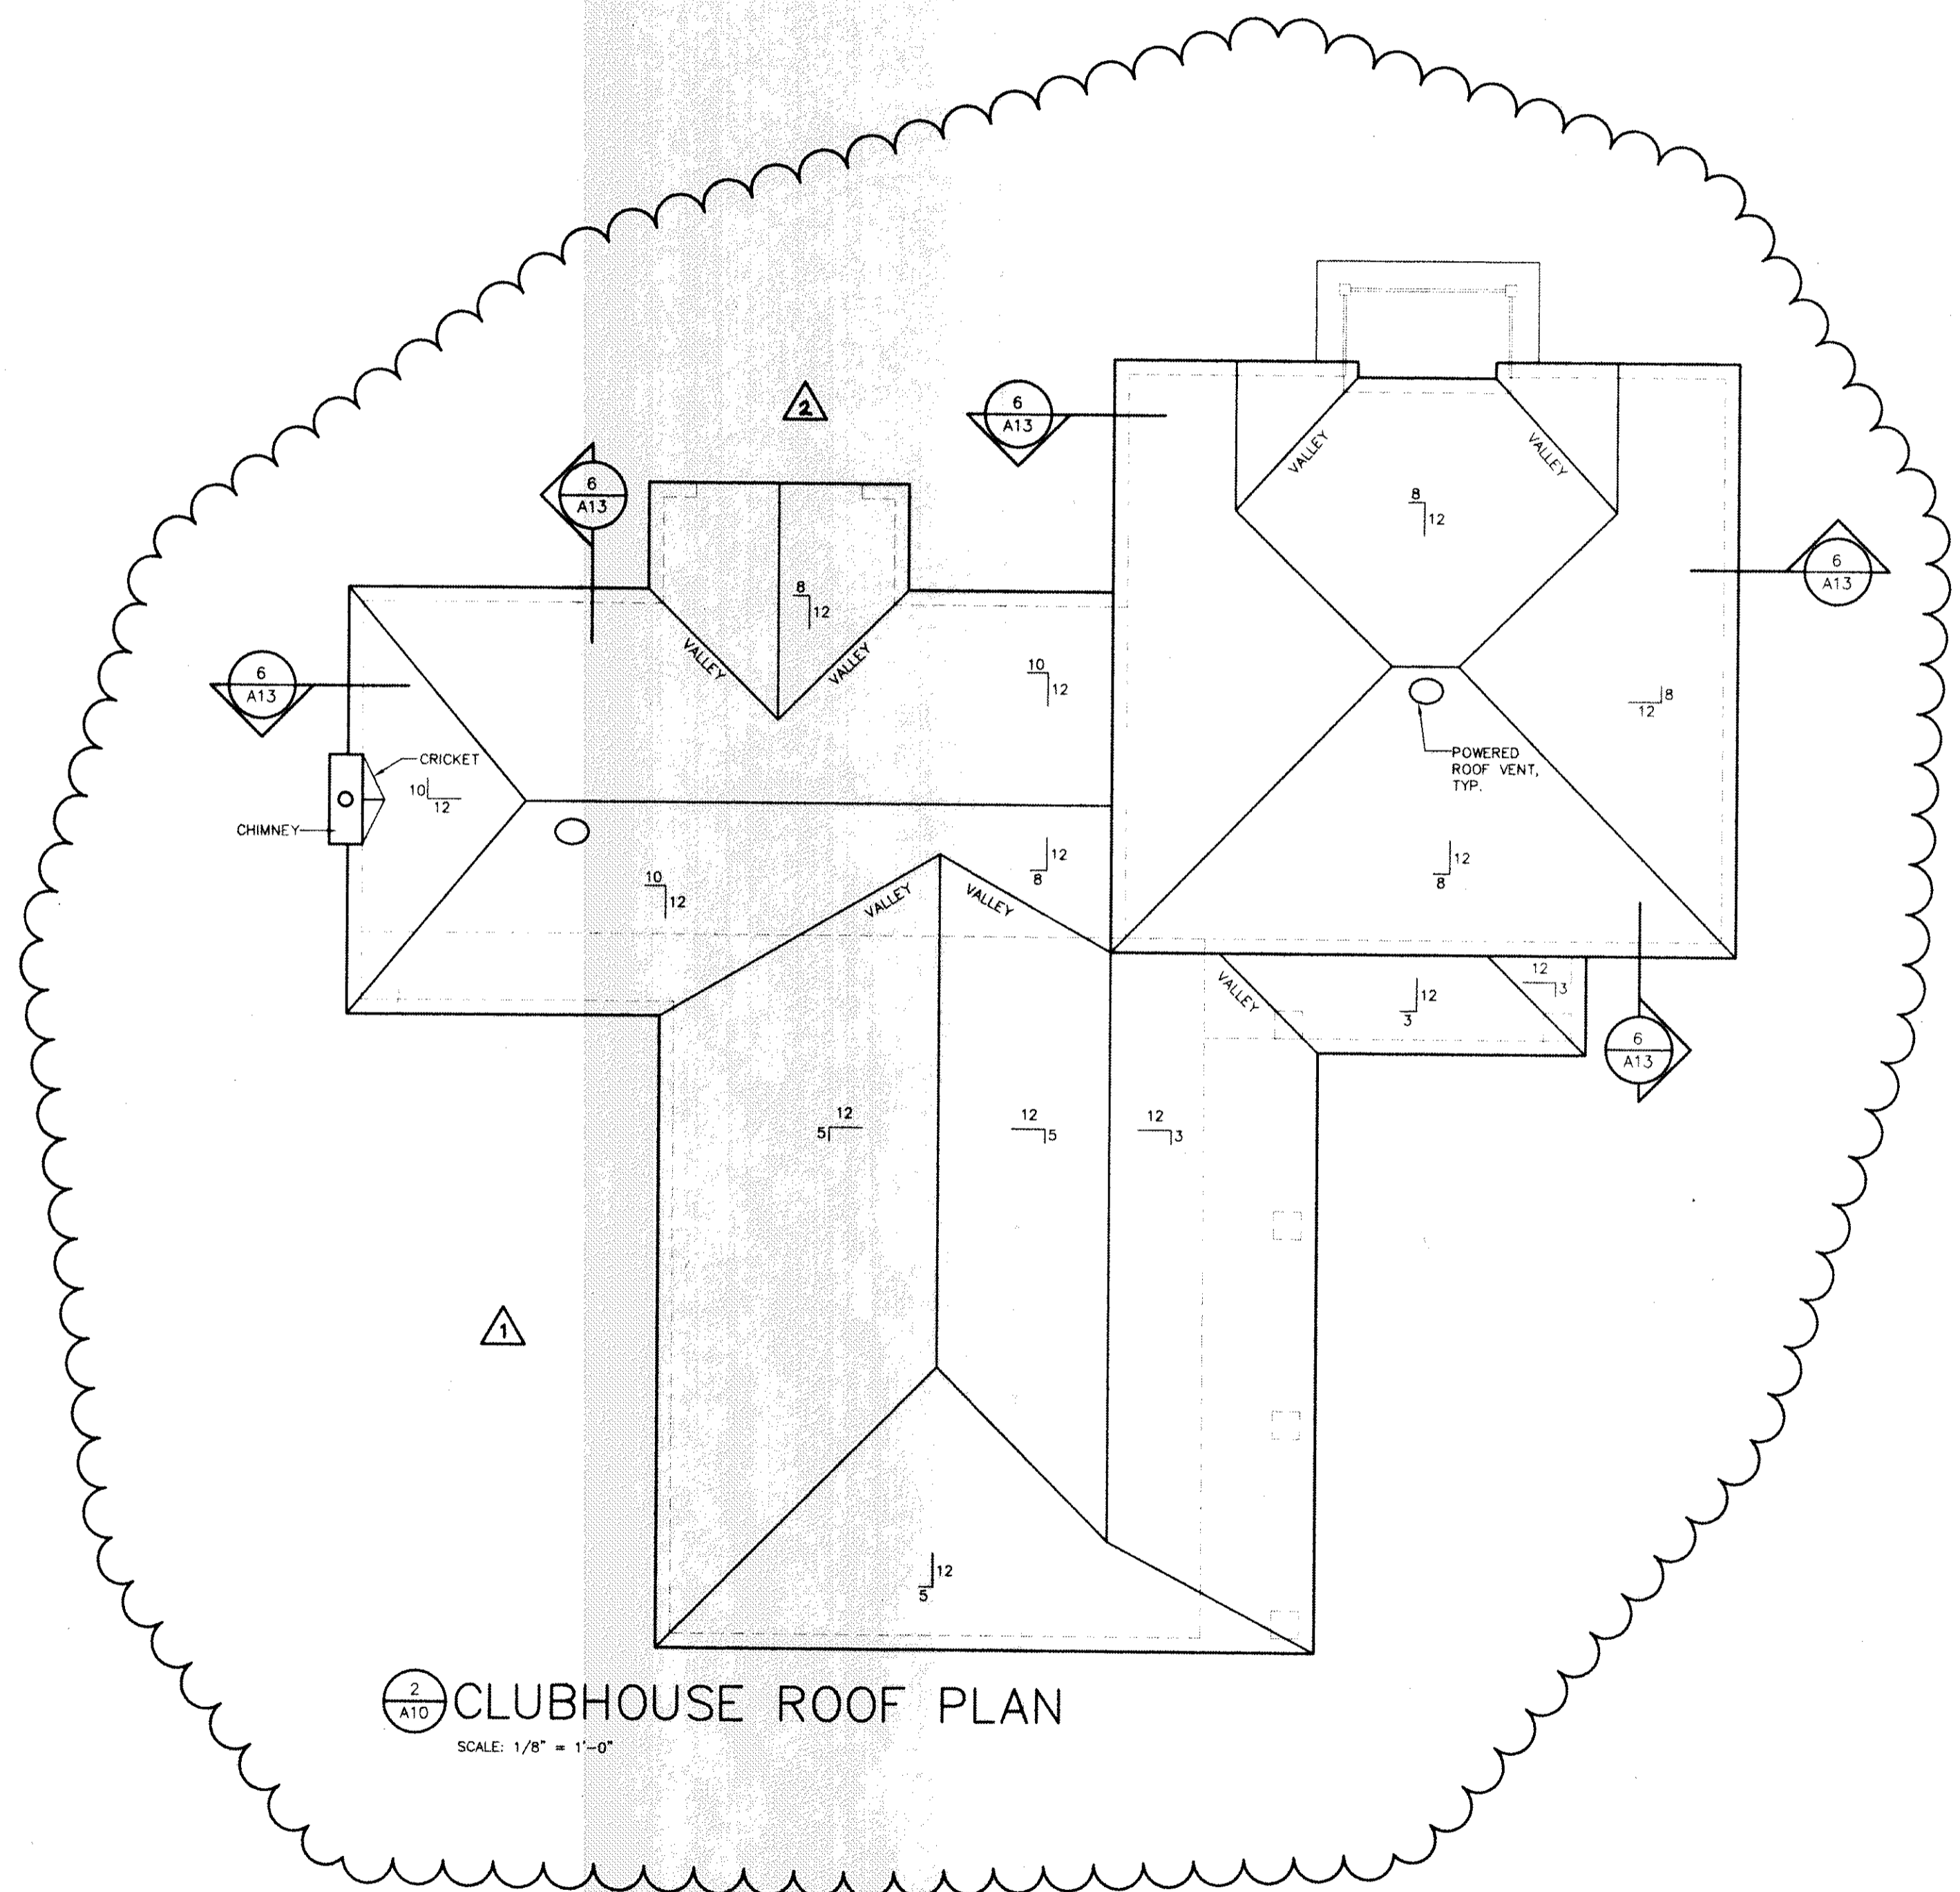

2
A10 **CLUBHOUSE ROOF PLAN**
SCALE: 1/8" = 1'-0"

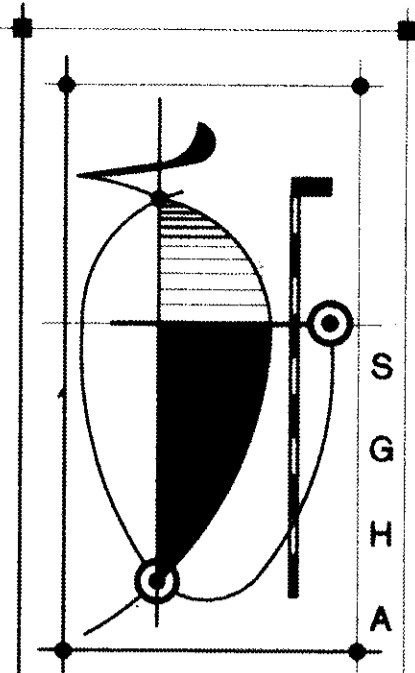

STEPHEN G. HILL
ARCHITECT
SIXTY SEVEN UNION AVE
MEMPHIS TN 38103
901-529-8117
FAX: 901-523-0135
CELL 901-301-2874
shill1@midssouth.rr.com

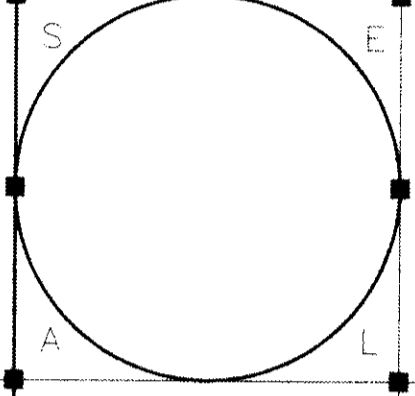


HOUSTON LEEVE TRAILS
APARTMENTS
SHELBY COUNTY, TENNESSEE

REVISIONS	
△	REVISION NO. 1 11-23-99
△	REVISION NO. 2 1-7-00

ROOF PLANS
BUILDINGS "A", "B"
AND CLUBHOUSE

DRAWN SCH
CHECKED SCH
DATE 9-28-99

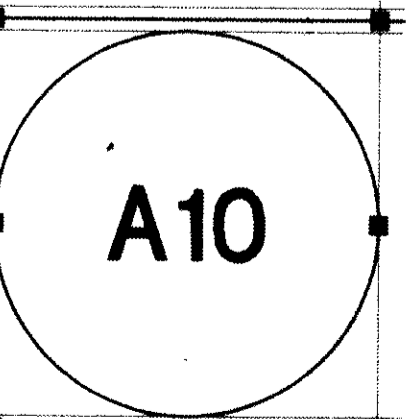

99105.13
© 1999 STEPHEN G. HILL ARCHITECT