



SECTION ELEVATION


4 PENETRATION FIRE STOP DETAIL
SCALE: 3" = 1'-0"

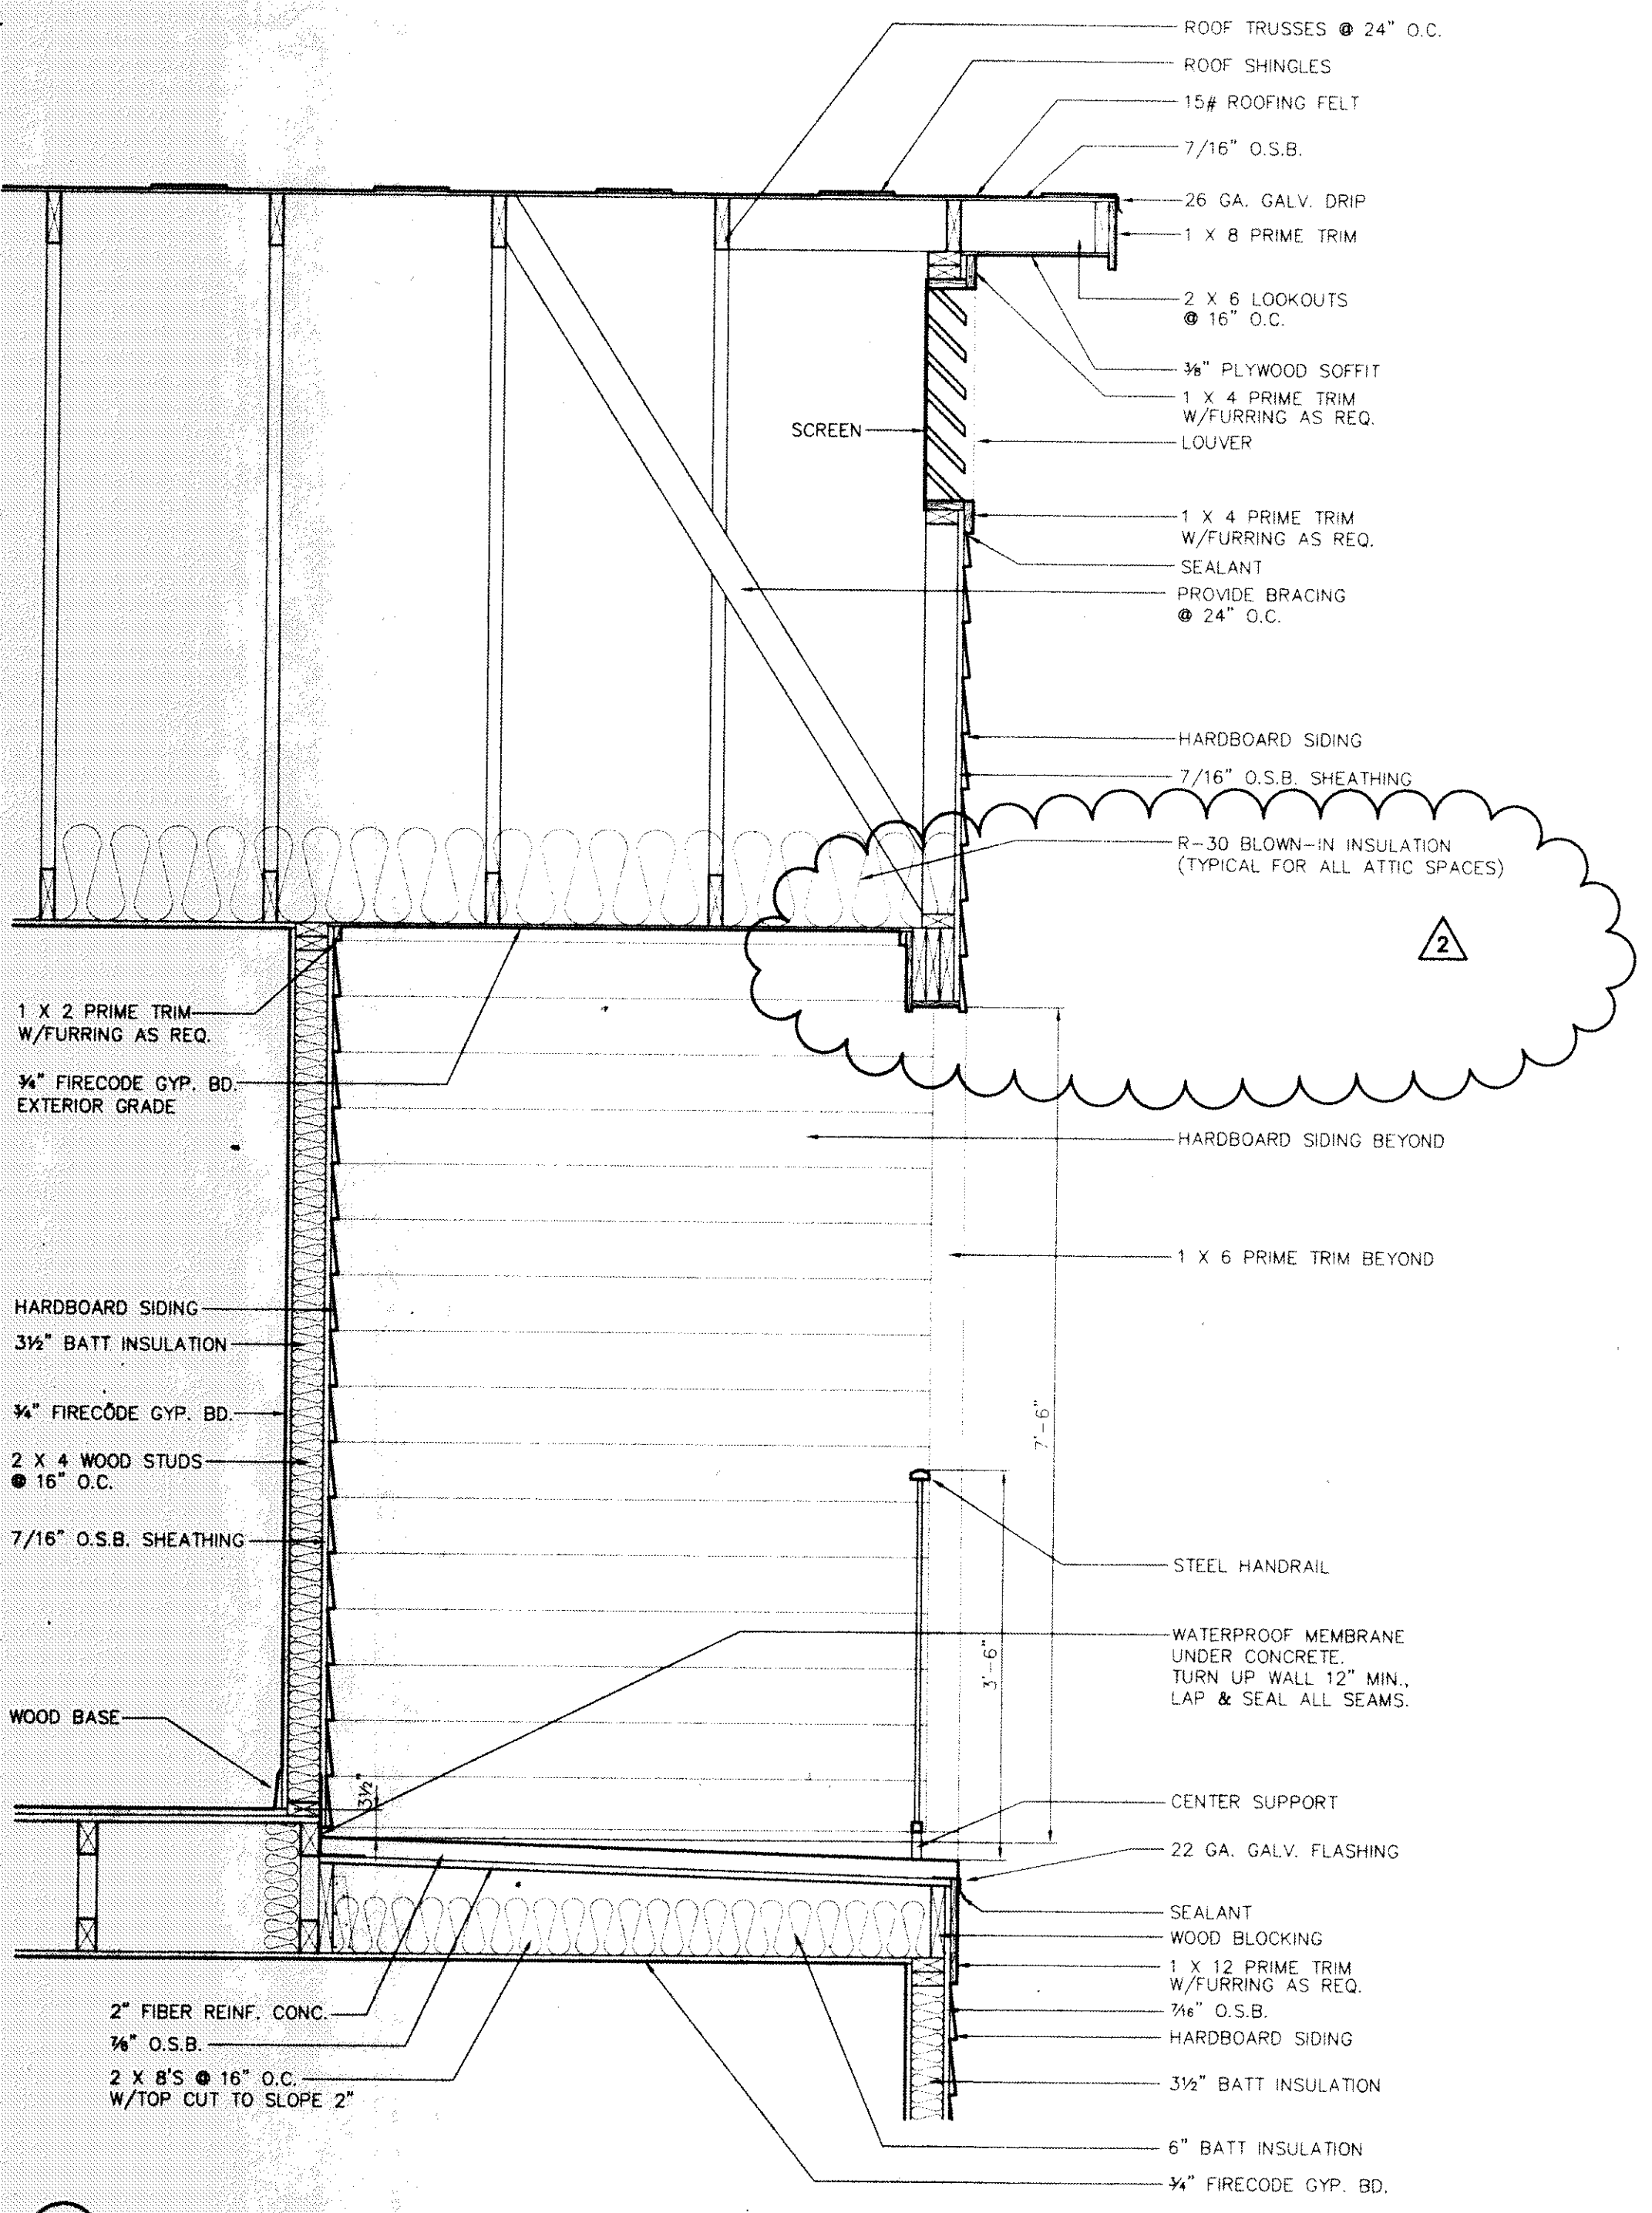


1 WALL SECTION AT THIRD FLOOR DECK
SCALE: 3/4" = 1'-0"

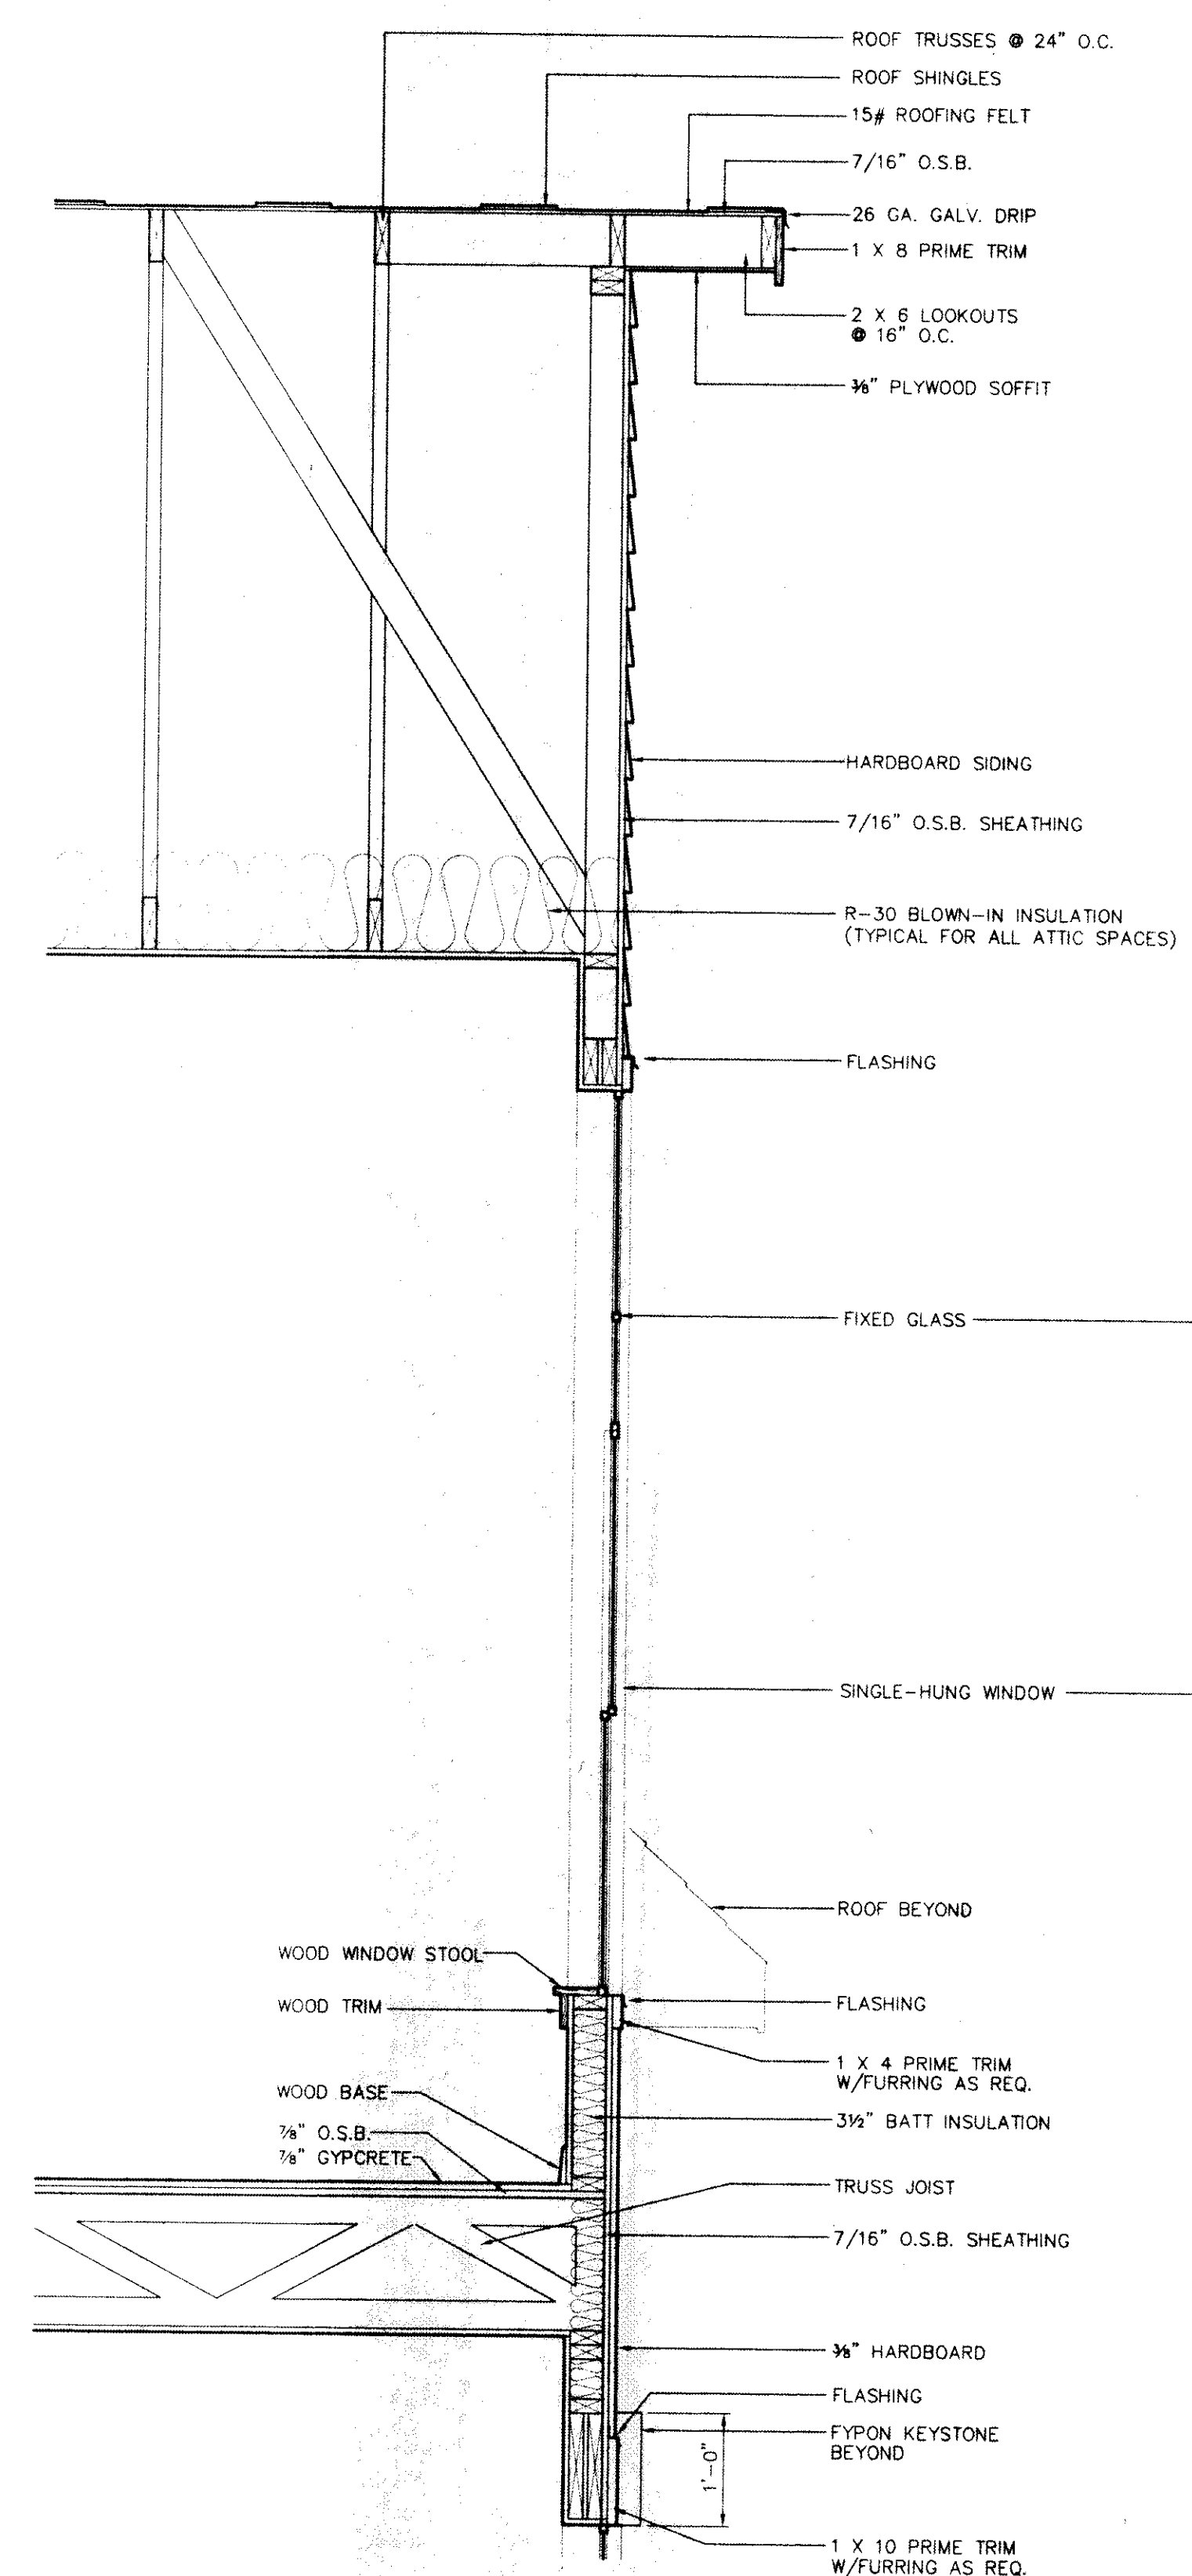


2 WALL SECTION AT THIRD FLOOR LIVING
SCALE: 3/4" = 1'-0"

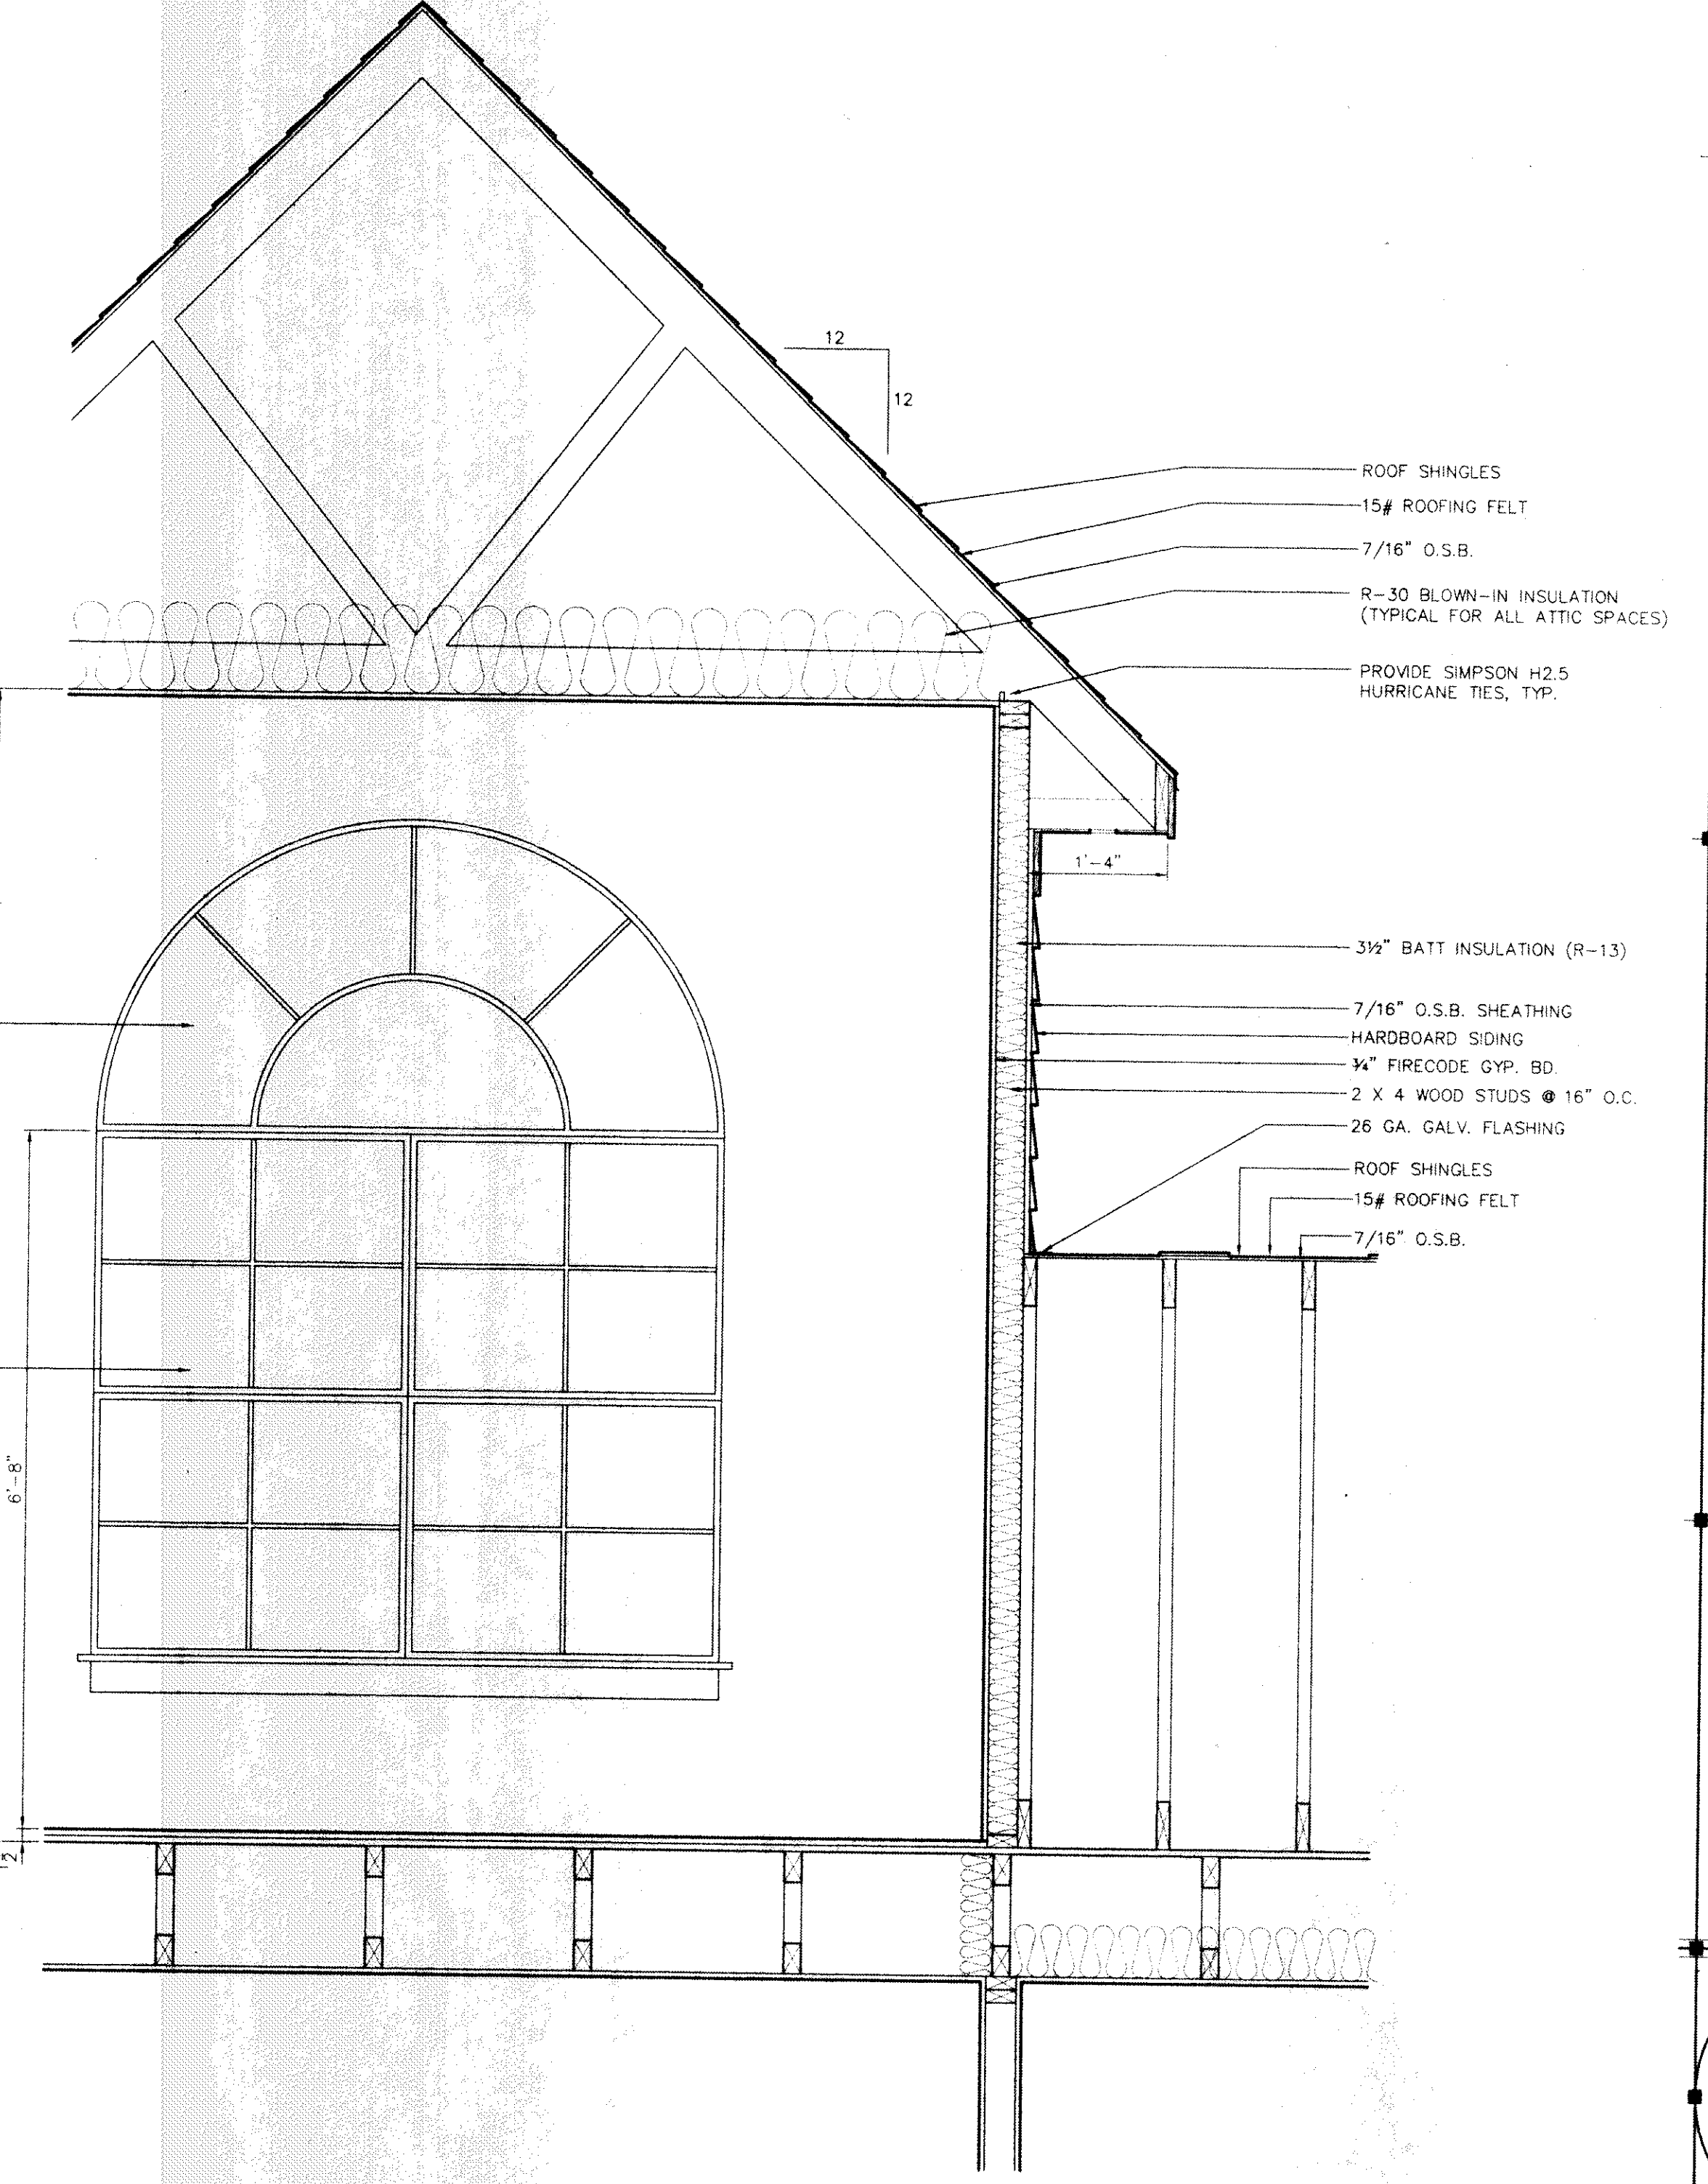

3 WALL SECTION AT THIRD FLOOR LIVING
SCALE: 3/4" = 1'-0"

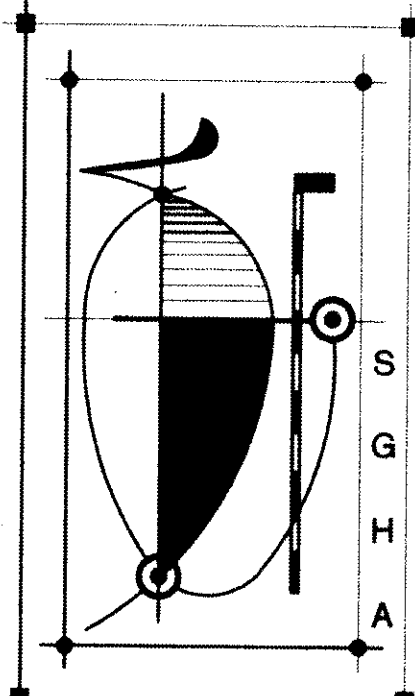

STEPHEN G. HILL
ARCHITECT
SIXTY SEVEN UNION AVE
MEMPHIS TN 38103
901-529-8117
FAX: 901-523-0135
CELL 901-301-2874
shill1@midssouth.rr.com

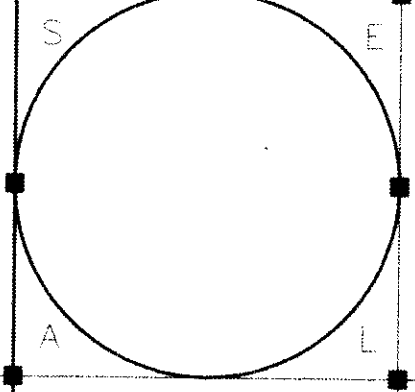


HOUSTON LEEVE TRAILS
APARTMENTS
SHELBY COUNTY, TENNESSEE

REVISIONS
REVISION NO. 2 1-7-99

WALL SECTIONS
BUILDINGS 'A' AND 'B'

DRAWN SGH
CHECKED SGH
DATE 9-28-99

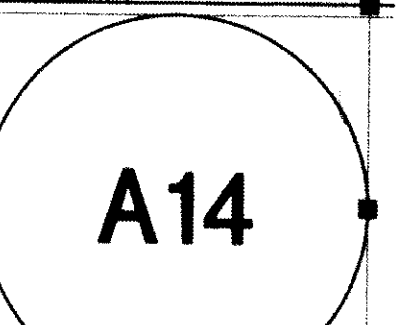

99105.13
© 1999 STEPHEN G. HILL ARCHITECT