OPENING SCHEDULE		
Mark	Size	Description
1	3'-0"x6'-8"x1 3/4"	6 Panel colonial / Wood
2	2'-6"x6'-8"x1 3/8"	Lauh, Flush
3	2'-0"x6'-8"x1 3/8"	Lauh, Flush
4	5'-0"x6'-8"x1 1/8"	Louvered, Folding
5	5'-0"x6'-8"	Aluminum Sliding, Tempered Glass
6	2'-0"x6'-8"x1 1/8"	Louvered, Folding
7	5'-0"x6'-8"	Closed opening

WINDOWS		
Mark	Size	Description
A	3'-0"x4'-0"	Aluminum Slider
B	4'-0"x3'-0"	Aluminum Slider
C	5'-0"x4'-0"	Aluminum Slider

ELEC. SCHEDULE

- Incandescent fixture, surface mounted.
- Incandescent fixture, wall mounted.
- Wall switch - up 54", unless noted otherwise.
- Wall Switch - up 54" with pilot light.
- Three-way switch - up 54", unless noted otherwise.
- Duplex receptacle - up 12".
- WP Duplex receptacle - weather-proof- 18" up
- GFI Ground fault Interrupter, Duplex Receptacle
- Telephone wall outlet, up 12".
- Smoke detectors
- Cable TV outlet
- Heater, Vent, Light
- Door Chime
- Door Chime push button

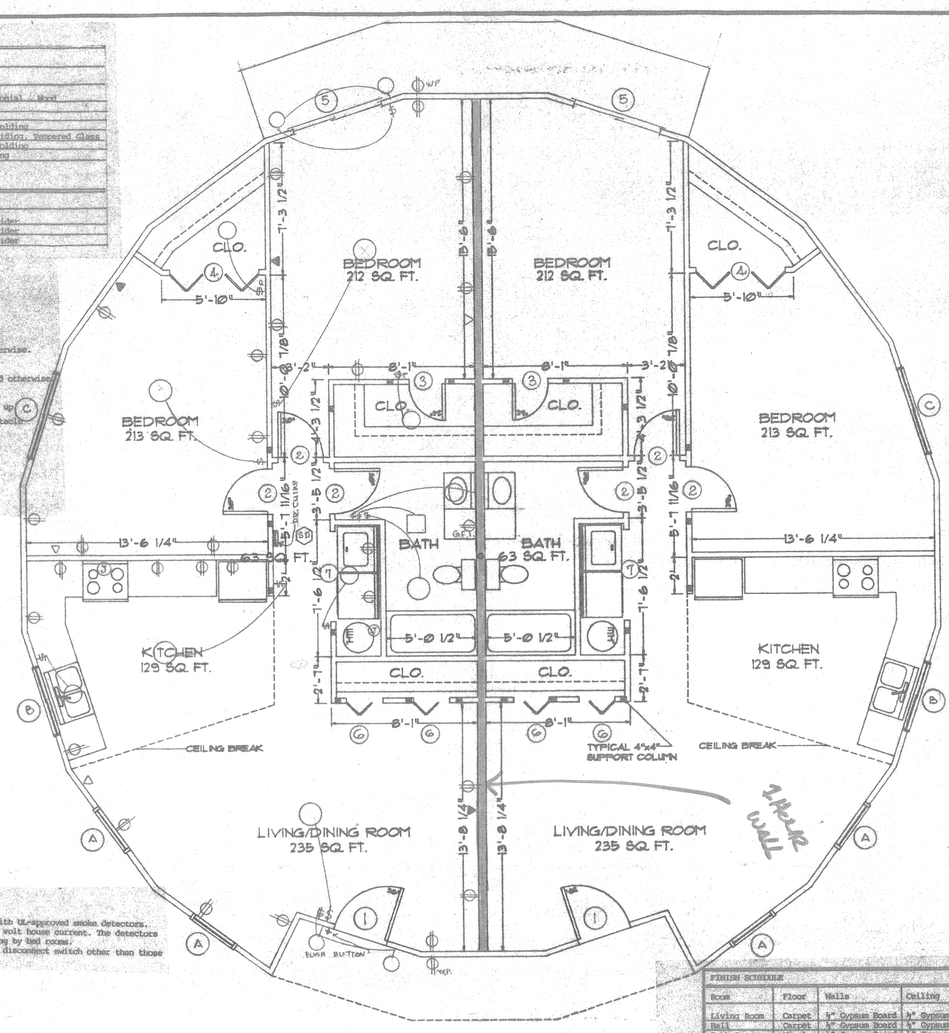

TYPICAL ELEC. LAYOUT
ALL UNITS

SMOKE DETECTORS

All sleeping areas shall be protected with UL-approved smoke detectors. All detectors shall be wired to the 110 volt house current. The detectors shall be installed on the wall or ceiling by bed rooms. Wiring shall be permanent and without a disconnect switch other than those requiring overcurrent protection.

1992 TOTAL SQUARE FEET

"FIRST FLOOR PLAN" SCALE 1/4" = 1'-0"

FINISH SCHEDULE					
Room	Floor	Walls	Ceiling	Base	Remarks
Living Room	Carpet	5/8" Gypsum Board	5/8" Gypsum Board	Wood	
Hall	Carpet	5/8" Gypsum Board	5/8" Gypsum Board	Wood	
Bath Rooms	Vinyl	5/8" Gypsum Board	5/8" Gypsum Board	Wood	
Kitchen	Vinyl	5/8" Gypsum Board	5/8" Gypsum Board	Wood	
Bed Rooms	Carpet	5/8" Gypsum Board	5/8" Gypsum Board	Wood	

All closets shall be finished same as adjacent room.

JEM

SCALE: 1/4" = 1'0"
DATE: 05-10-96

MODEL: M4000
DRAWING TYPE: LOWER LEVEL
SAPP, FELIX

19015.02

Eagle Vista Homes

SUPPORT COLUMN SCHEDULE
"A" = 11'-9 1/4"
"B" = 13'-0 9/16"
"C" = 11'-6 9/16"
"D" = 10'-9 7/8"
"E" = 9'-9 1/8"
"F" = 9'-2"
"G" = 11'-2 3/4"
"H" = 8'-10 15/16"
"I" = 8'-0 1/2"

NOTE: ALL DIMENSIONS ARE FROM CENTER POINT TO MID-POINT OF SUPPORT COLUMN.

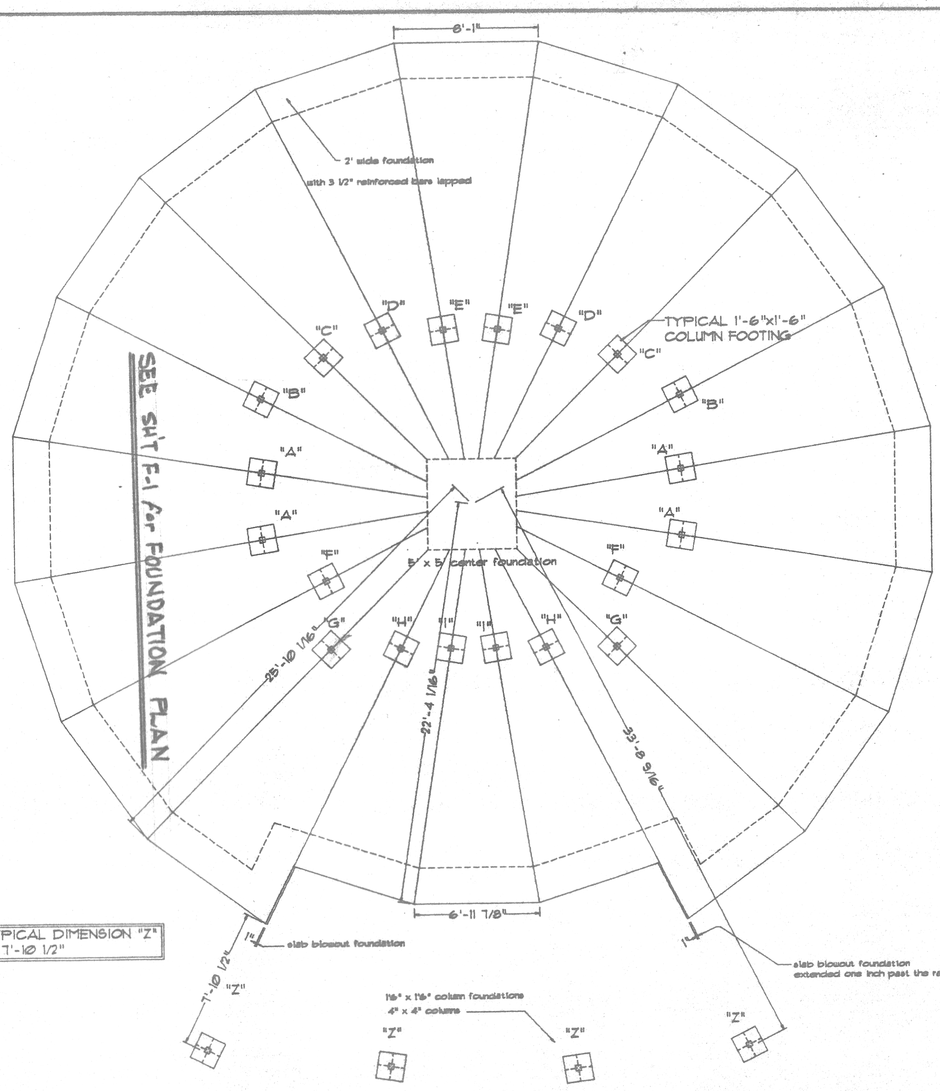

SEE SH'T F-1 for FOUNDATION PLAN

TYPICAL DIMENSION "Z" IS 7'-10 1/2"

REGISTERED FOR STRUCTURAL ASPECTS ONLY BY DONALD MATHIS

JEM

SCALE: 1/4" = 1'0"
DATE: 05-10-96

MODEL: M4000
DRAWING TYPE: FOUNDATION
SAPP, FELIX

19015.02

Eagle Vista Homes

DRAWN	
CHECKED	J.C. FRANTZ
DATE	June 24, 1996
SCALE	1/4" = 1'0"
JOB NO.	95-150
SHT. NO.	1 of 9

J. C. FRANTZ, ARCHITECT

CERTIFICATION

N.C.A.R.B. 8026 - LOUISIANA 1022 - MISSISSIPPI 733