


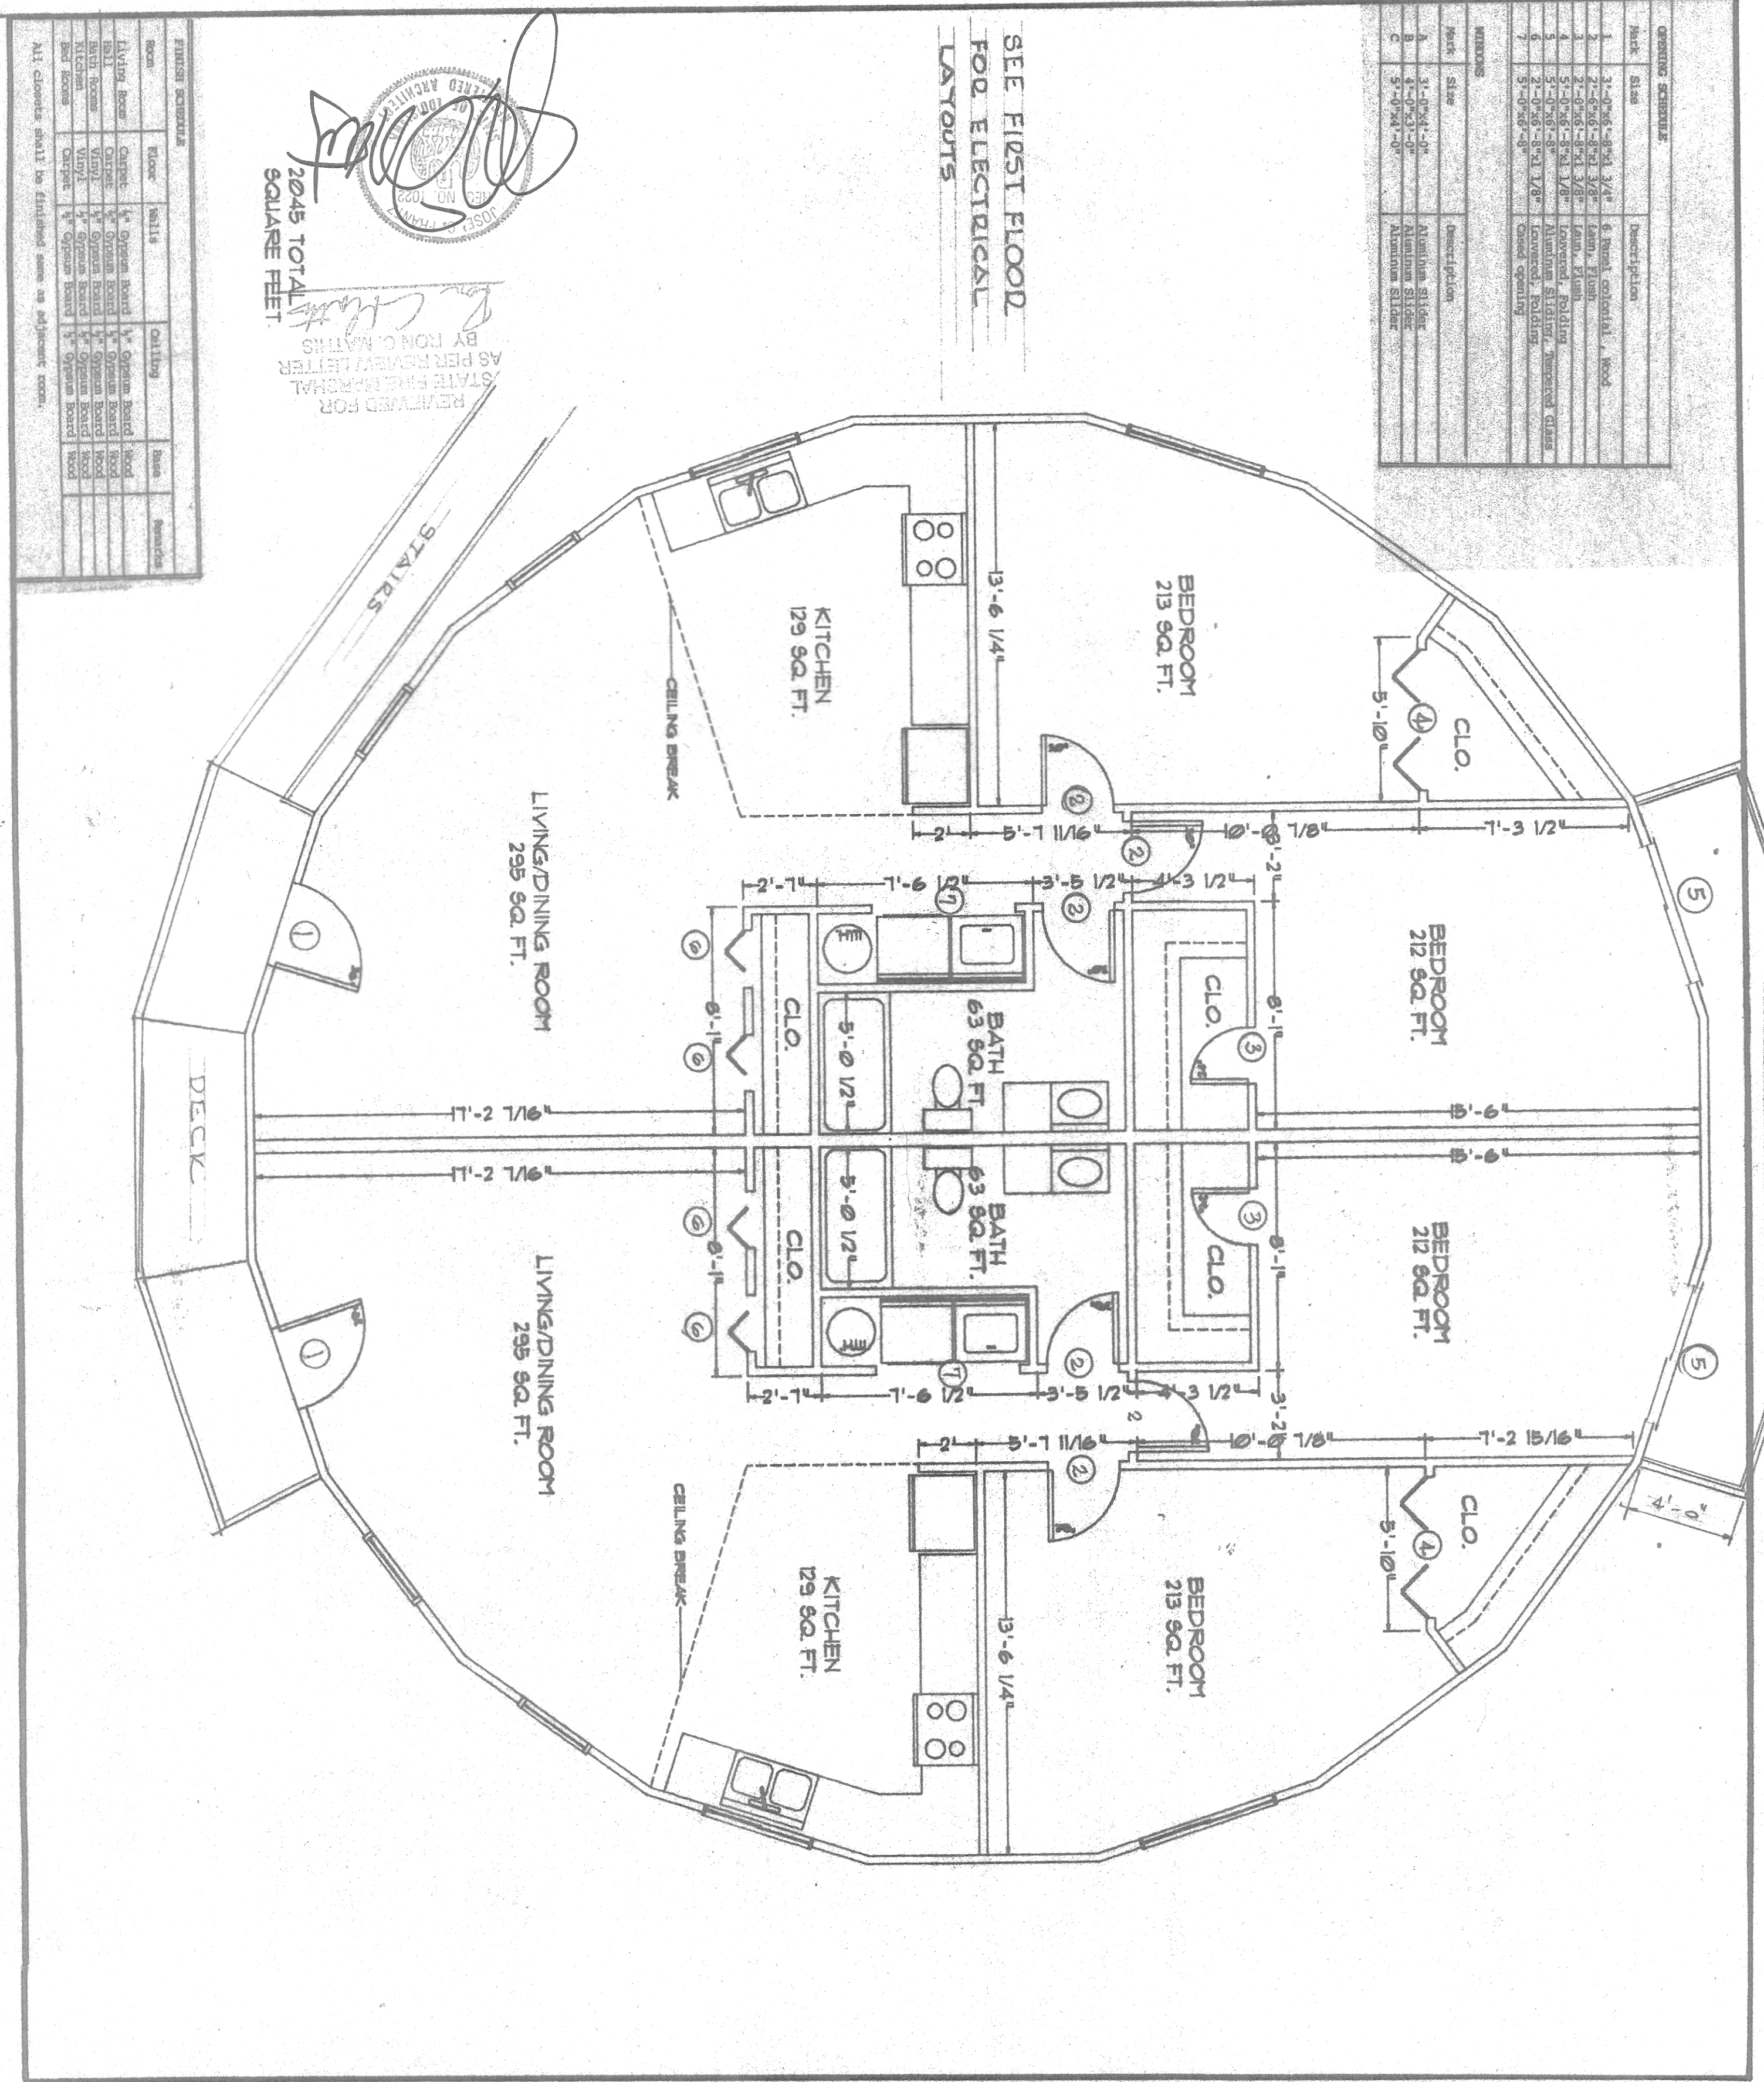








J. C. FRANTZ, ARCHITECT

CERTIFICATION

N.C.A.R.B. 9026 - LOUISIANA 1022 - MISSISSIPPI 733

DATE	10/14/96
CHECKED	J. Frantz
DRAWN	J. Frantz
SCALE	1/4" = 1'-0"
JOB NO.	902186
SHEET	4 of 9