2 - Amber/Taylor Trail
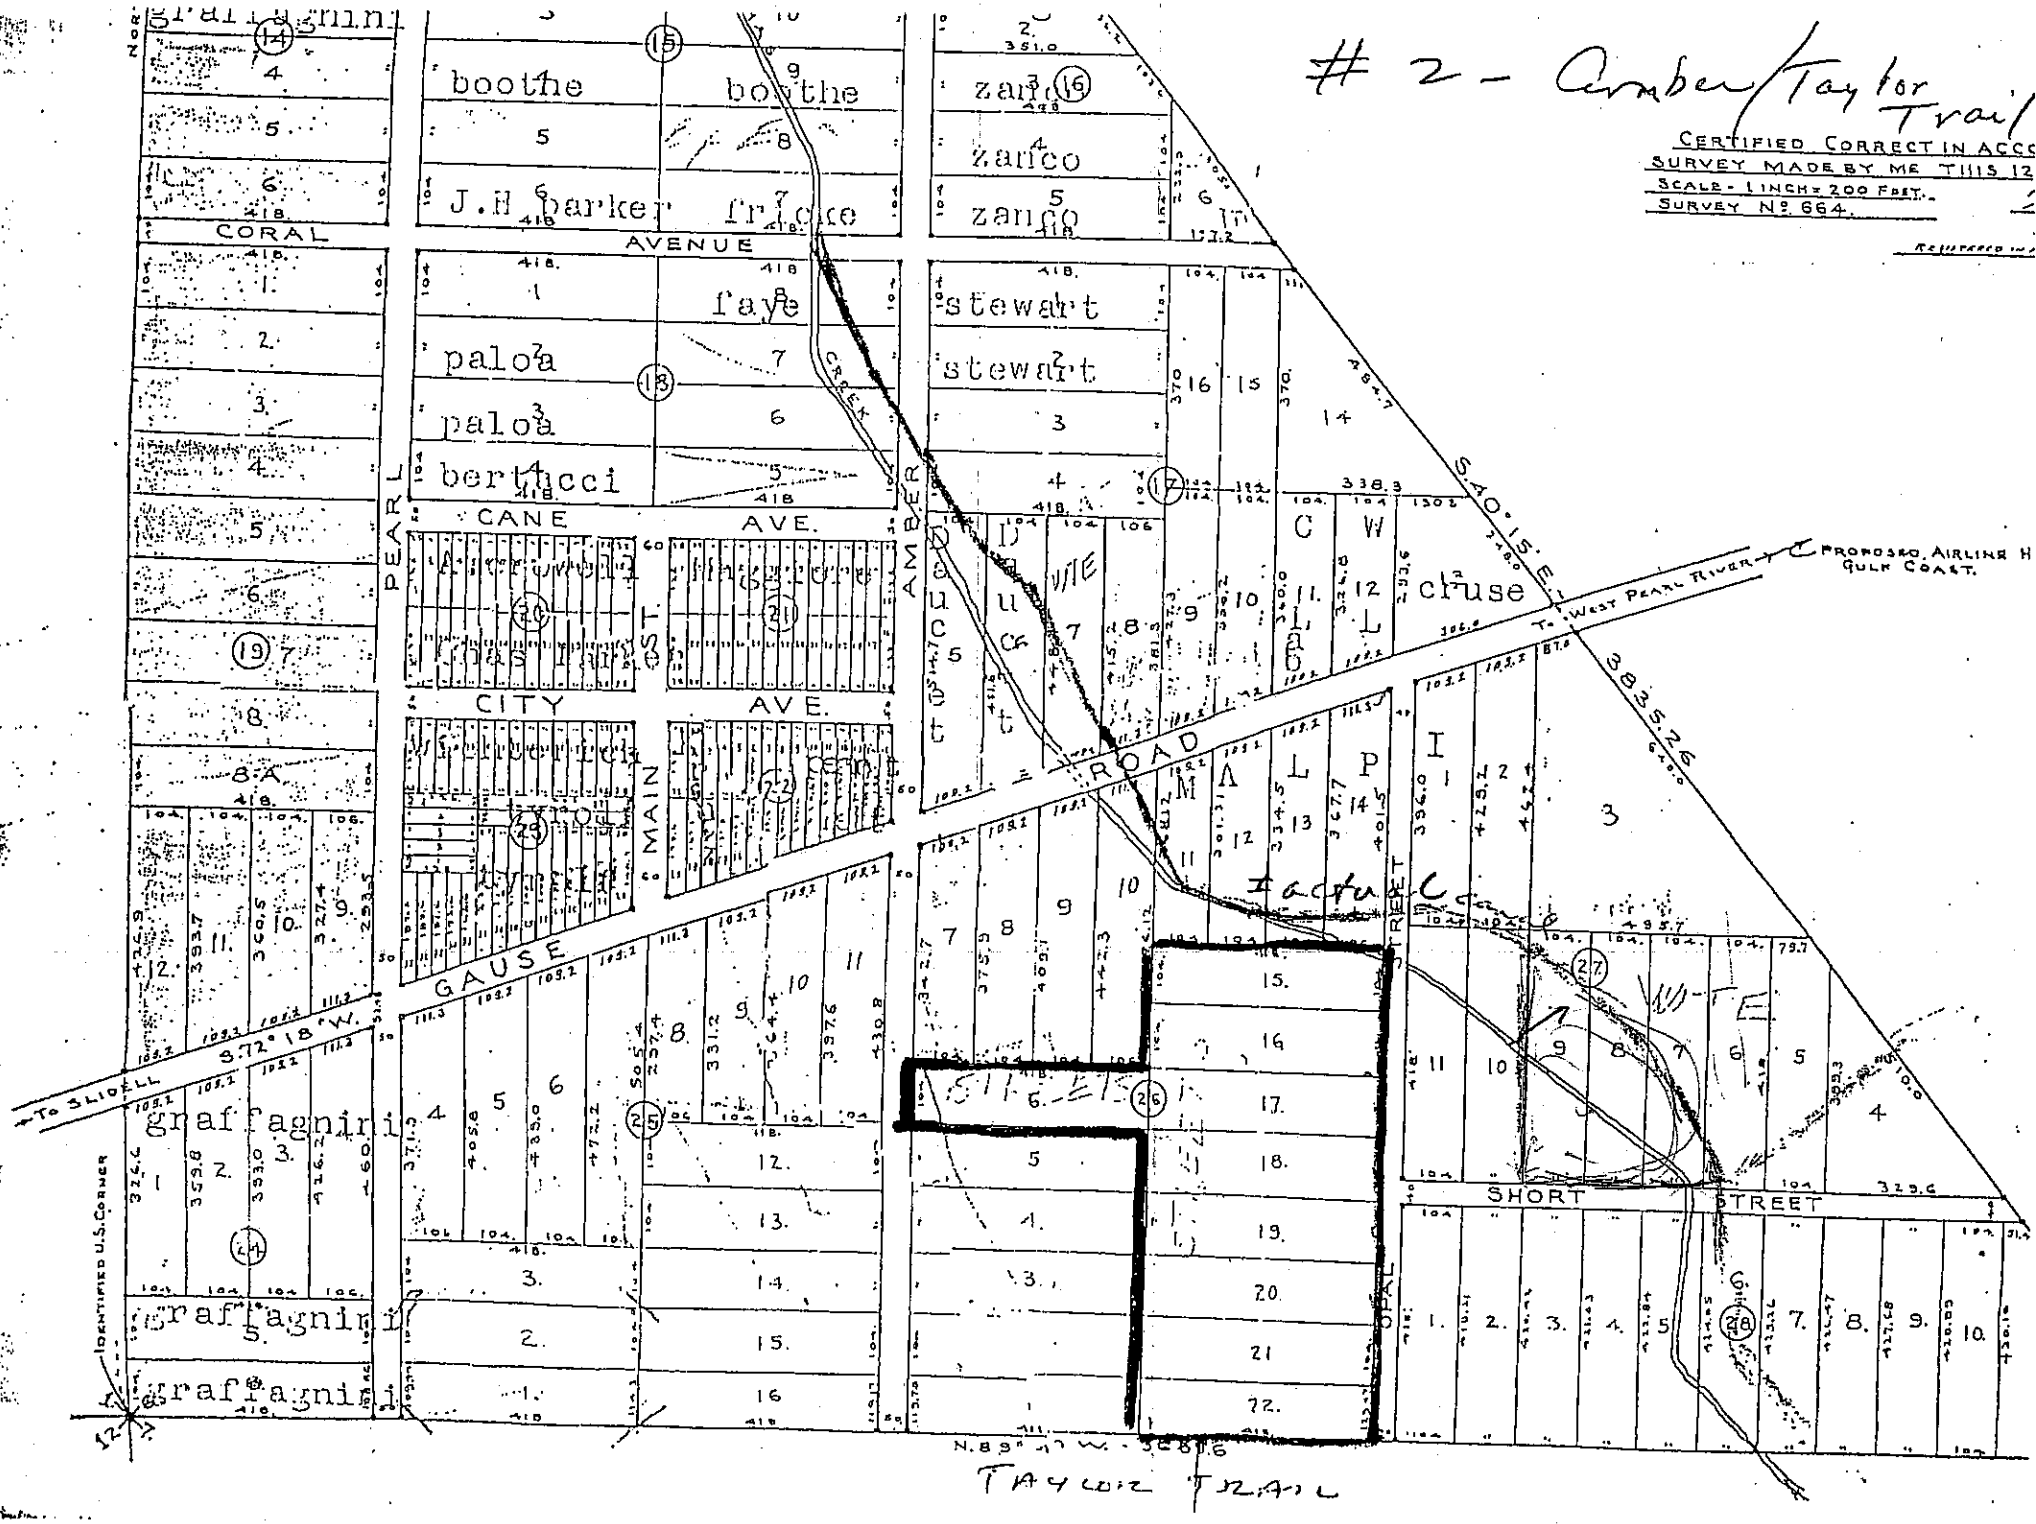
CERTIFIED CORRECT IN ACCO
SURVEY MADE BY ME THIS 12
SCALE - 1 INCH = 200 FEET.
SURVEY No. 664.