



*This is from the classroom
We need to rd your security
such to adjust for the hallway.*

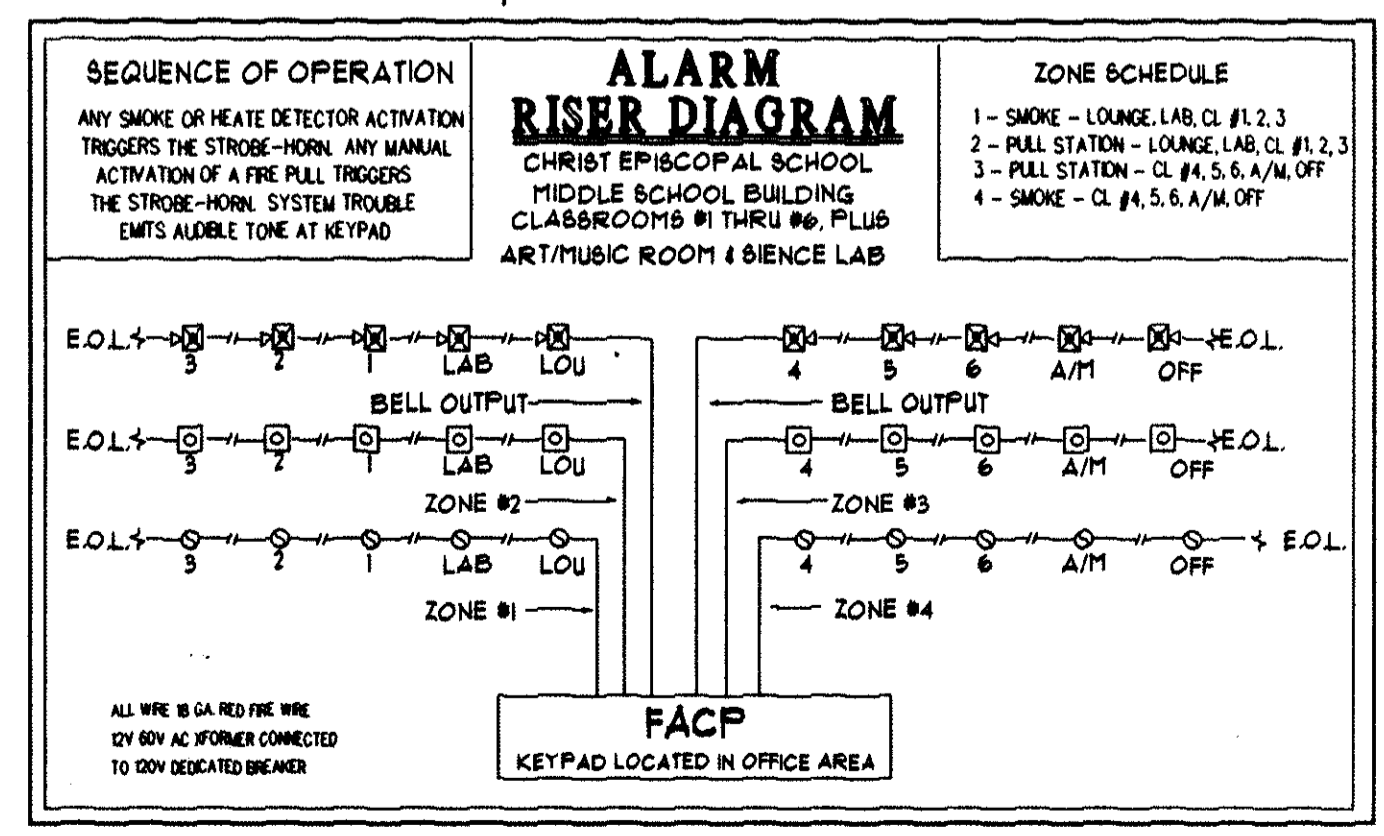

ALARM SYSTEM TYPICAL TO EACH CLASSROOM - SMOKE DETECTOR VISUAL & AUDIBLE ALARM & FIRE PULL STATION @ EACH DOOR PLUS EMER. LT.

DON MC MATH CONSTRUCTION
2990 GAUSE BLVD EAST
LOUISIANA
SL IDELL
504-641-4070

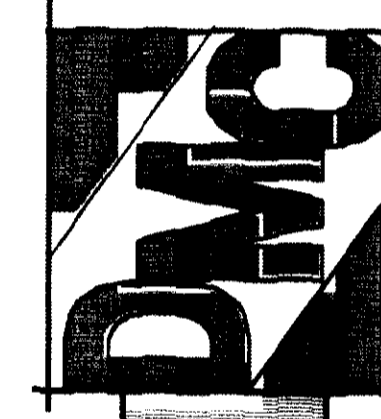

**CHRIST EPISCOPAL SCHOOL
GYM EXPANSION**
LA HWY #21 & CHRISTWOOD BLVD
COVINGTON, LOUISIANA

SQUARE FOOTAGE	
AREAS OF EXPANSION	
- RIGHT EXPANSION	2,496
- LEFT EXPANSION	2,496
- REAR EXPANSION	1,820
TOTAL EXPANSION	6,812

DATE: 1 APRIL 00

JOB NO. 00-18

SHEET

10

OF SHEETS