
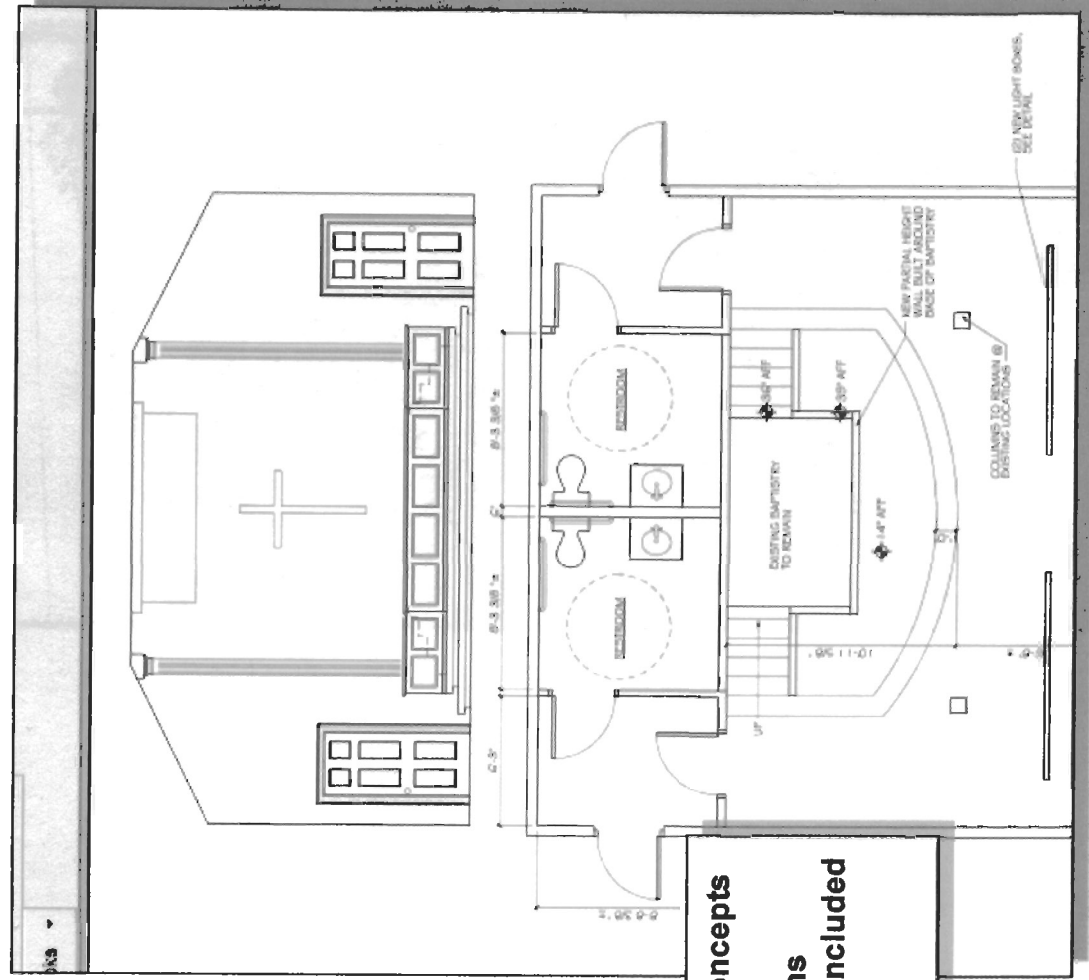


Old Edifice New Functionality – Multi-Purpose Facility

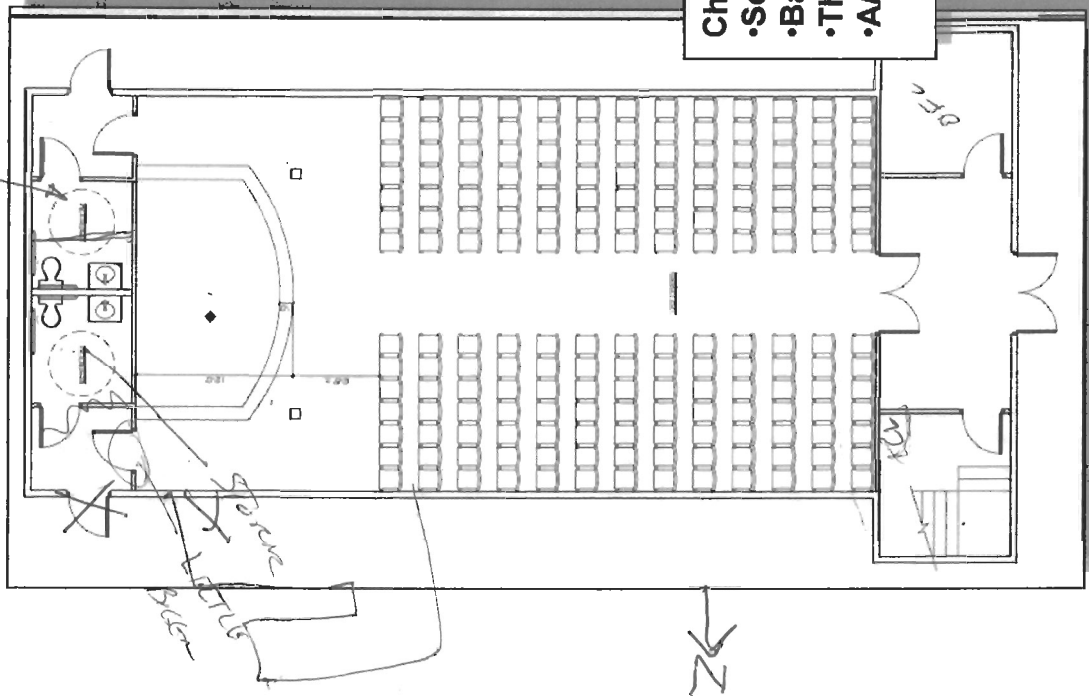

- Church Interior Concepts**
- Seats 182
 - Baptismal Remains
 - Theatre Lighting Included
 - AV Package