

17' Peak Stucco front  
14' eave  
no overhangs

**GA FILE NO. WP 4136 GENERIC**

BASE LAYER 5/8" TYPE X GYPSUM WALLBOARD OR VENEER BASE APPLIED PARALLEL OR AT RIGHT ANGLES TO EACH SIDE OF 2" X 4" WOOD STUDS 16" O.C. WITH 1 1/4" TYPE W DRYWALL SCREWS 12" O.C. FACE LAYER 5/8" TYPE X GYPSUM WALLBOARD OR VENEER BASE APPLIED PARALLEL OR AT RIGHT ANGLES TO EACH SIDE WITH 1 7/8" TYPE W DRYWALL SCREWS 12" O.C. AND OFFSET 8" FROM SCREWS IN BASE LAYER.

JOINTS STAGGERED 16" ON OPPOSITE SIDES. (LOAD BEARING)

THICKNESS: 0 1/8"  
 APPROX. WEIGHT: 12 PSF  
 FIRE TEST: SMR 01-020-014, 12-04  
 SOUND TEST: SEE WP 3250

2 HOUR FIRE 40 TO 44 STC SOUND

---

**GA FILE NO. WP 3514 GENERIC**

ONE LAYER 5/8" TYPE X GYPSUM WALLBOARD OR GYPSUM VENEER BASE APPLIED PARALLEL OR AT RIGHT ANGLES TO EACH SIDE OF 2" X 4" WOOD STUDS 16" O.C. WITH 1 1/4" TYPE W DRYWALL SCREWS 12" O.C.

JOINTS STAGGERED 16" ON OPPOSITE SIDES. (LOAD BEARING)

THICKNESS: 4-5/16"  
 APPROX. WEIGHT: 7 PSF  
 FIRE TEST: SMR 01-0511-619, 6-19-02  
 SOUND TEST: (GAH NG-2465T, 7-2-05)

1 HOUR FIRE 35 TO 39 STC SOUND




**1st FLOOR AREA BY USE**


2,310 SQ. FT. OFFICE/RESTROOMS/ECT.  
 3,690 SQ. FT. SANCTUARY  
 TOTAL SQ. FT. = 6,000

**1st FLOOR OCCUPANT LOAD**

1. OCCUPANCY CLASSIFICATION PER IBC 2003 (SECTION 303.1) ASSEMBLY GROUP: A-3  
 2. OCCUPANT LOADS ARE CALCULATED PER VALUES GIVEN BY NFPA 101, 2003, TABLE 7.3.1.2  
 100 SQ. FT. KITCHEN SPACE = 1 OCCUPANT  
 REMAINDER OF SANCTUARY SHALL BE CONSIDERED NON-FIXED SEATING (SEE PLAN) ALLOWING FOR 160 OCCUPANTS  
 TOTAL 1ST FLOOR = 308 OCCUPANTS

**CONSTRUCTION NOTES**

SEE SHEET A-3 FOR GENERAL  
 SEE SHEET A-2 FOR 2ND FLOOR STAIRS

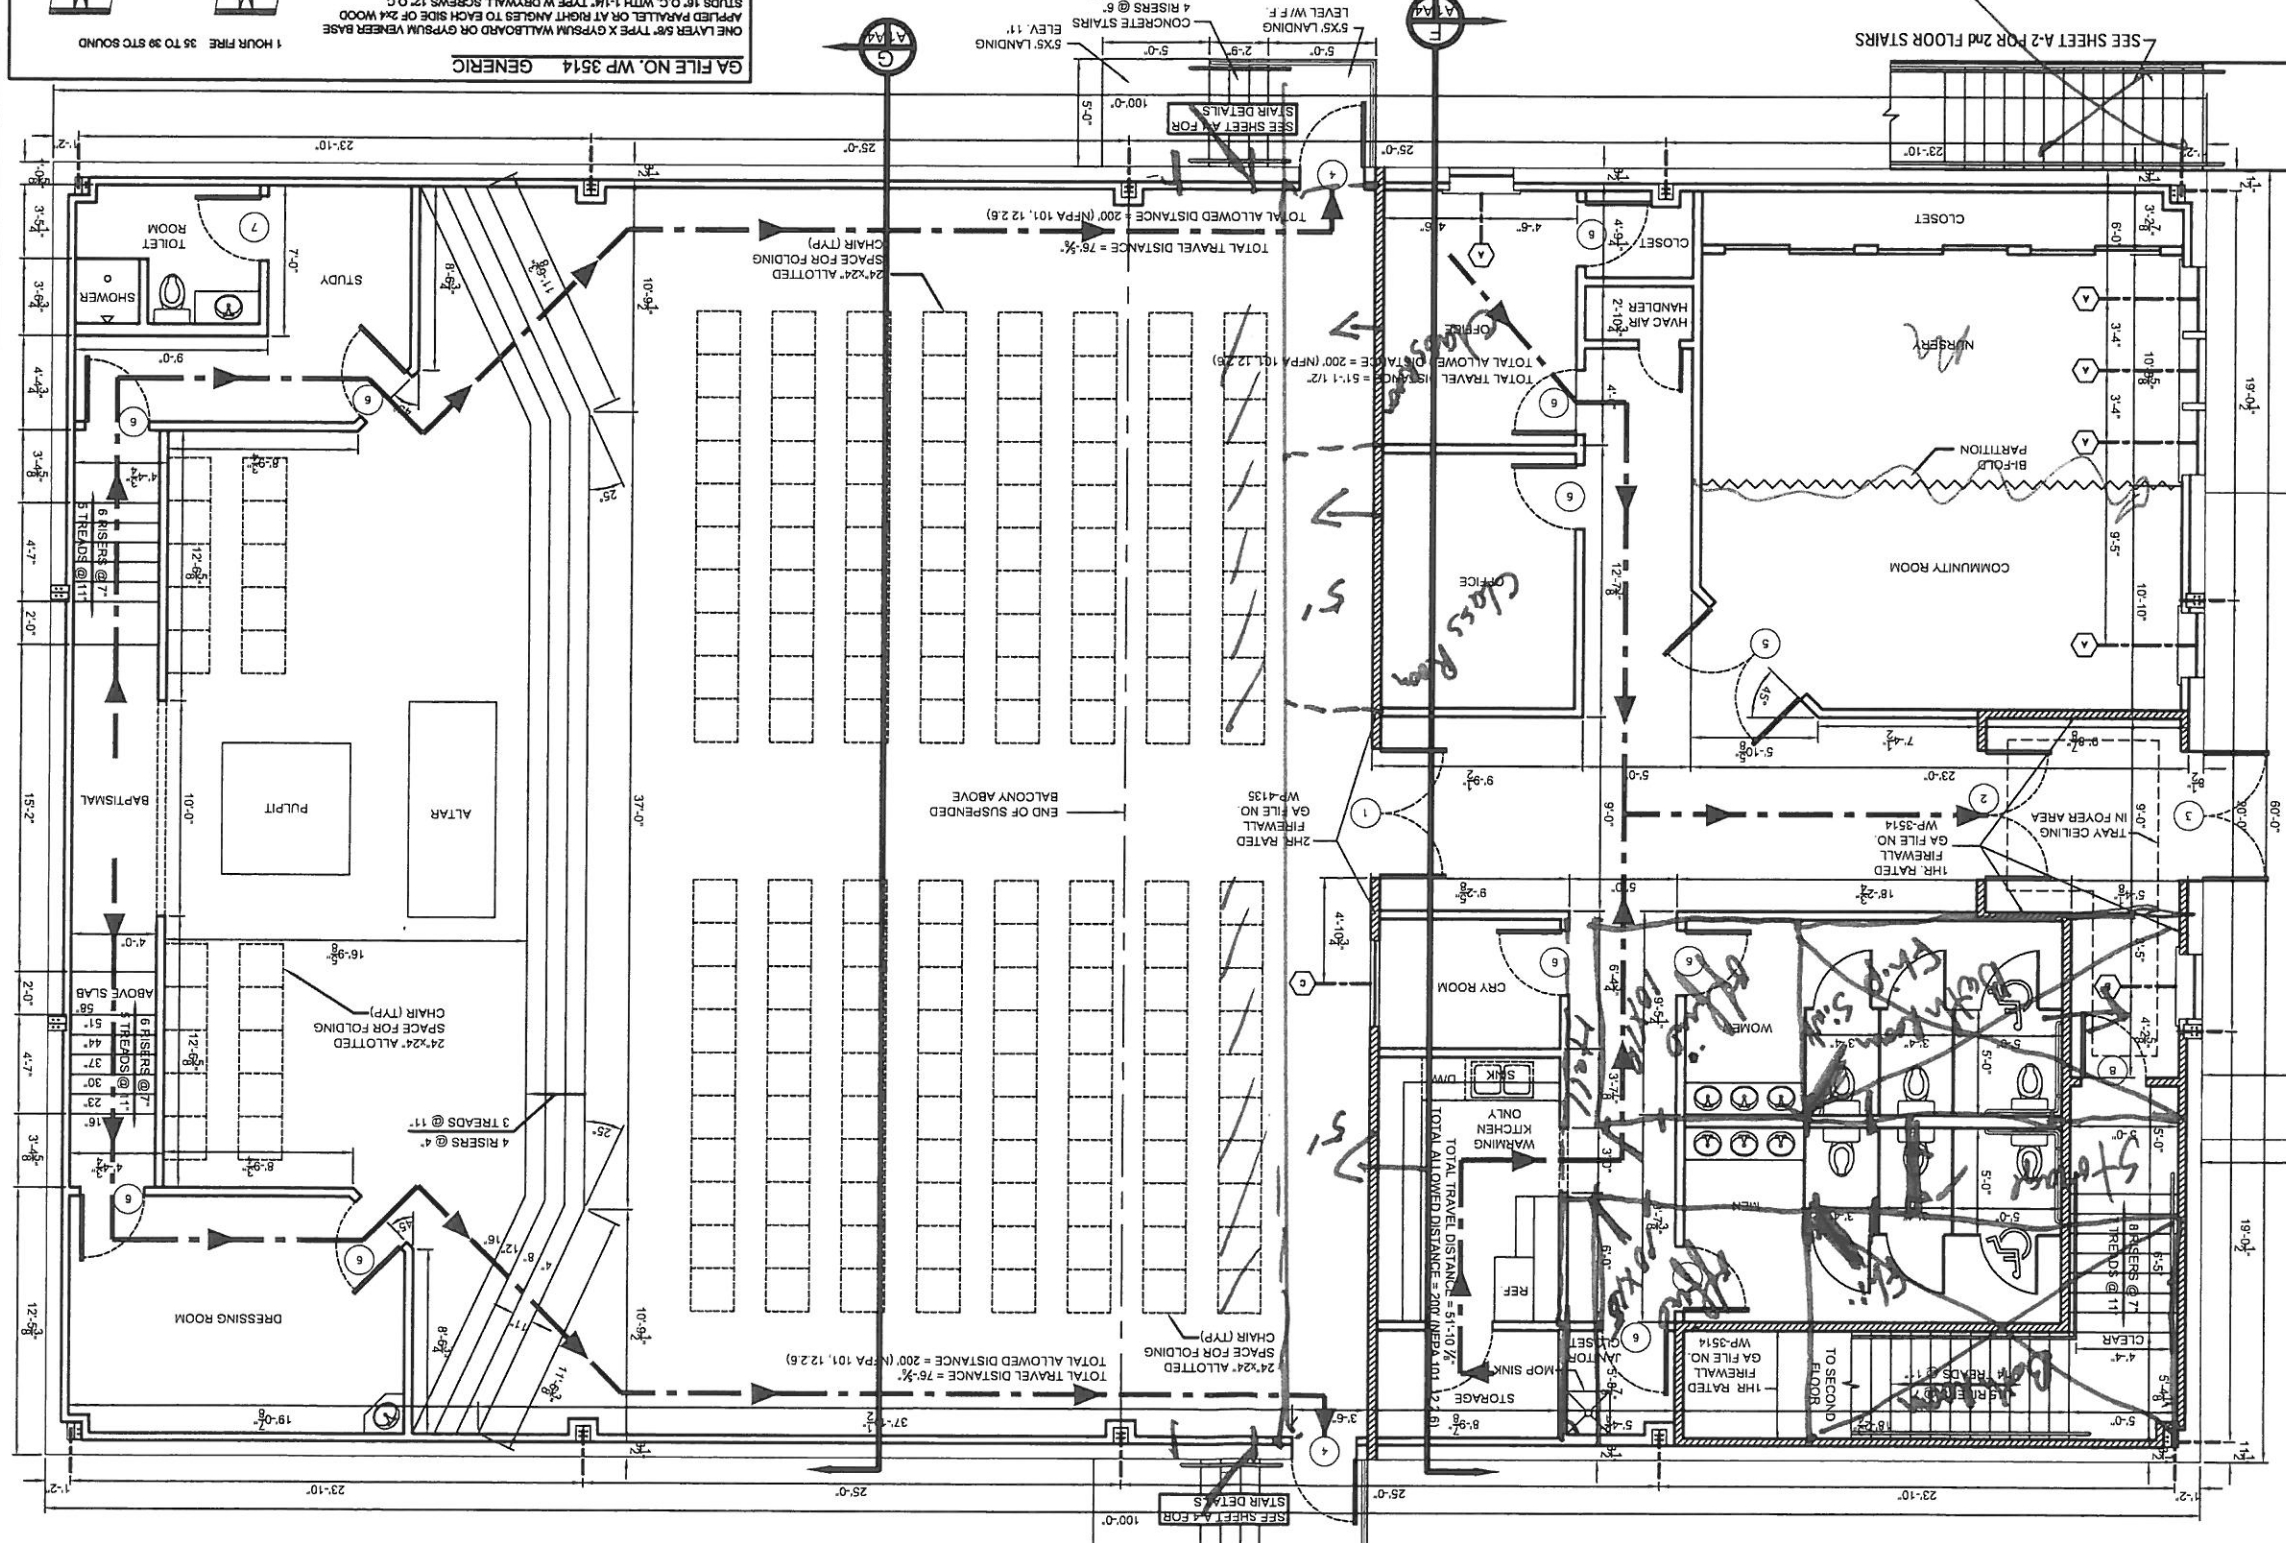

**1st FLOOR PLAN**

SCALE: 1/4"=1'-0"

FRAMING STUD WALLS SHALL BE 16GA. 2X6 STEEL STUDS @ 16" O.C.

LEVEL W/F F

CONCRETE STAIRS

5'X5' LANDING

5'X5' LANDING

ELEV. 11'

SEE SHEET A-2 FOR 2ND FLOOR STAIRS



























**DAMMON**  
ENGINEERING, INC.

CHIEF ENGINEER  
EMMETT  
DAMMON, P.E.


CHIEF ARCHITECT  
ROBERT  
WILTSE

1095 FLORIDA AVENUE  
SLIDELL, LA. 70458  
OFFICE: 985-649-5832  
FAX: 985-641-5950

WEBSITE:  
WWW.DAMMONENGINEERING.COM

EMAIL:  
DAMMONENG@BELLSOUTH.NET

ARCHITECTURE  
ENGINEERING  
STUDIES  
PLANNING  
INVESTIGATION  
EXPERT WITNESS

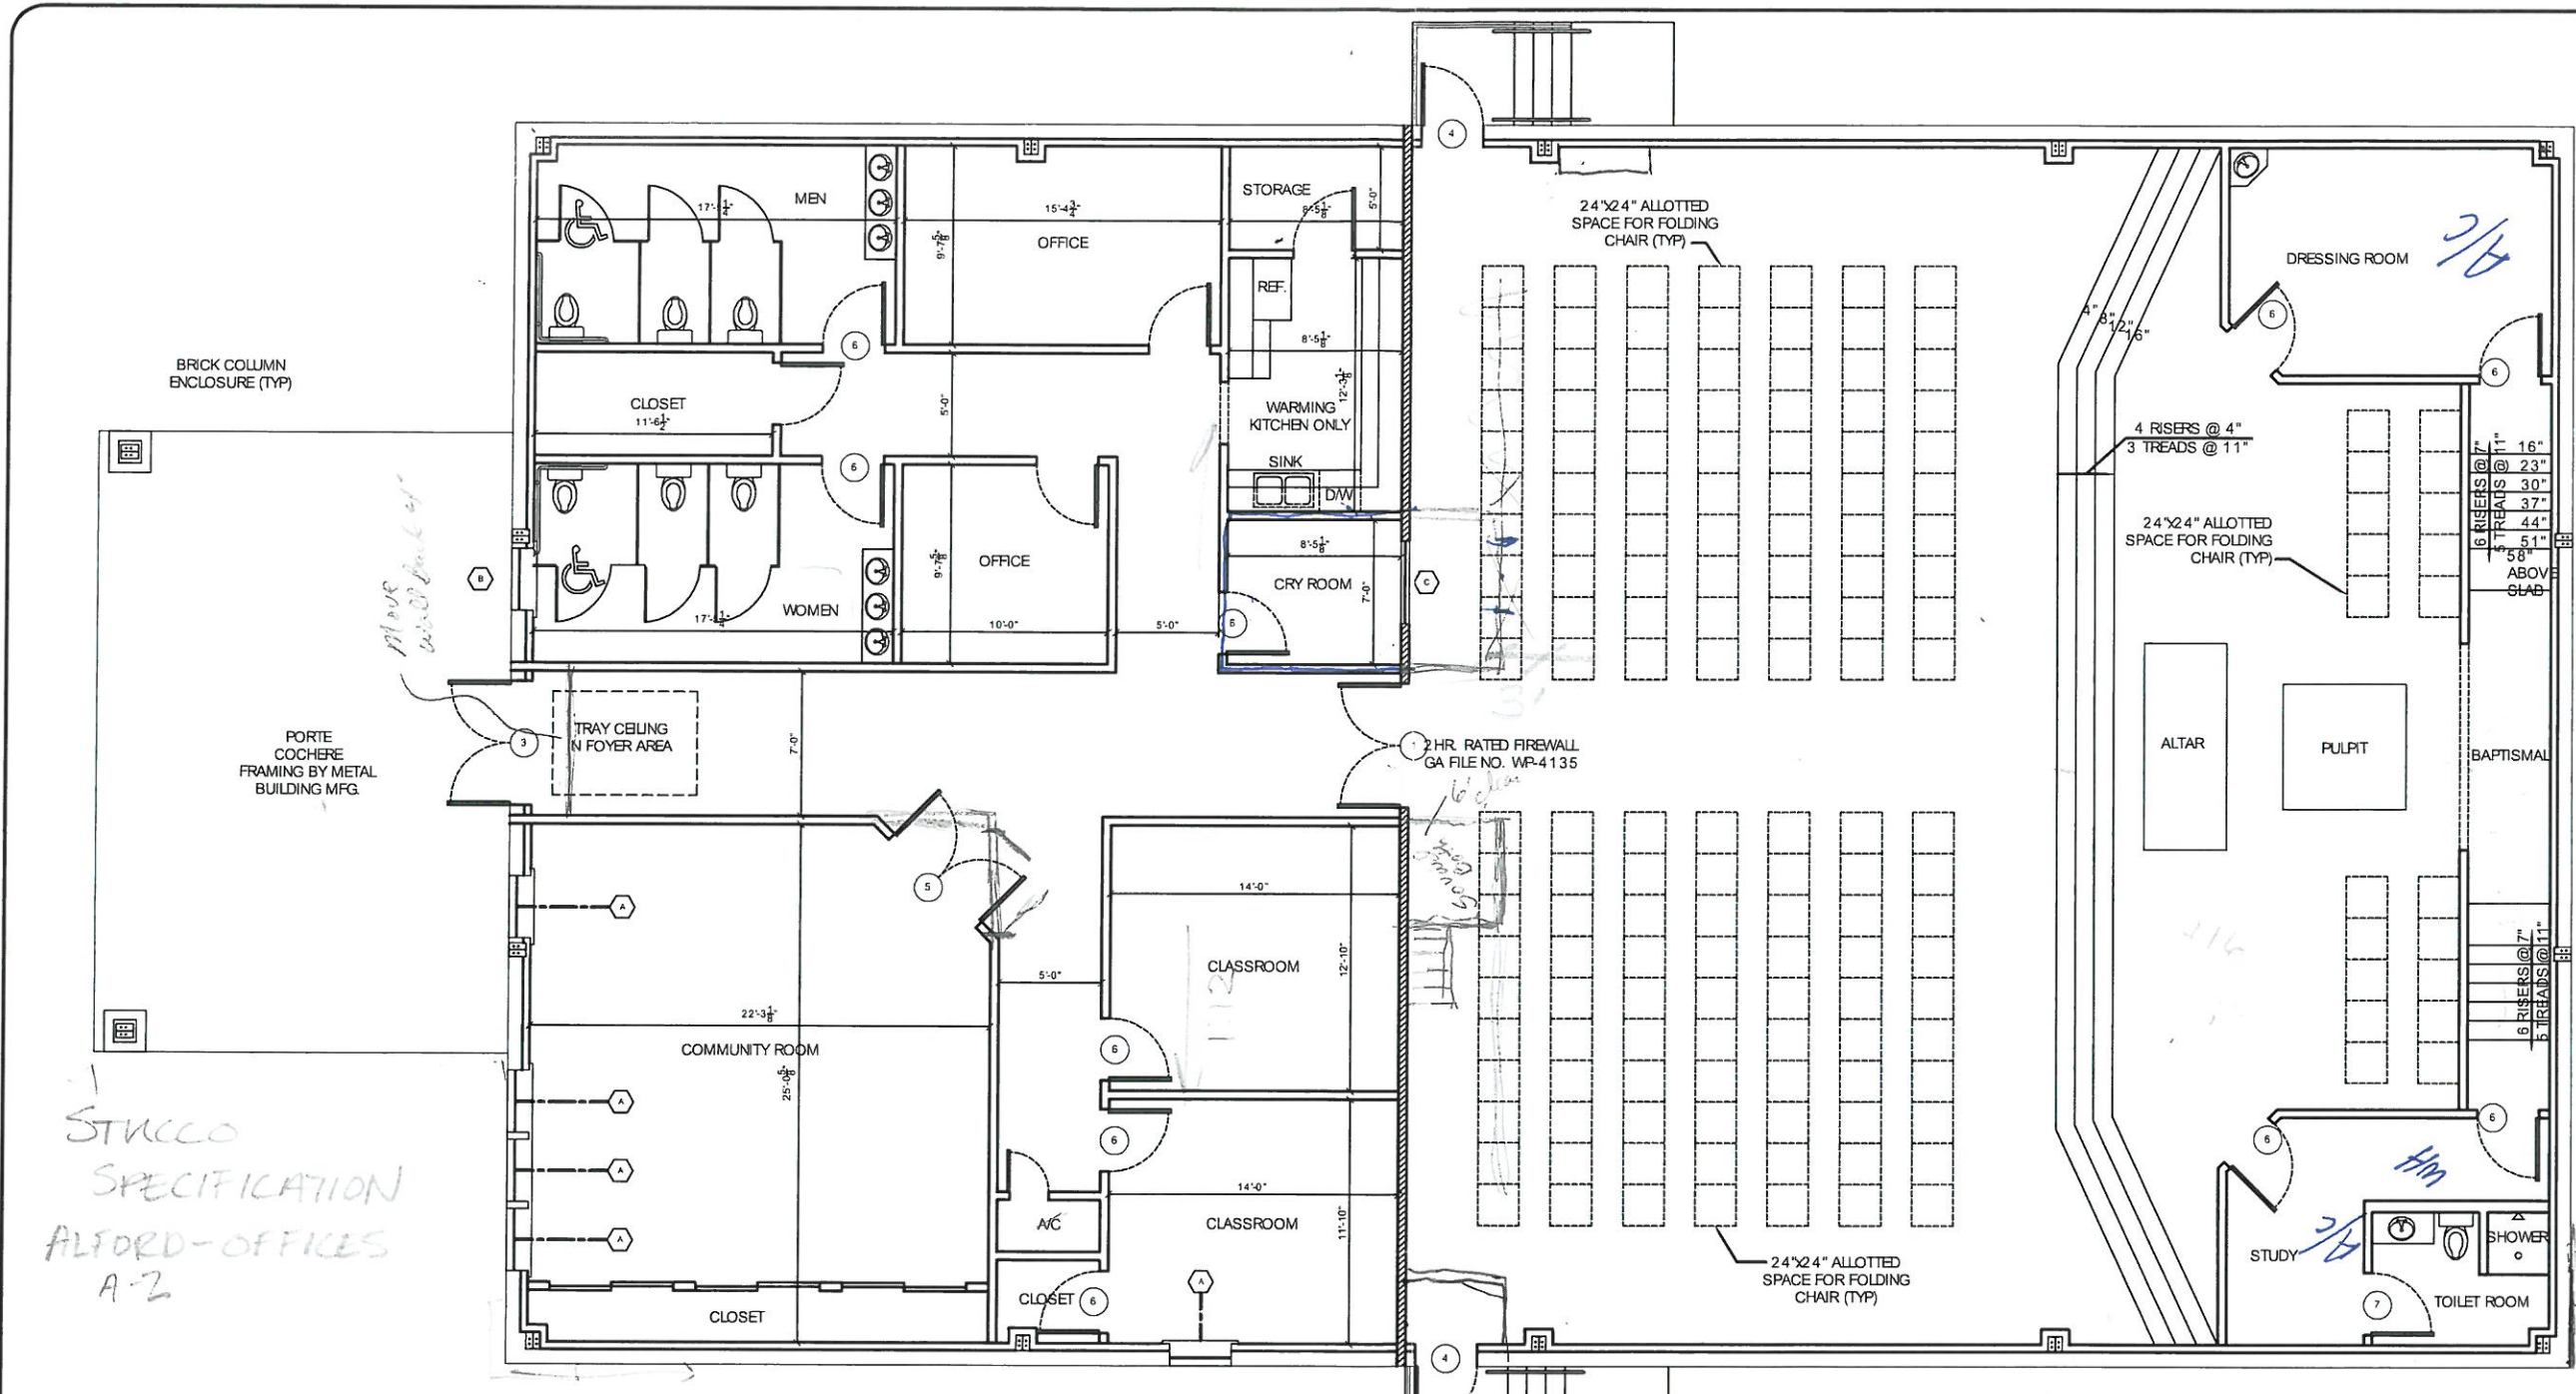

OCCUPANT LOAD CALCULATIONS	
OCCUPANCY CLASSIFICATION PER IBC 2006 (SECTION 304.1)	
MIXED OCCUPANCY: GROUP A-3 (SANCTUARY-CLASSROOMS-COMMON AREAS), GROUP B (OFFICES)	
OCCUPANT LOADS ARE CALCULATED PER VALUES GIVEN BY NFPA 101, 2006, TABLE 7.3.1.2	
TOTAL BUILDING FOOTPRINT =	6,000 s.f.
SANCTUARY: 2,890 NET s.f. / 15 s.f. =	188 OCCUPANTS
FELLOWSHIP HALL = 1,486 NET s.f. / 15 s.f. =	99 OCCUPANTS
KITCHEN = 108 s.f. / 100 s.f. =	1 OCCUPANT
OFFICES = 278 s.f. / 100 s.f. =	3 OCCUPANTS
TOTAL BUILDING OCCUPANT LOAD =	291

FLOOR PLAN  
SCALE: 1/4" = 1'-0"

REV:  
SCALE: AS NOTED  
JOB#:  
DATE: XX-XX-08  
SHEET

A-1

OF