

1 HR WALL, 10' EA SIDE OF EXIT OPENING, TYPICAL. EA 2ND FLOOR EXIT - FROM GROUND. TO 22' ABOVE GROUND. GA FILE # WP 9060.


1 HR RATED HALLWAY GA FILE # WP 1072

1 HR WALL, 10' EA SIDE OF EXIT OPENING, TYPICAL. EA 2ND FLOOR EXIT - FROM GROUND. TO 22' ABOVE GROUND. GA FILE # WP 9060.

ONE HOUR WALL TO UNDERSIDE OF ROOF GA FILE # WP 8005 SEE DETAIL SHT. A-5

LEGEND  
1 HR RATED - [Hatched Pattern]

REVISED CLASS ROOM 201

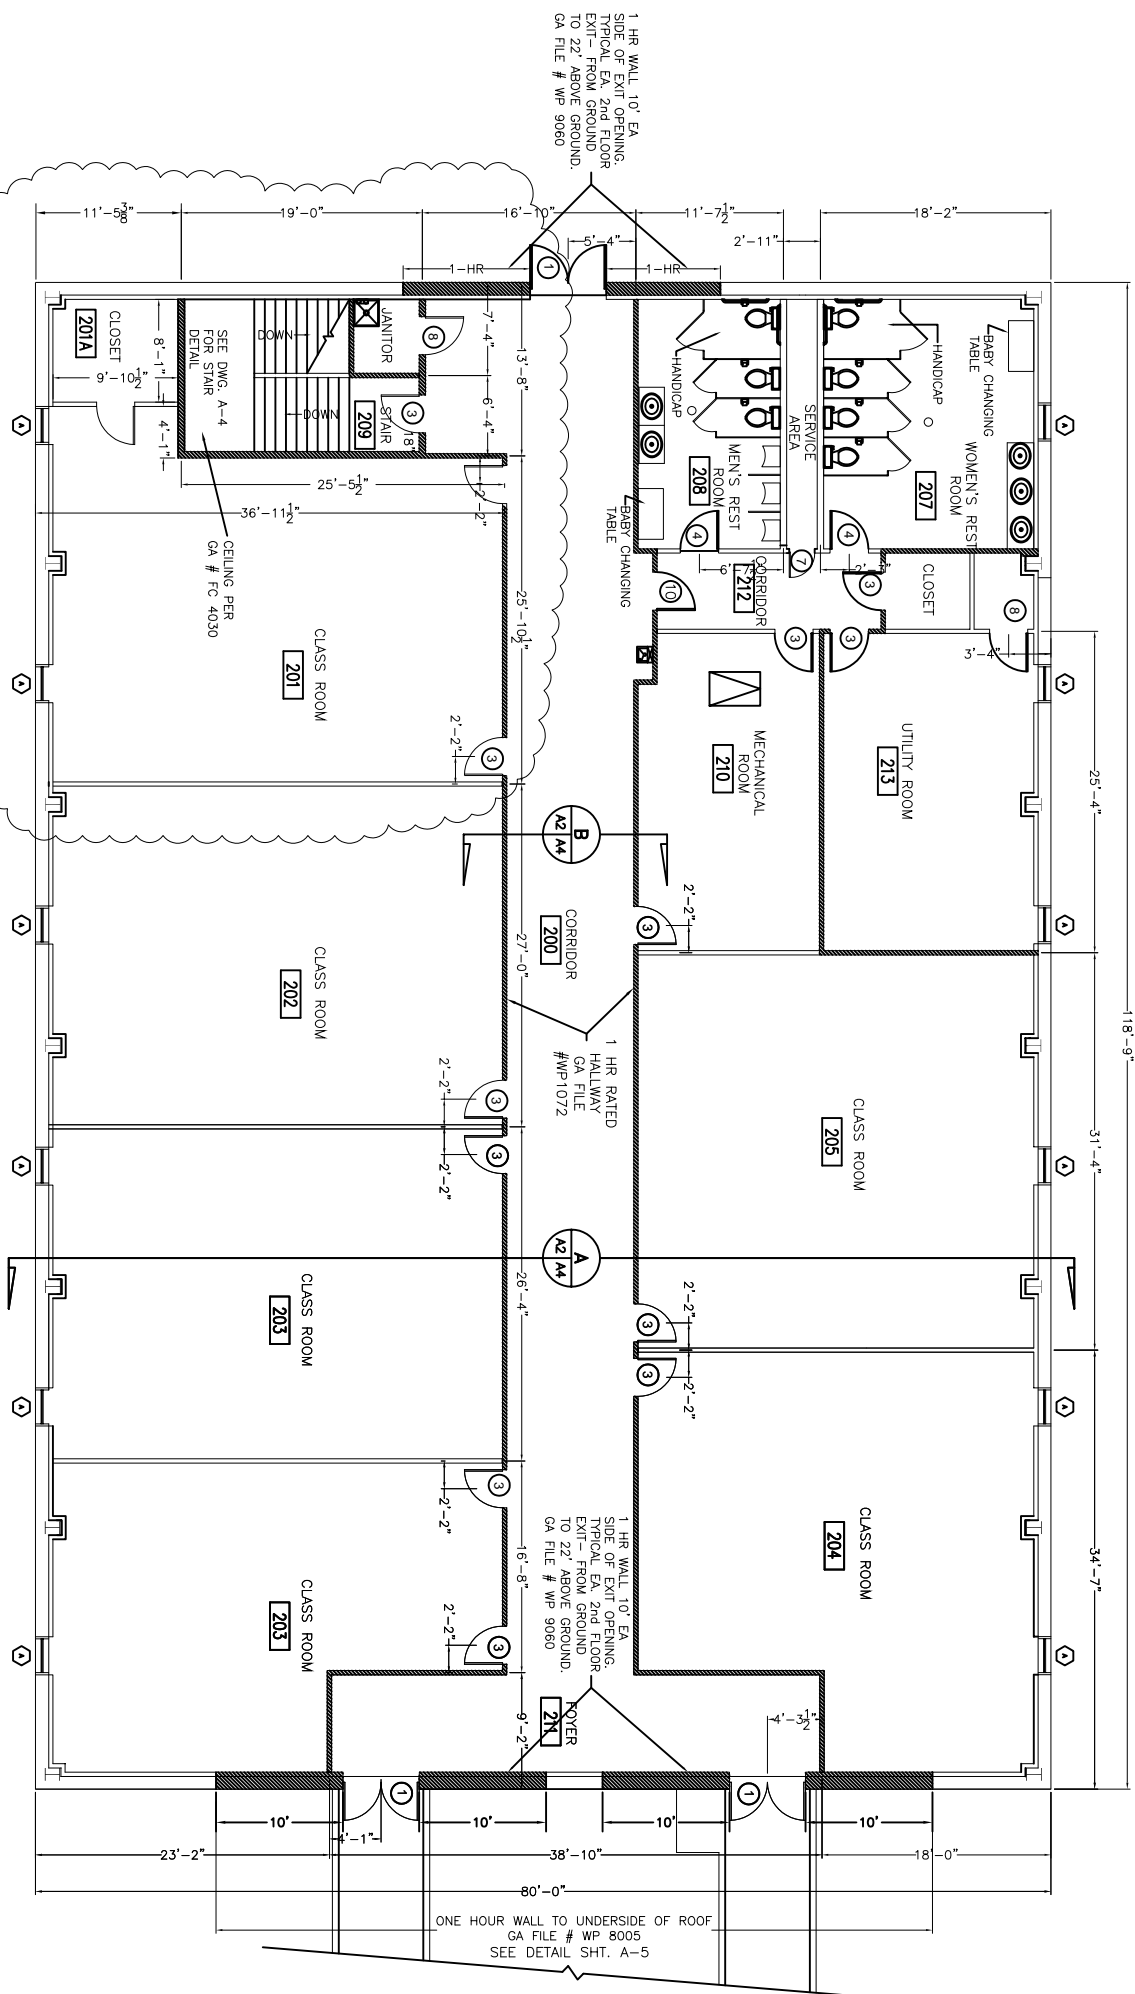

LEGEND  
1 HR RATED - [Hatched Pattern]