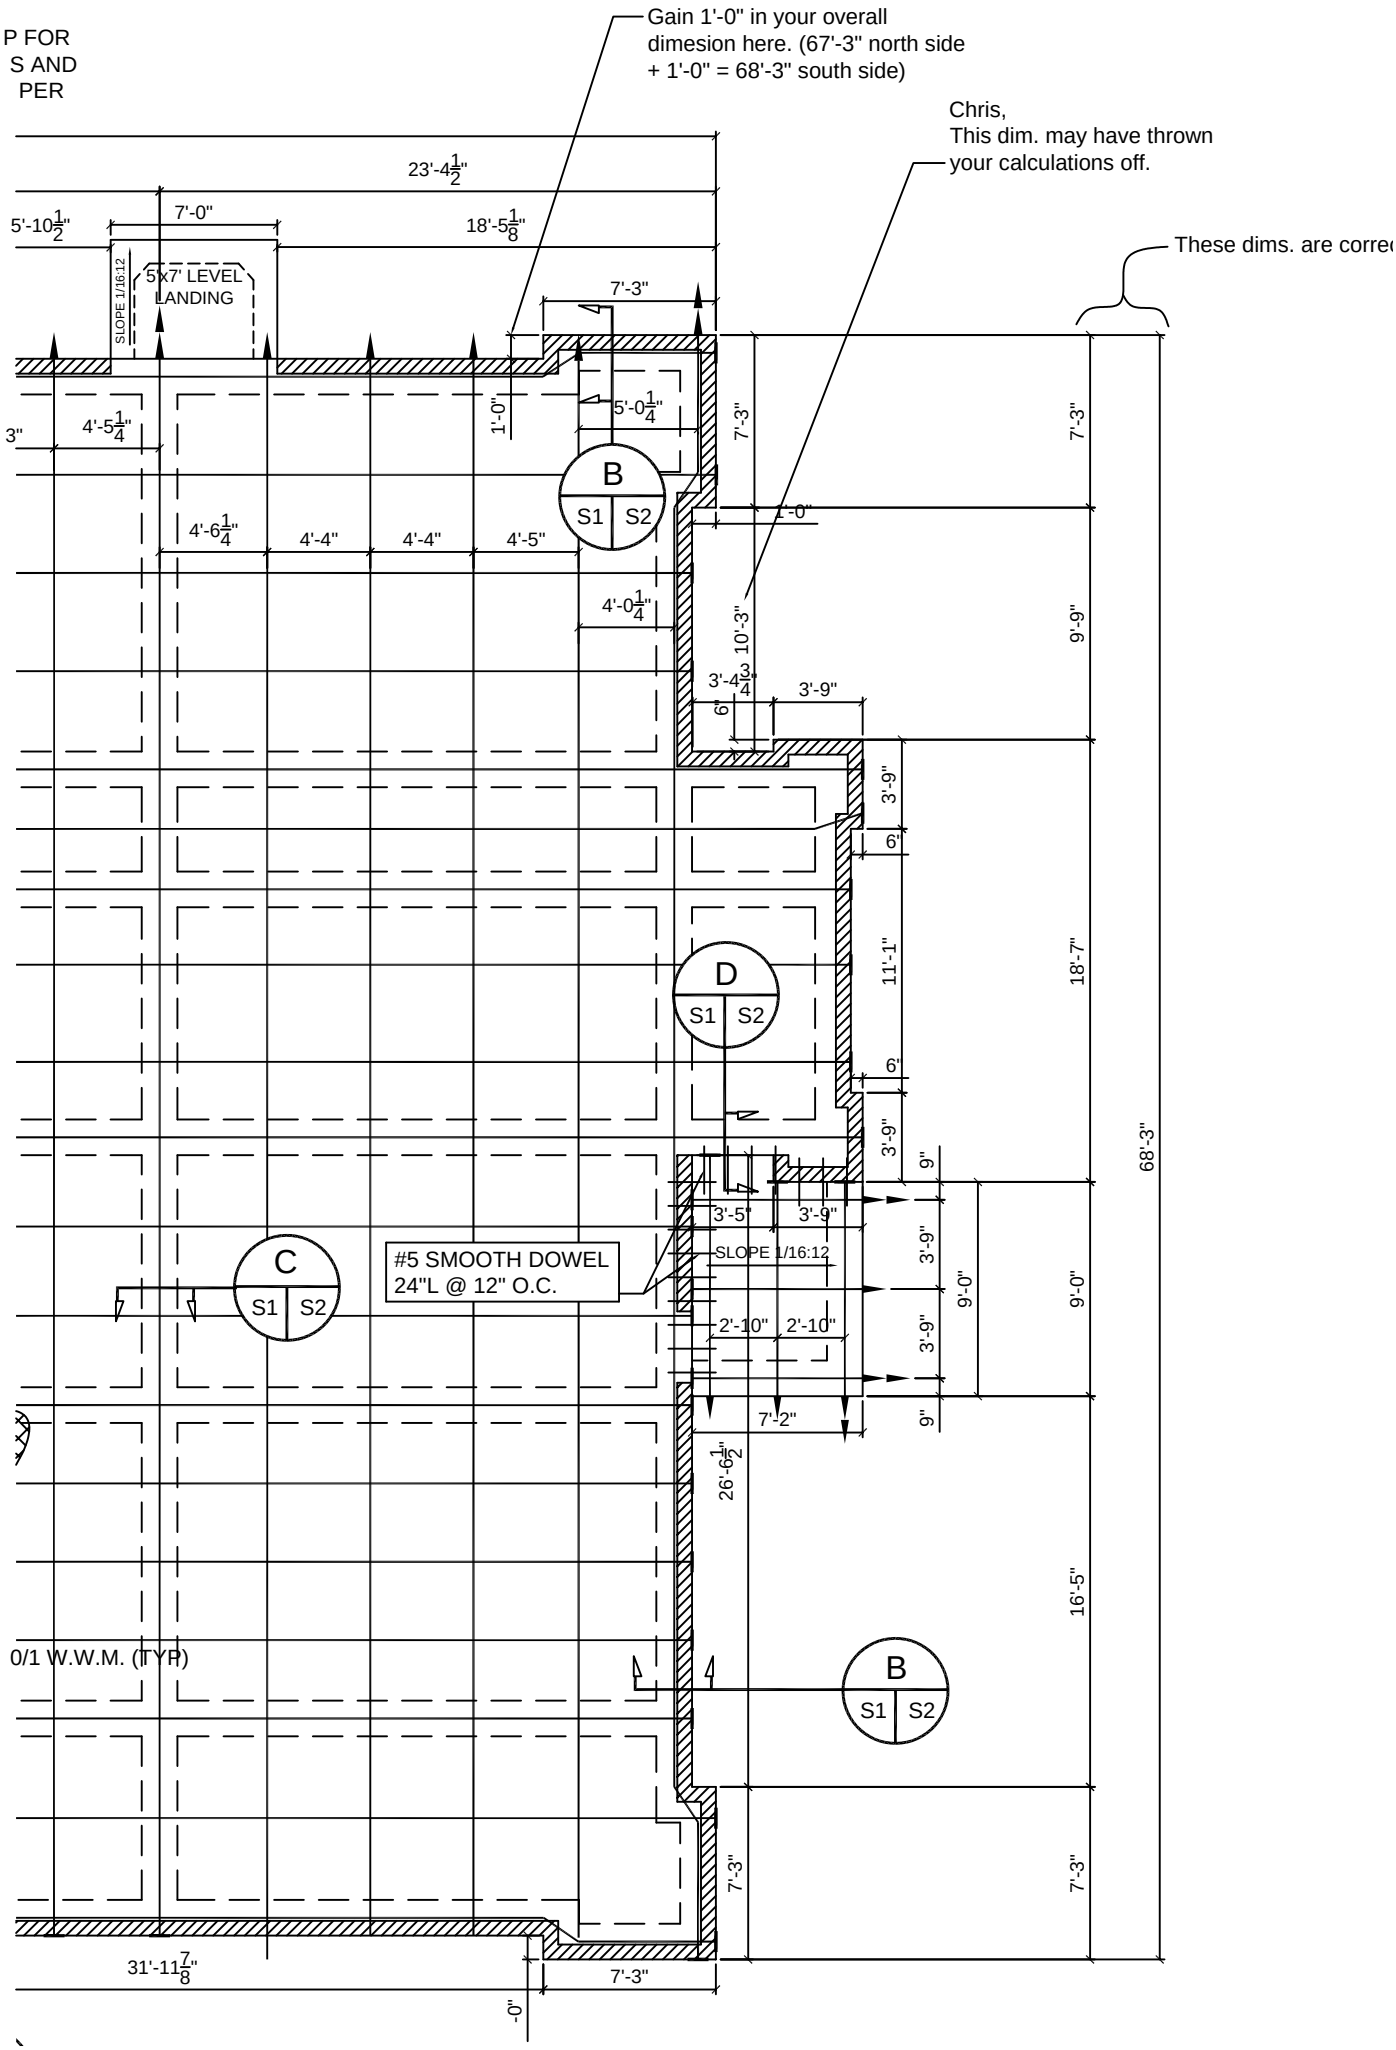
P FOR
S AND
PER
Gain 1'-0" in your overall dimesion here. (67'-3" north side + 1'-0" = 68'-3" south side)
Chris,
This dim. may have thrown your calculations off.
These dims. are corre
23'-4 1/2"
5'-10 1/2"
7'-0"
18'-5 1/8"
SLOPE 1/16:12
5'X7' LEVEL LANDING
7'-3"
1'-0"
5'-0 1/4"
4'-5 1/4"
3"
B
S1 S2
4'-6 1/4"
4'-4"
4'-4"
4'-5"
4'-0 1/4"
10'-3"
3'-4 3/4"
3'-9"
6"
1'-0"
7'-3"
9'-9"
3'-9"
6"
D
S1 S2
11'-1"
18'-7"
6"
3'-9"
9"
3'-5"
3'-9"
SLOPE 1/16:12
#5 SMOOTH DOWEL 24"L @ 12" O.C.
C
S1 S2
3'-9"
9'-0"
9'-0"
2'-10"
2'-10"
3'-9"
7'-2"
9"
26'-6 1/2"
68'-3"
16'-5"
0/1 W.W.M. (TYP)
B
S1 S2
7'-3"
7'-3"
31'-11 7/8"
7'-3"
-0"