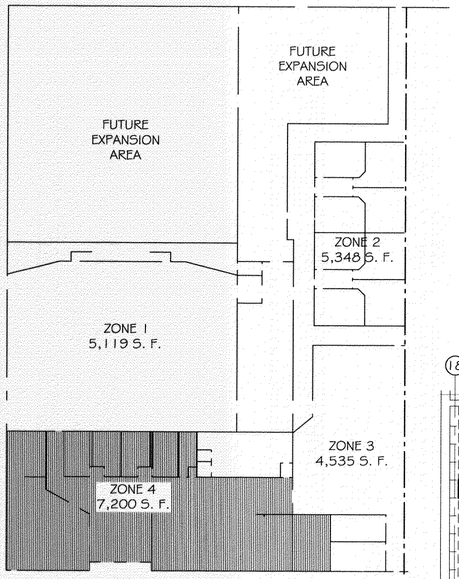

KEY PLAN
N. T. S.

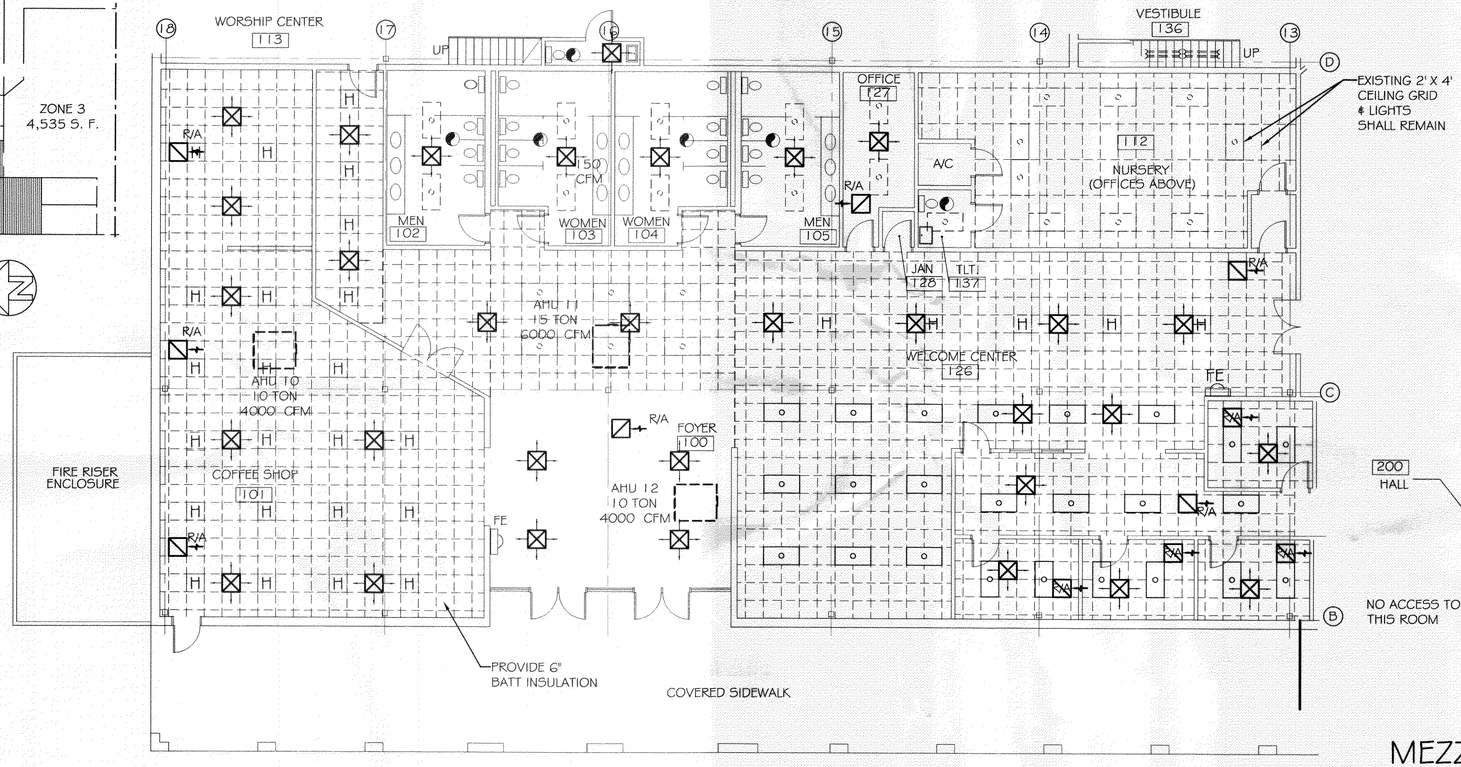

ZONE 4 REFLECTED CEILING PLAN
SCALE: 1/8"=1'-0"

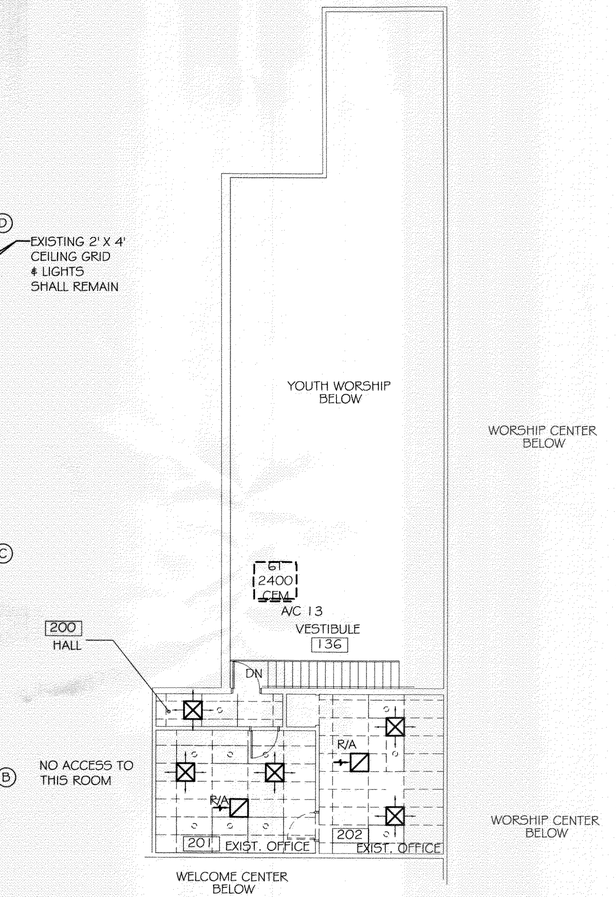

MEZZANINE OFFICES
REFLECTED CEILING PLAN
SCALE: 1/8" = 1'-0"

LEGEND

- -EXISTING 2 X 4 FLUORESCENT FIXTURE
- -EXISTING 2 BULB FLUORESCENT FIXTURE
- -EXISTING 2 X 4 FLUORESCENT FIXTURE
- -EXISTING HPS FIXTURE
- -EXISTING REFLECTED CEILING
- -NEW REFLECTED CEILING
- -24" X 24" SUPPLY AIR DUCT
- R/A -24" X 24" RETURN AIR DUCT
- ON -24" X 48" 4 BULB FLUORESCENT FIXTURE (N= NIGHT LIGHT- ALWAYS ON)
- -CEILING MOUNTED FIXTURE
- -TRACK LIGHTING
- -EXTERIOR WALL SCONCE FIXTURE W/ 90 MIN. BATTERY BACKUP
- FE -FIRE EXTINGUISHER & CABINET- 10 LB. MULTI-USE

367234
REVIEWED FOR STATE FIRE MARSHAL AS PER REVIEW LETTER
BY: LAWRENCE J. DELAUNE, ARCHITECT, CEO

DAMMON
ENGINEERING, INC.
CHIEF ENGINEER
EMMETT
DAMMON, P.E.
CHIEF ARCHITECT
ROBERT
WILTSE
1095 FLORIDA AVENUE
SLIDELL, LA. 70458
OFFICE: 985-649-5832
FAX: 985-641-5950
WEBSITE:
WWW.DAMMONENGINEERING.COM
EMAIL:
DAMMONENG@BELLSOUTH.NET
ARCHITECTURE
ENGINEERING
STUDIES
PLANNING
INVESTIGATION
EXPERT WITNESS

NORTHSHORE CHURCH
KENSINGTON DR.
SLIDELL, LA

ZONE 4, OFFICES REFLECTED CEILING PLANS

REV:03-23-09
SCALE: AS NOTED
JOB#: 1988
DATE: 09-30-08
SHEET
E-3
OF