

DAMMON ENGINEERING, INC.

CHIEF ENGINEER
EMMETT
DAMMON, P.E.

CHIEF ARCHITECT
ROBERT
WILTSE

554 OLD SPANISH TRAIL
SLIDELL, LA. 70458
OFFICE: 985-649-5832
FAX: 985-641-5950

WEBSITE:
WWW.DAMMONENGINEERING.COM


EMAIL:
DAMMONENG@BELLSOUTH.NET

ARCHITECTURE
ENGINEERING
STUDIES
PLANNING
INVESTIGATION
EXPERT WITNESS

LIVING THE WORD
INTERNATIONAL

2528
OLD SPANISH TRAIL
SLIDELL, LA
70461

COPY OF
SURVEY

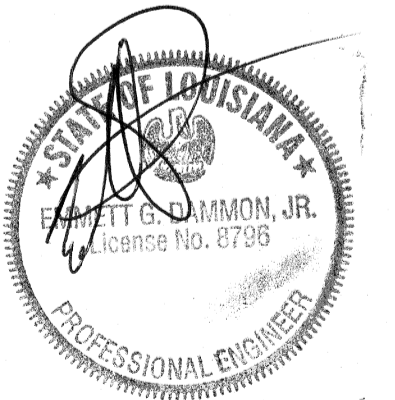

REV:

SCALE: AS NOTED


JOB#: 2128

DATE: 01-27-12

SHEET 2

C-1

OF 21

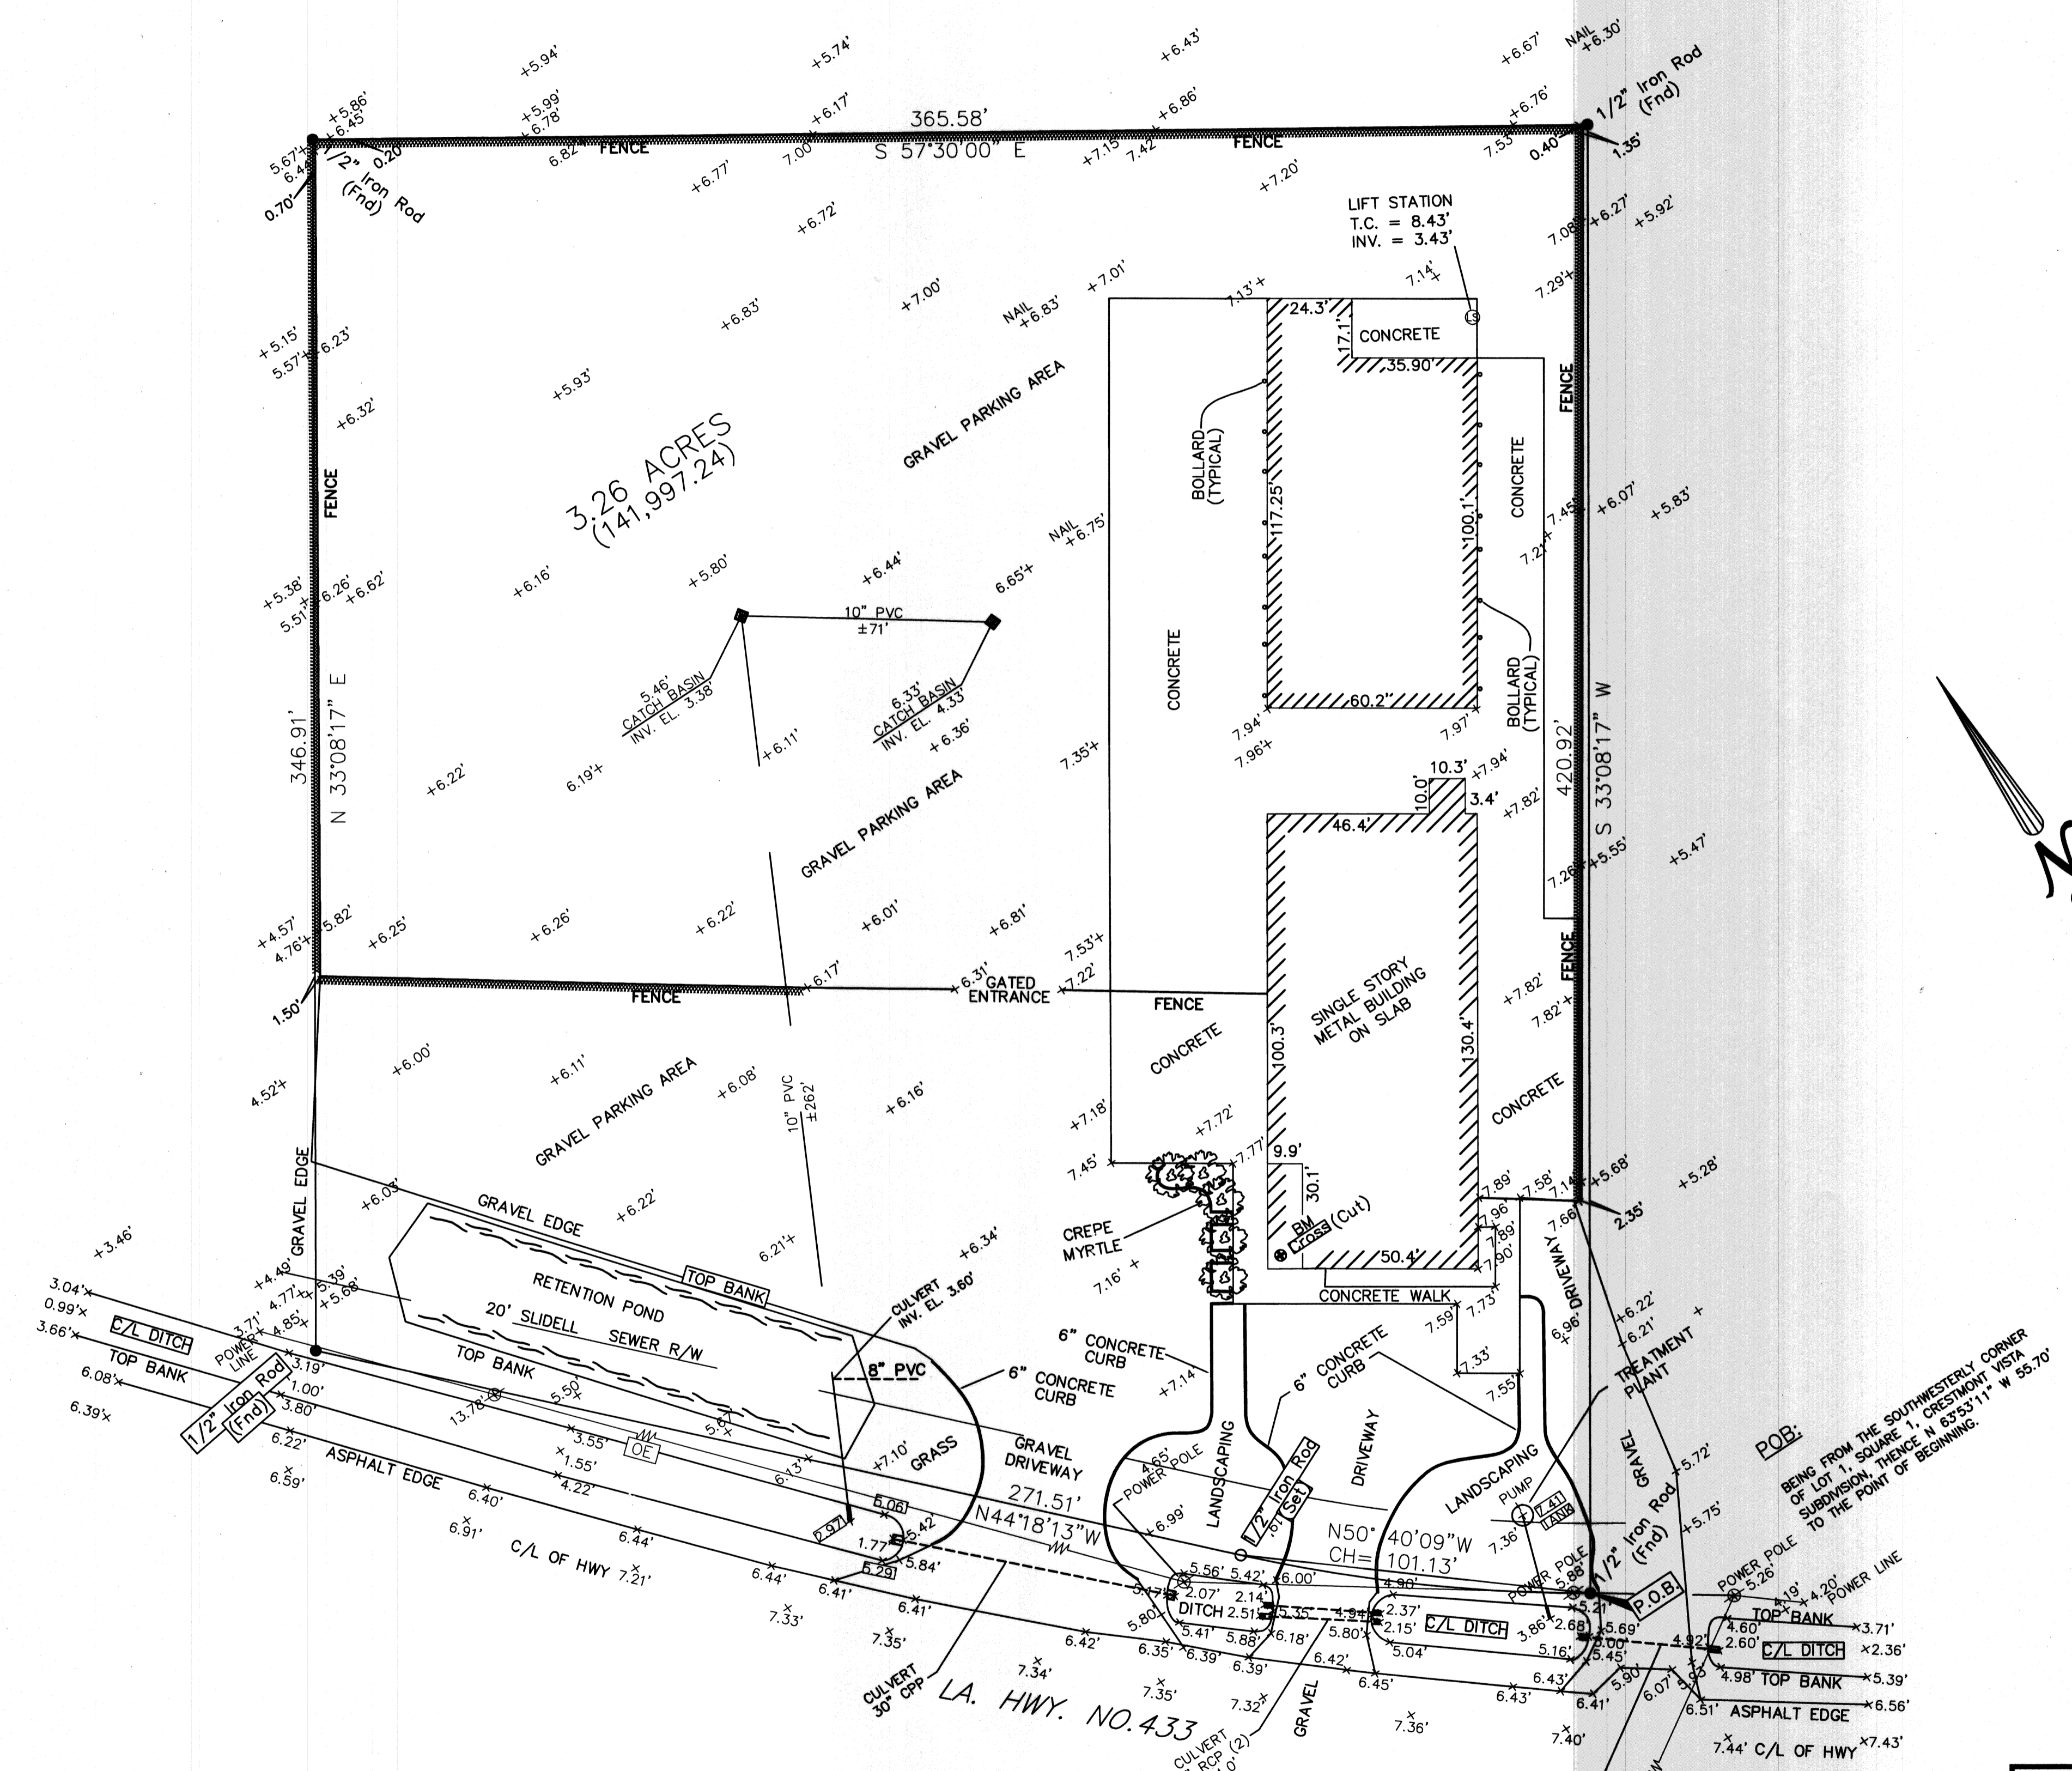

- REFERENCE SURVEYS:
1. SURVEY NO. 1061939 DATED 06-27-06 BY J. V. BURKES
 2. SURVEY NO. 1040196 DATED 03-15-04 BY J. V. BURKES
 3. SURVEY NO. 1040232 DATED 02-06-04 BY J. V. BURKES
 4. SURVEY NO. 1034237 DATED 12-31-03 BY J. V. BURKES
 5. SURVEY NO. 890303 DATED 05-30-89 BY J. V. BURKES
 6. SURVEY NO. 46395 DATED 10-29-86 BY IVAN M. BORGES

J.V. Burkes & Associates, Inc.

1805 Shortcut Highway
Slidell, Louisiana 70458
E-mail: jvbassoc@jvburkes.com
Phone: 985-649-0075 Fax: 985-649-0154
Mississippi Phone: 228-435-5800

DECLARATION IS MADE TO ORIGINAL PURCHASER OF THE SURVEY. IT IS NOT TRANSFERABLE TO ADDITIONAL INSTITUTIONS OR SUBSEQUENT OWNERS. SURVEY IS VALID ONLY IF PRINT HAS ORIGINAL SEAL OF SURVEYOR.

F.I.R.M. No. 2252050535 D
F.I.R.M. Date: 04-02-1991
2N:A-9 B.F.E. 5/7-9
*Verify prior to construction with Local Governing Body.