Phase 1 outlets

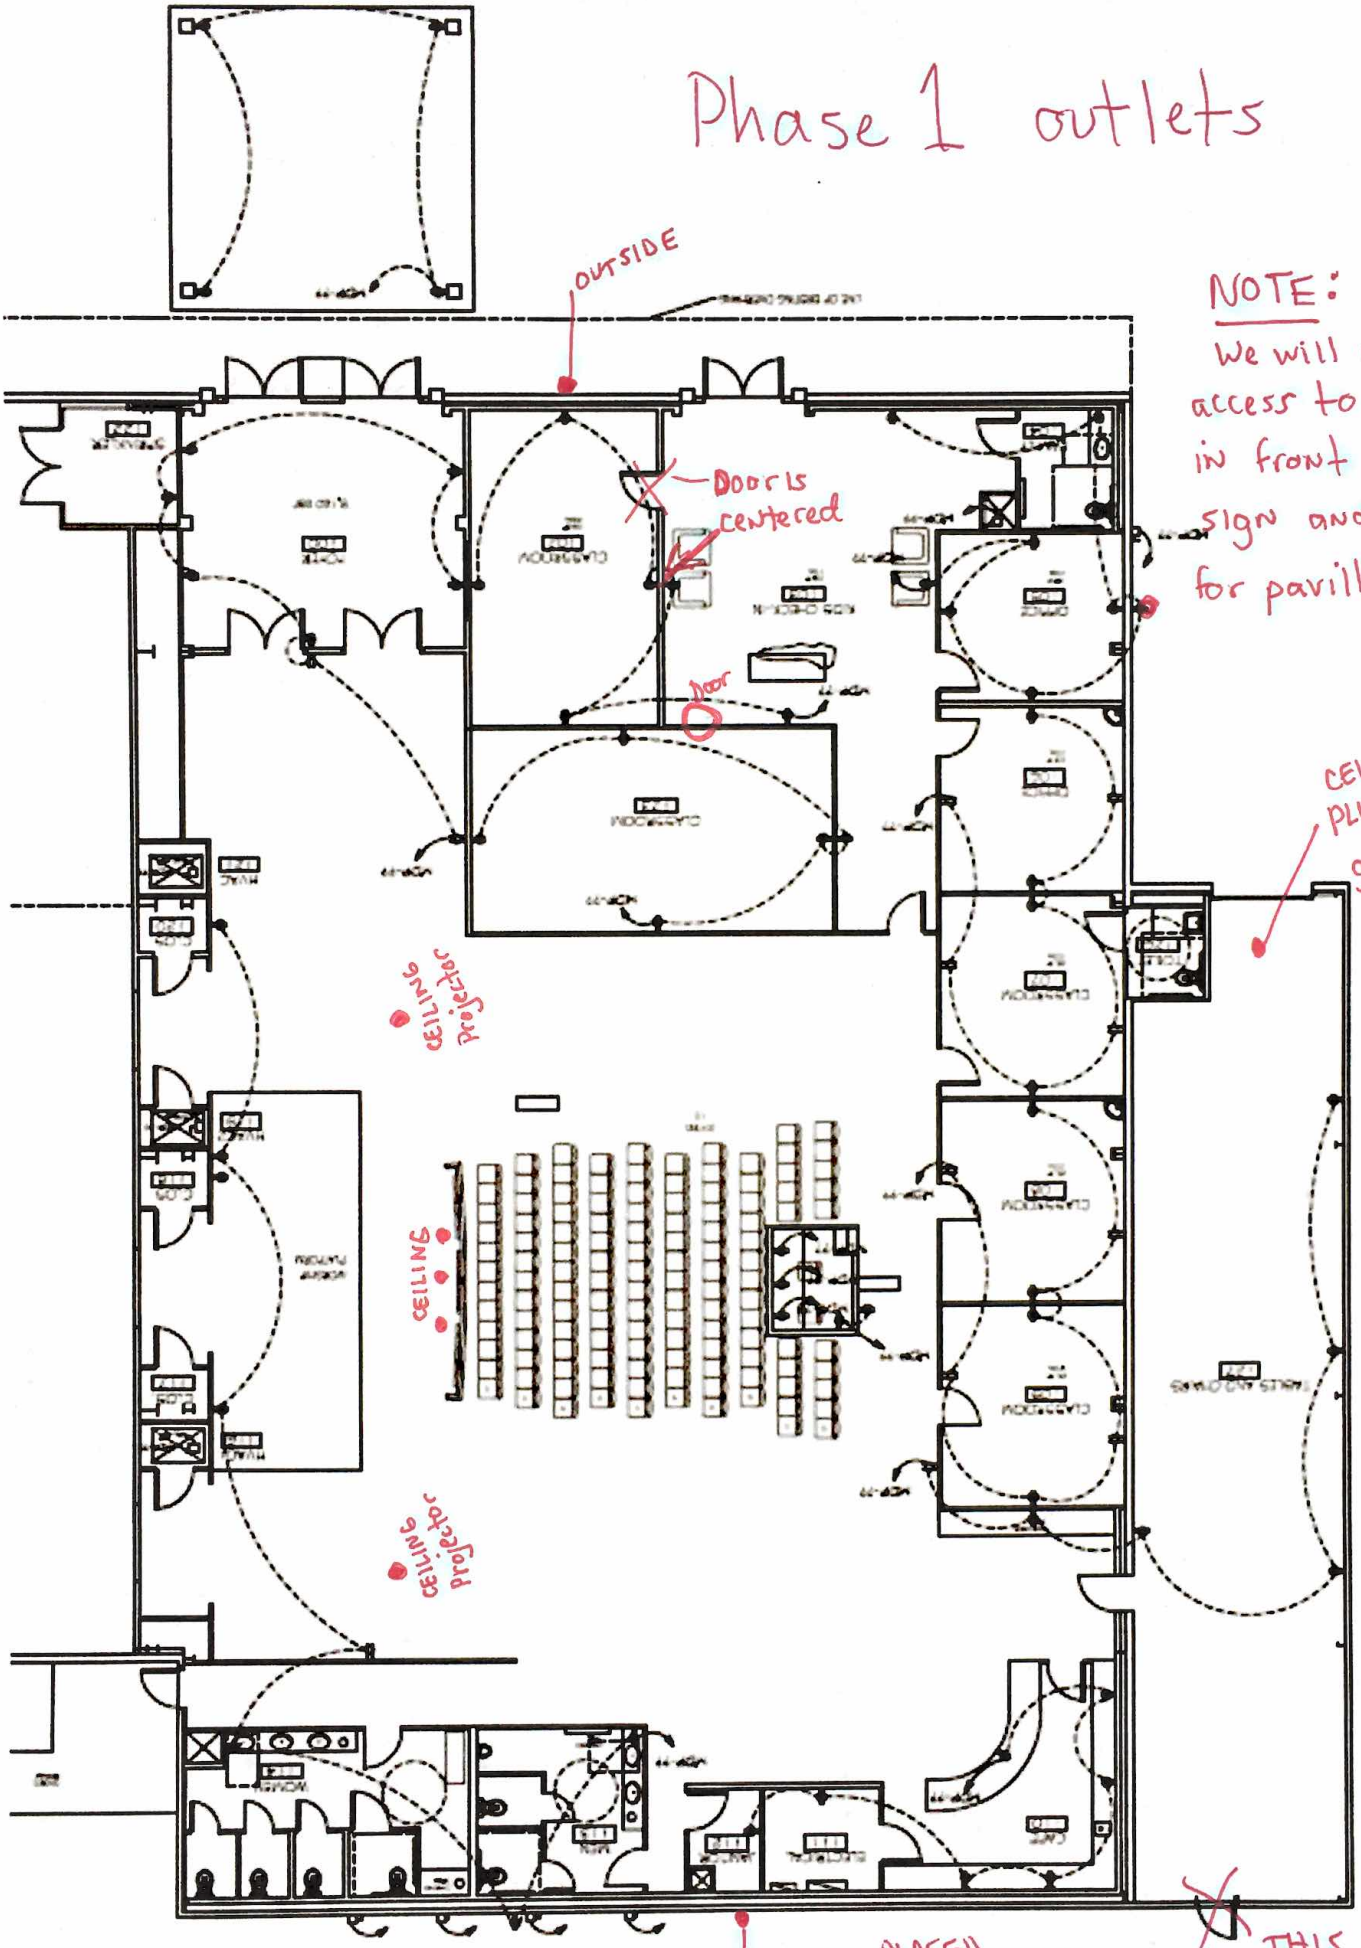

NOTE:
We will need access to power in front for our sign and in back for pavillion.