4ft STRIP/LED

High BAY/LED

CAN LIGHT/LED

Phase 2 Lighting

• Sanctuary & youth Center will use completely different fixtures

{overhang Lighting needs power}
NON dimming 4ft LED strips
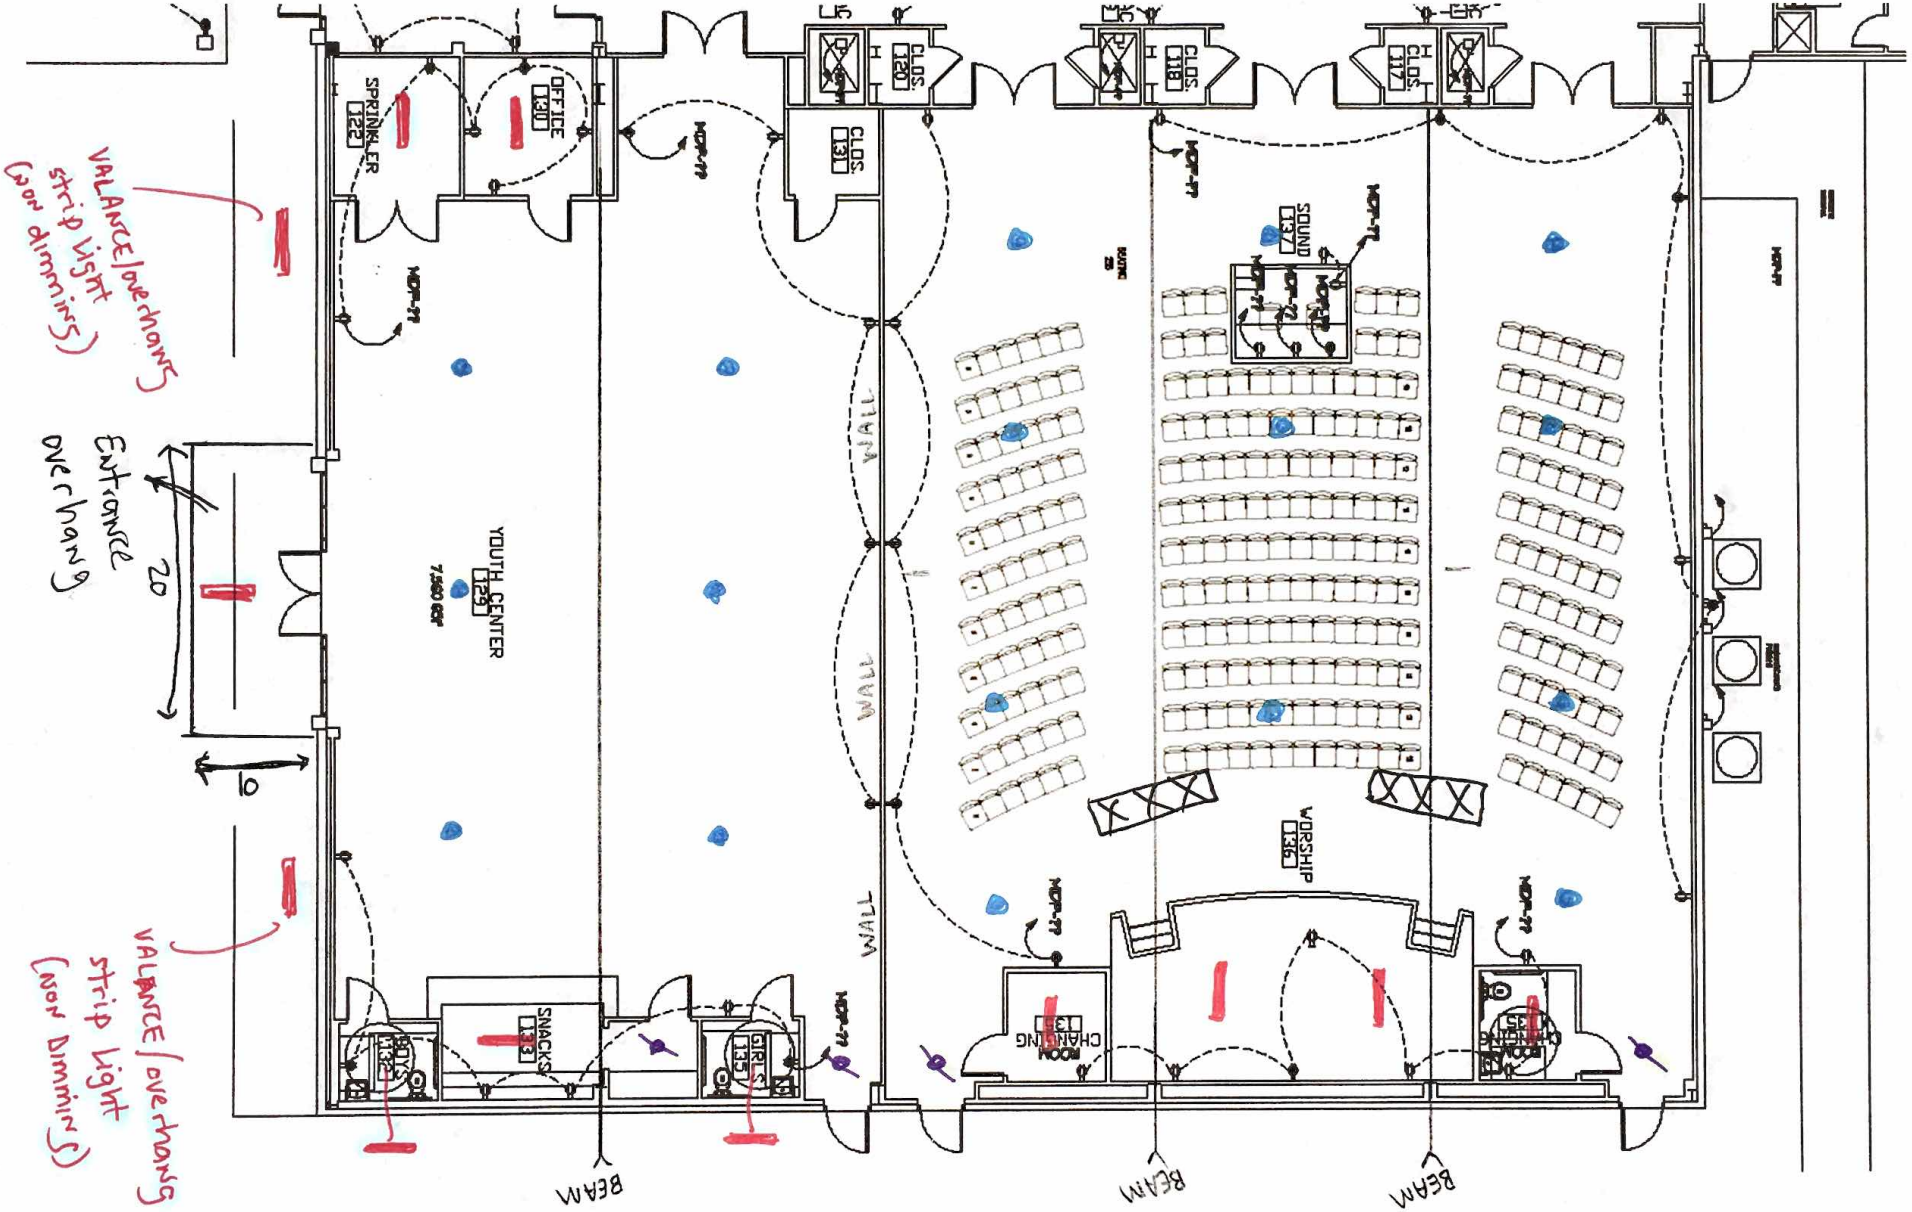
* STRIPS ABOVE STAGE MUST BE DIMMABLE.
ALL OTHER STRIPS IN Phase 2 are NOT DIMMABLE