



THIS IS THE ONE YOU SENT ME THIS MORNING

THIS IS THE ONE YOU JUST SENT ME

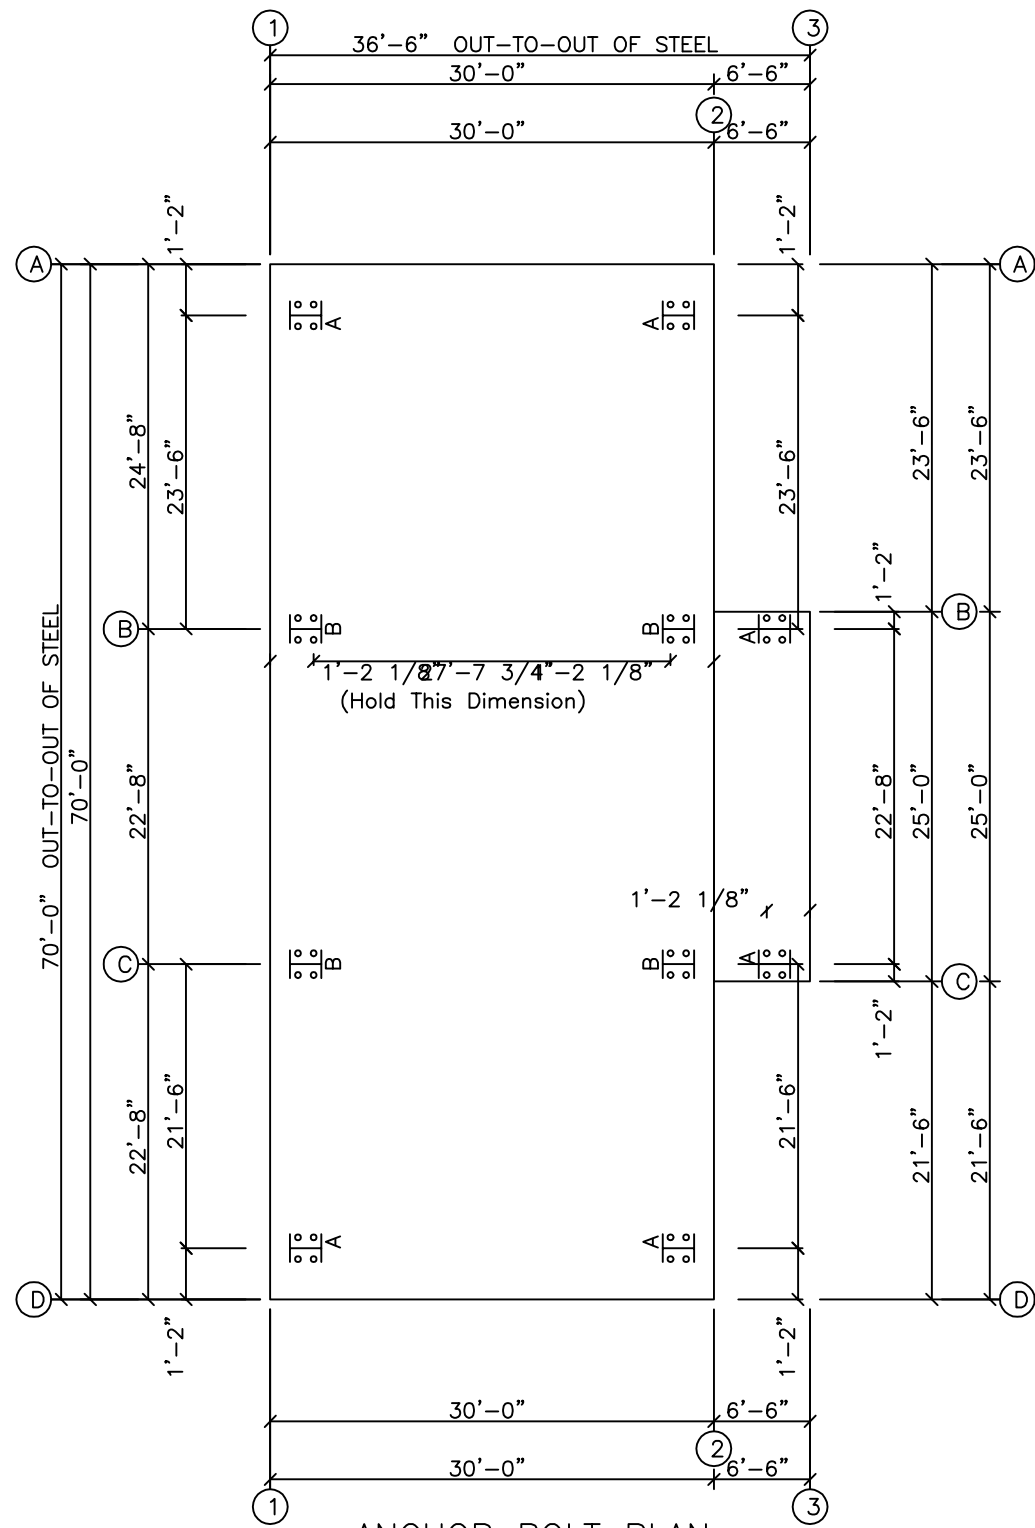

ANCHOR BOLT PLAN  
NOTE: All Base Plates @ 100'-0" (U.N.)

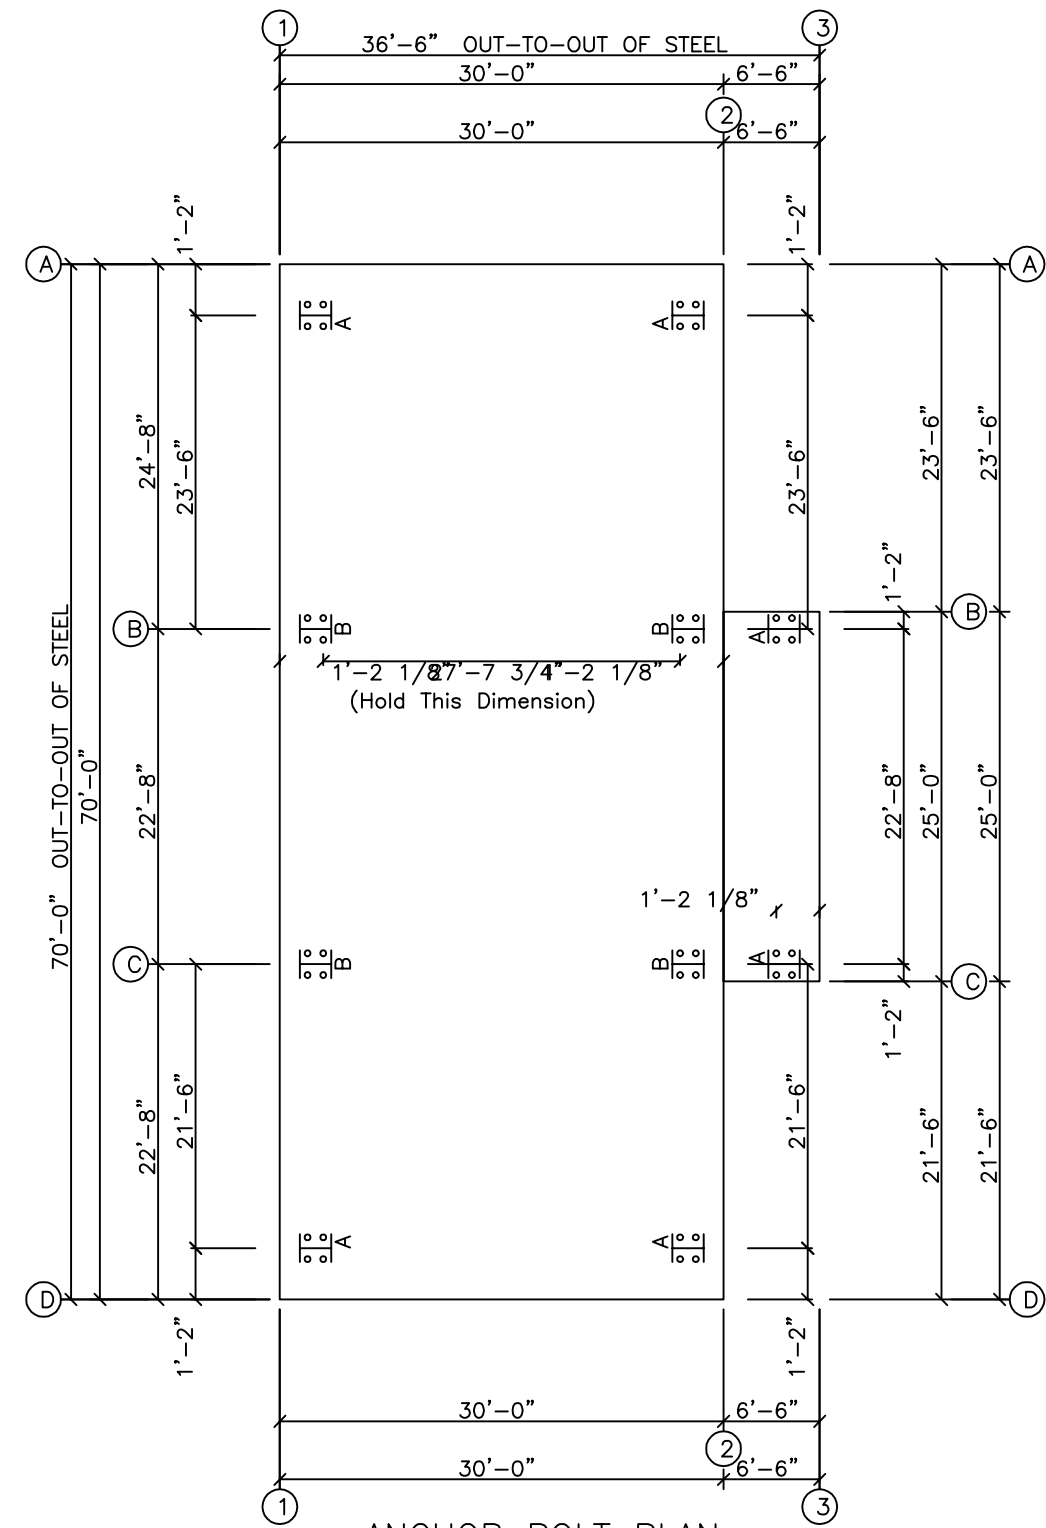

ANCHOR BOLT PLAN  
NOTE: All Base Plates @ 100'-0" (U.N.)

| Hercules Metal Buildings |               |                  |        |        |
|--------------------------|---------------|------------------|--------|--------|
| PROJECT                  | John Finch    | ANCHOR BOLT PLAN |        |        |
| ID                       | 124           | DESIGN:          | DRAFT: | CHECK: |
| PROJECT                  | PRJ Address 1 | DATE: 6/16/20    | SHEET  | OF     |
| ADDRESS                  | PRJ Address 2 |                  |        |        |