DRAINAGE NOTES

1. PROVIDE POSITIVE DRAINAGE AWAY FROM BLDG AND SHALL SLOPE TOWARDS EXISTING DITCHES AND CULVERTS.
2. ALL DISTURBED AREAS SHALL BE FULLY SODDED AND SLOPED OUT.

DRAINAGE LEGEND

x 0.00'	EXISTING ELEVATIONS
⟵	FLOW DIRECTION

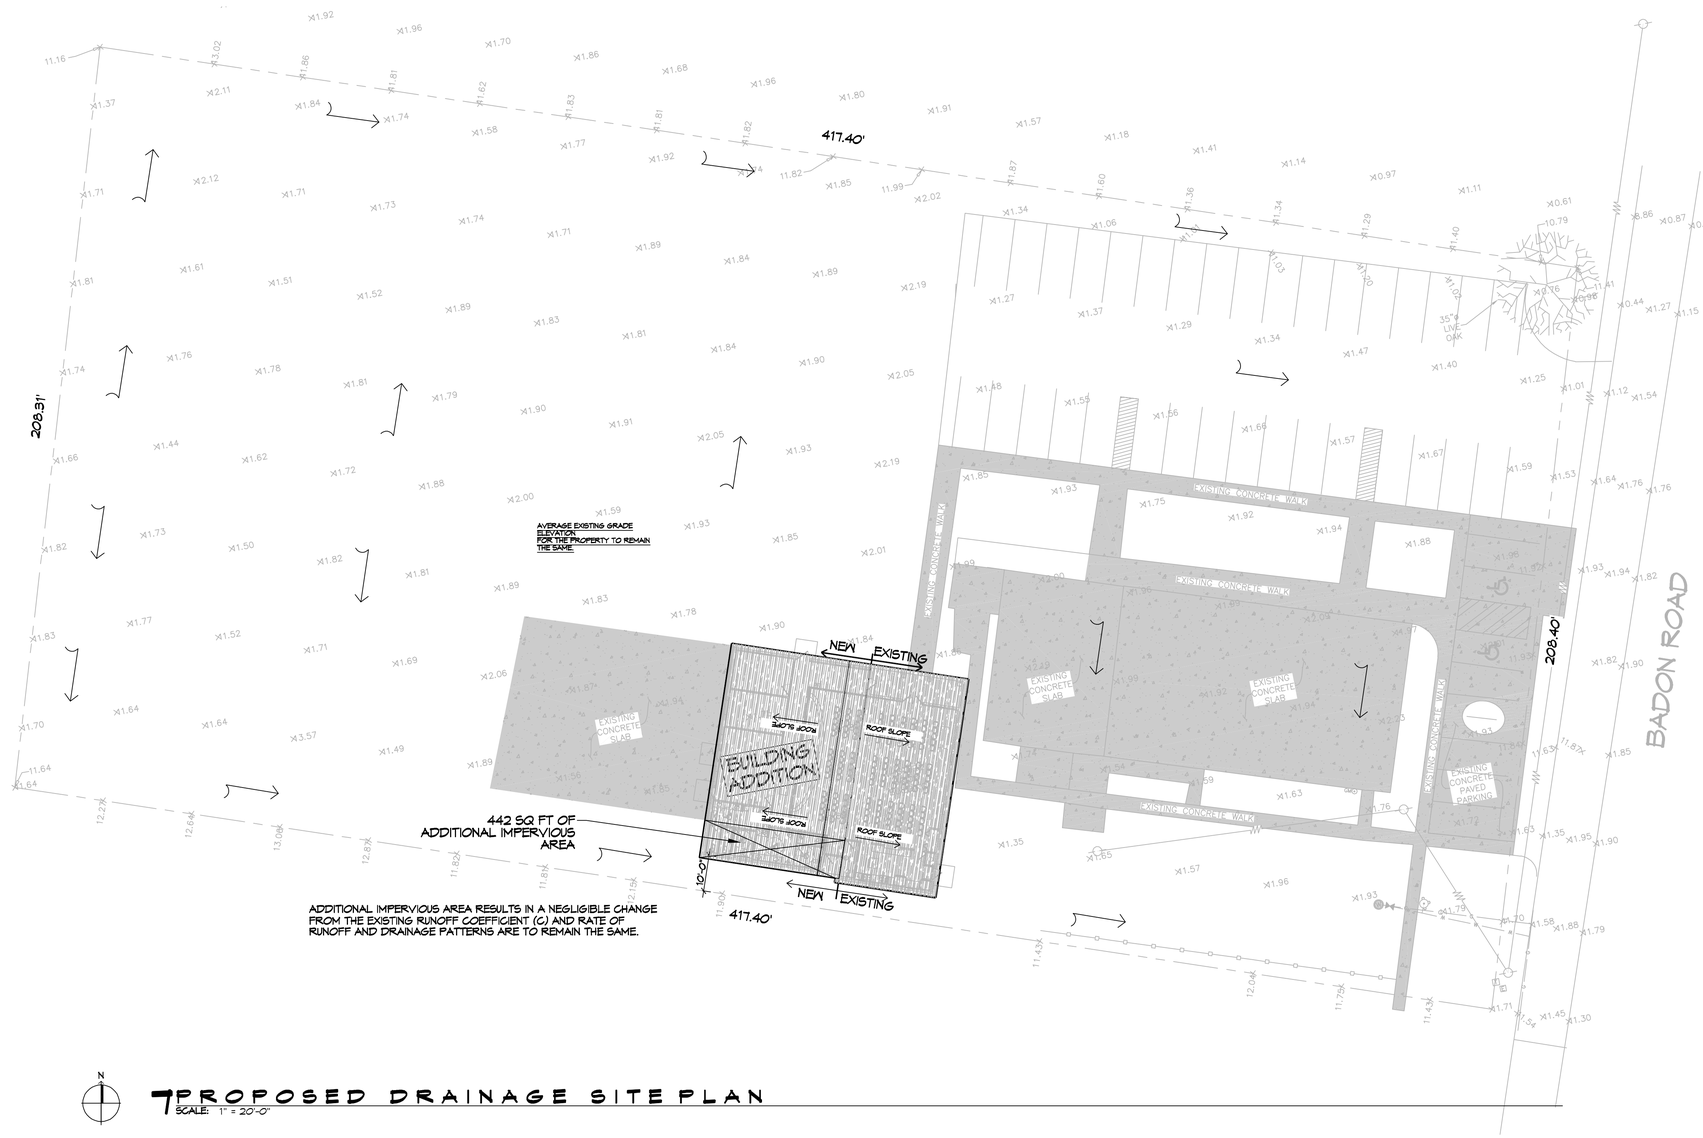

7 PROPOSED DRAINAGE SITE PLAN
SCALE: 1" = 20'-0"

AS-BUILT
11-4-24

DAMMON ENGINEERING, INC.
LOUISIANA & MISSISSIPPI
Chief Engineer: Brian Mistich, PE
554 Old Spanish Trail
Slidell, LA 70458
www.dammonengineering.com
info@dammonengineering.com
PH: 985.649.5832 F: 985.641.5950

REVISIONS

#	DESCRIPTION	DATE

STATE OF LOUISIANA
BRIAN A. MISTICH
License No. 30187
PROFESSIONAL ENGINEER

COMMUNITY BAPTIST CHURCH
54413 BADON RD
SLIDELL, LA 70460

JOB No:	2483	DATE:	10/10/2023
DRAWN BY:	CKD	CHECKED BY:	BAM

SHEET TITLE:
PROPOSED DRAINAGE SITE PLAN

DRAWING NUMBER:
C102

SHEET No: 4 of 15