


ROBERT J. PERKINS TRACT
JEFFERSON PARISH, LA

LA STATE HWY. 3134 SIDE

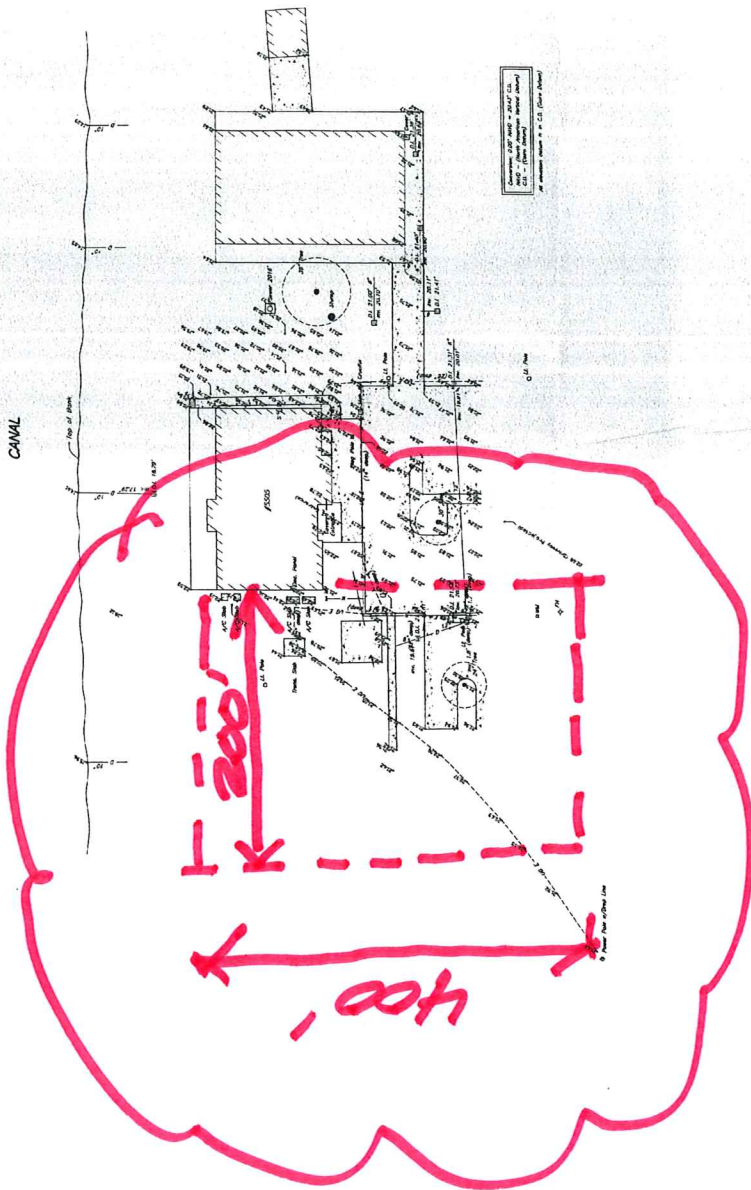

1-16-20

200 x 400 SURVEY
 PLOT FROM BACK (REAR) CORNER
 OF EXISTING BLDG.
 50' GRID @ PAVING AREA/
 25' GRID @ PAVING SITE. *can*



Scale: 1" = 30'





BAYOU DES FAMILIES

St. Joacum
Site Plan

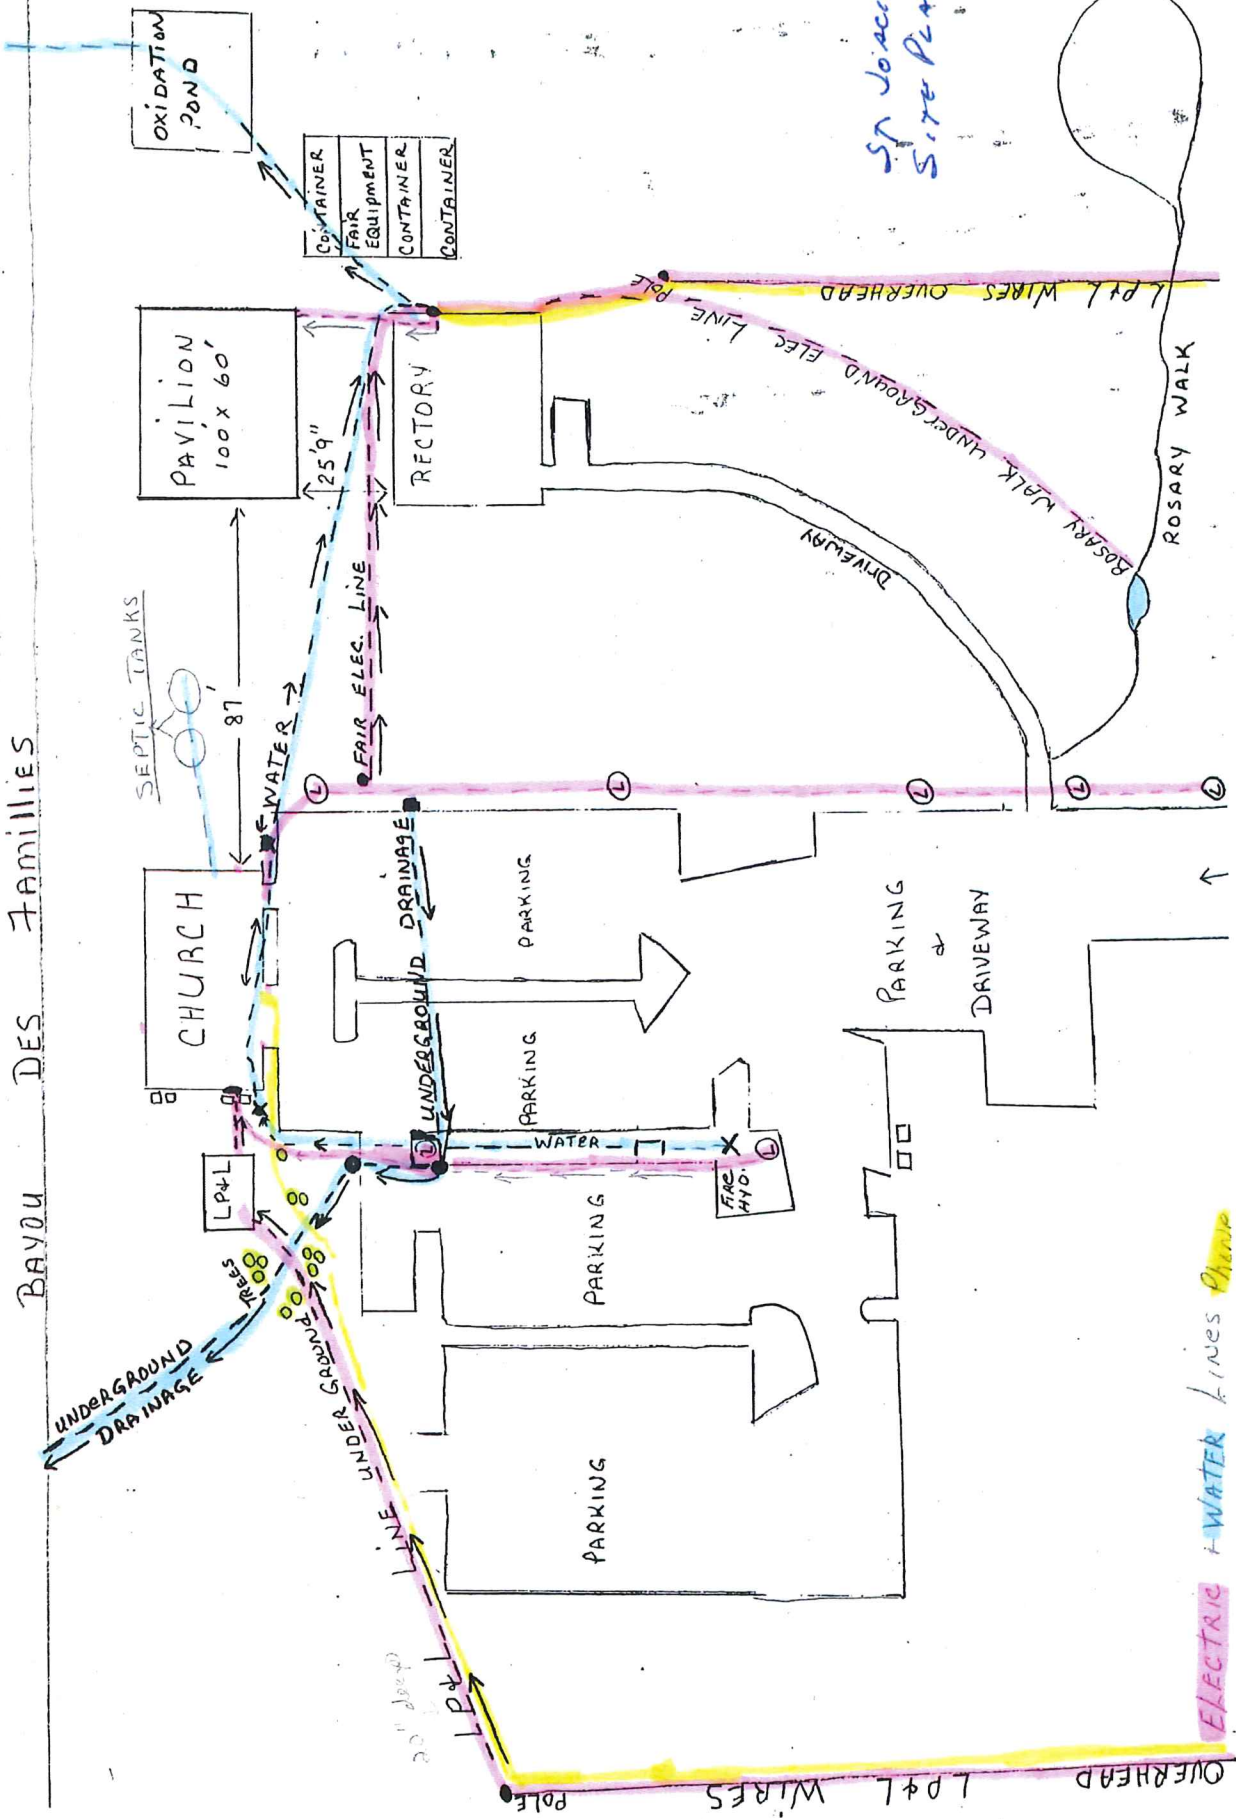


ELECTRIC + WATER lines shown

ST. JOACHIM
NEW ADMINISTRATION ADDITION



General Notes

No.	Revisions/Issues	Date

DATE	
PROJ NO	
FILE	
DRAWN	CMK
CHECKED	CMK

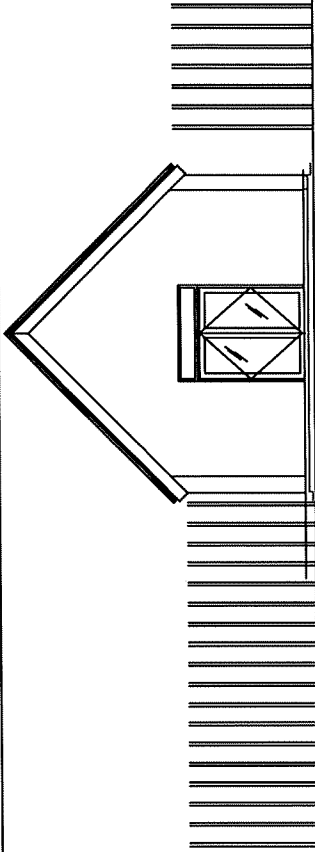

ELEVATION -opt 2
SCALE: 1/16" = 1'-0"

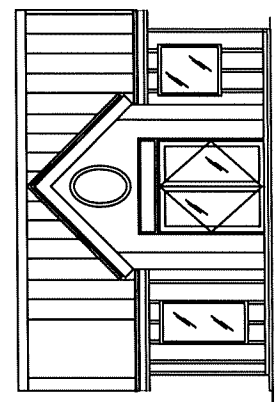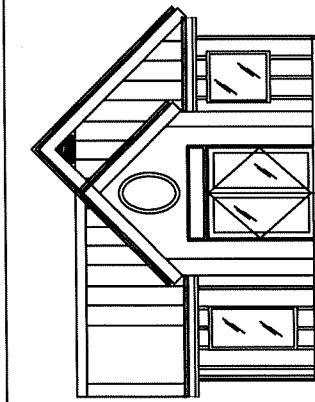

ELEVATION - opt 1
SCALE: 1/16" = 1'-0"

