


U. S. I N T E R S T A T E H W Y . 1 2

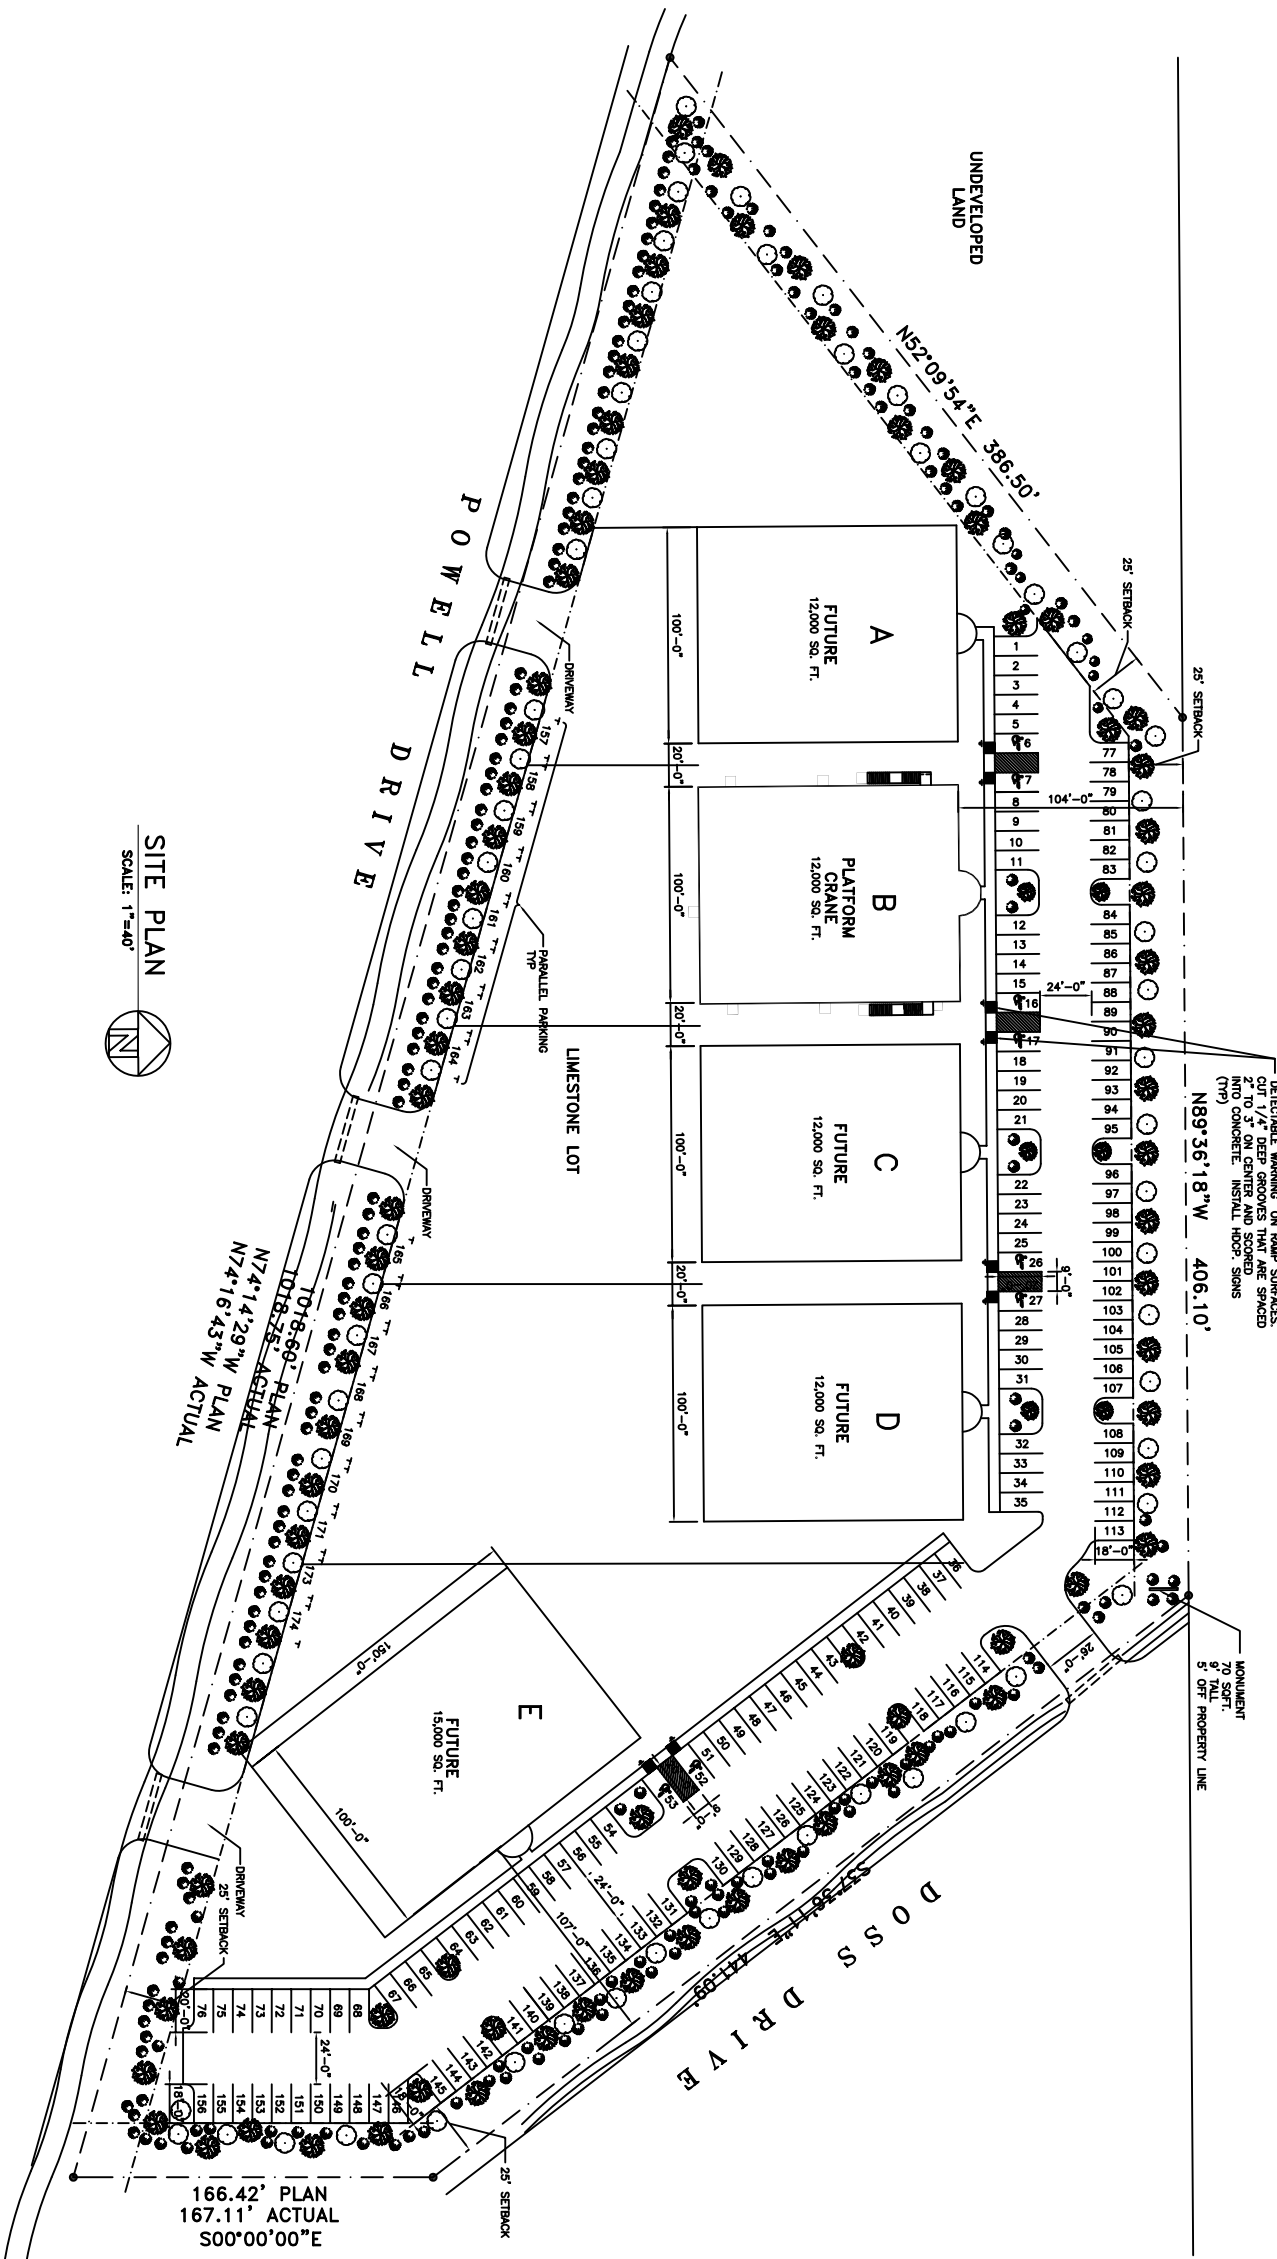

PARKING REQUIREMENTS:
 1 SPACE PER 350 SQ.FT. OF OFFICE SPACE
 1 SPACE PER 750 SQ.FT. OF WAREHOUSE SPACE
 TOTAL REQUIRED=160
 TOTAL PROVIDED=174

- LEGEND:**
- PROPERTY LINE
 - - - SETBACK LINE
 - - - NEW BUILDING
 - CLASS "A" TREE - MINIMUM OF 10' TO 12' HIGH, CALIBER OF 3"-1/2" MEASURED AT 1-1/2 FT ABOVE THE GROUND
 - CLASS "B" TREE - MINIMUM OF 8' TO 10' HIGH, CALIBER OF 1-1/2" MEASURED AT 1-1/2 FT ABOVE THE GROUND
 - SHRUB
 - MONUMENT
5' OF PROPERTY LINE

SITE PLAN
 SCALE: 1"=40'

N74°14'29"W PLAN
 N74°16'43"W ACTUAL

166.42' PLAN
 167.11' ACTUAL
 S00°00'00"E

OFFICE/WAREHOUSE

DAMMON ENGINEERING, INC.

1095 FLORIDA AVENUE 985-649-5832 SLIDELL, LA. 70458
 DAMMONENGINEERING.COM

SITE PLAN

PLATFORM CRANE SERVICE
 DOSS DRIVE
 SLIDELL, LOUISIANA

SCALE: AS NOTED

FILE:

JOB NO. 1655

DATE: 04-07-05

SHEET

C-2

OF