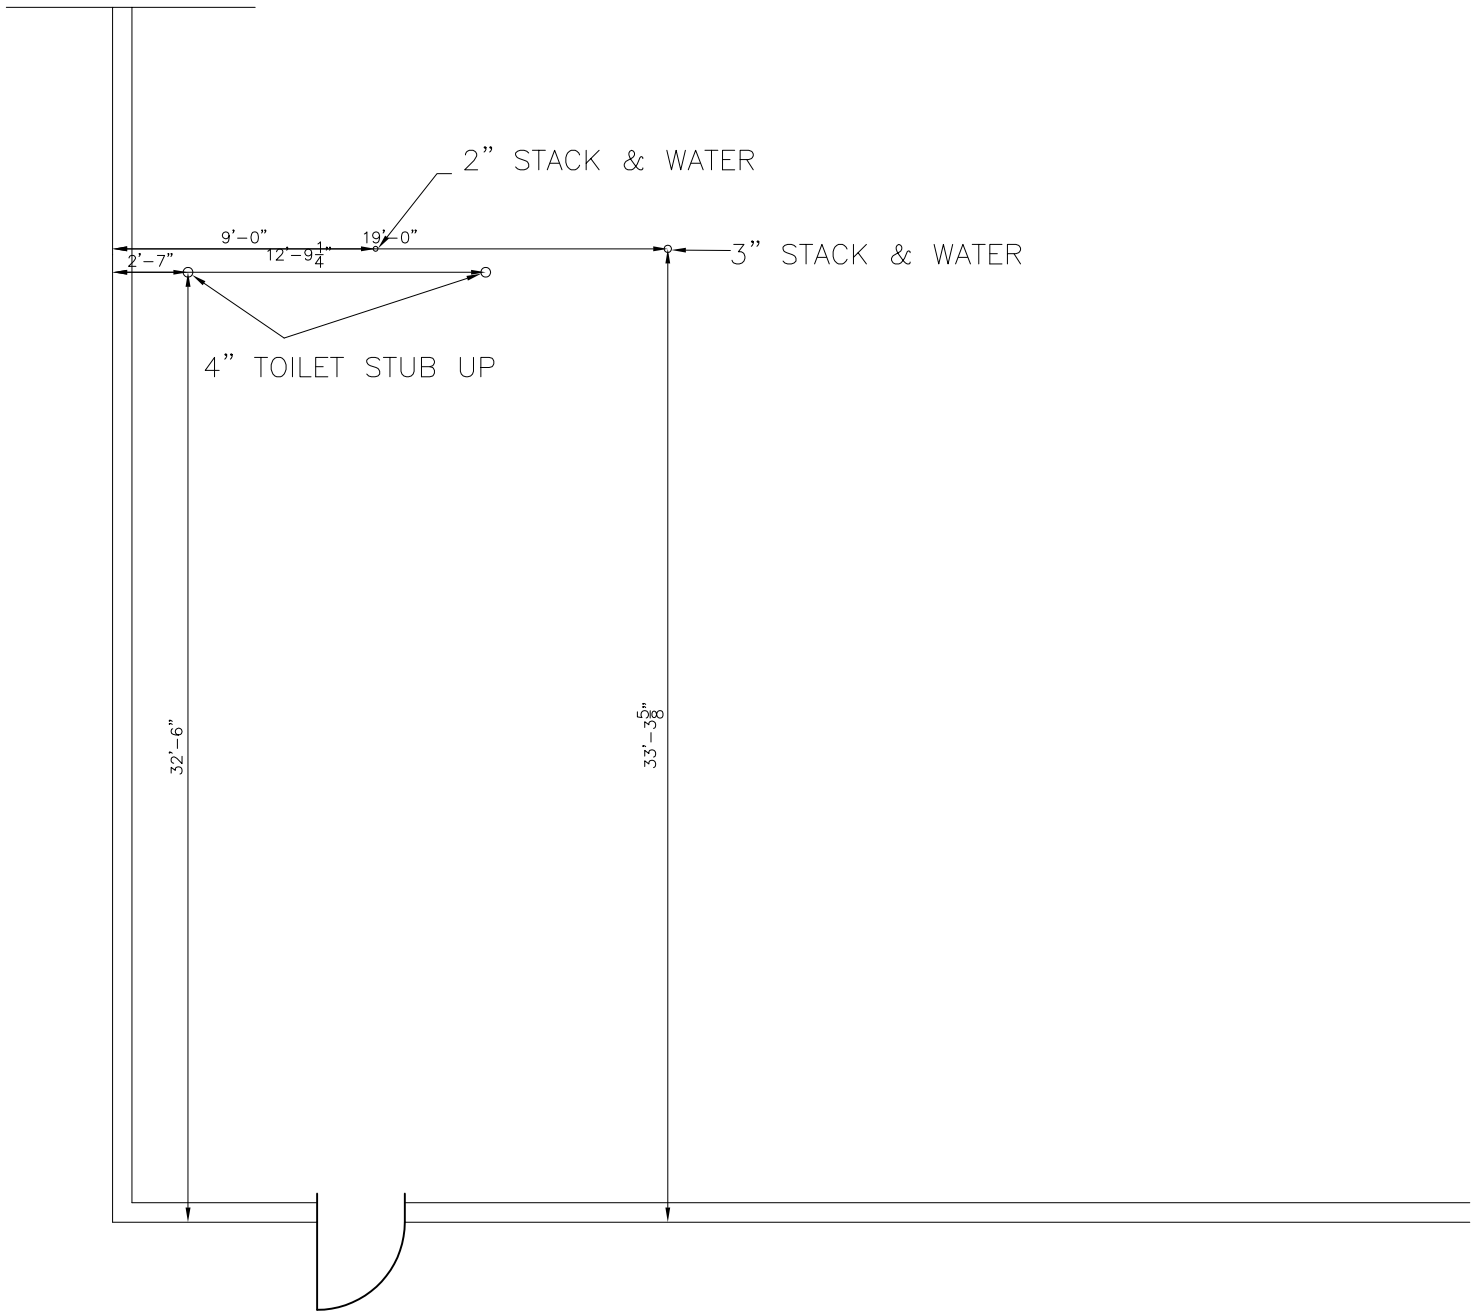
2" STACK & WATER
9'-0"
19'-0"
12'-9 1/4"
2'-7"
3" STACK & WATER
4" TOILET STUB UP
32'-6"
33'-3 5/8"