

Dammon Engineering Inc.

1095 Florida Ave.
Slidell, LA 70458
(985) 649-5832
Fax: (985) 641-5950

FAX COVER SHEET


FAX NUMBER TRANSMITTED TO: 985-624-6847
TO: Danny Brown
FROM: Jennie Tiffany
CLIENT/MATTER: _____
REFERENCE: Northlake Marine
DATE: Feb. 27, 2007 NO. OF PAGES INCLUDING COVER SHEET: 2

COMMENTS:

Here are the updated changes per your request.
Let us know what you think.
Thanks!
Jennie

IF YOU EXPERIENCE ANY PROBLEMS RECEIVING THIS FAX, PLEASE CALL (985) 649-5832,
OR FAX (985) 641-5950



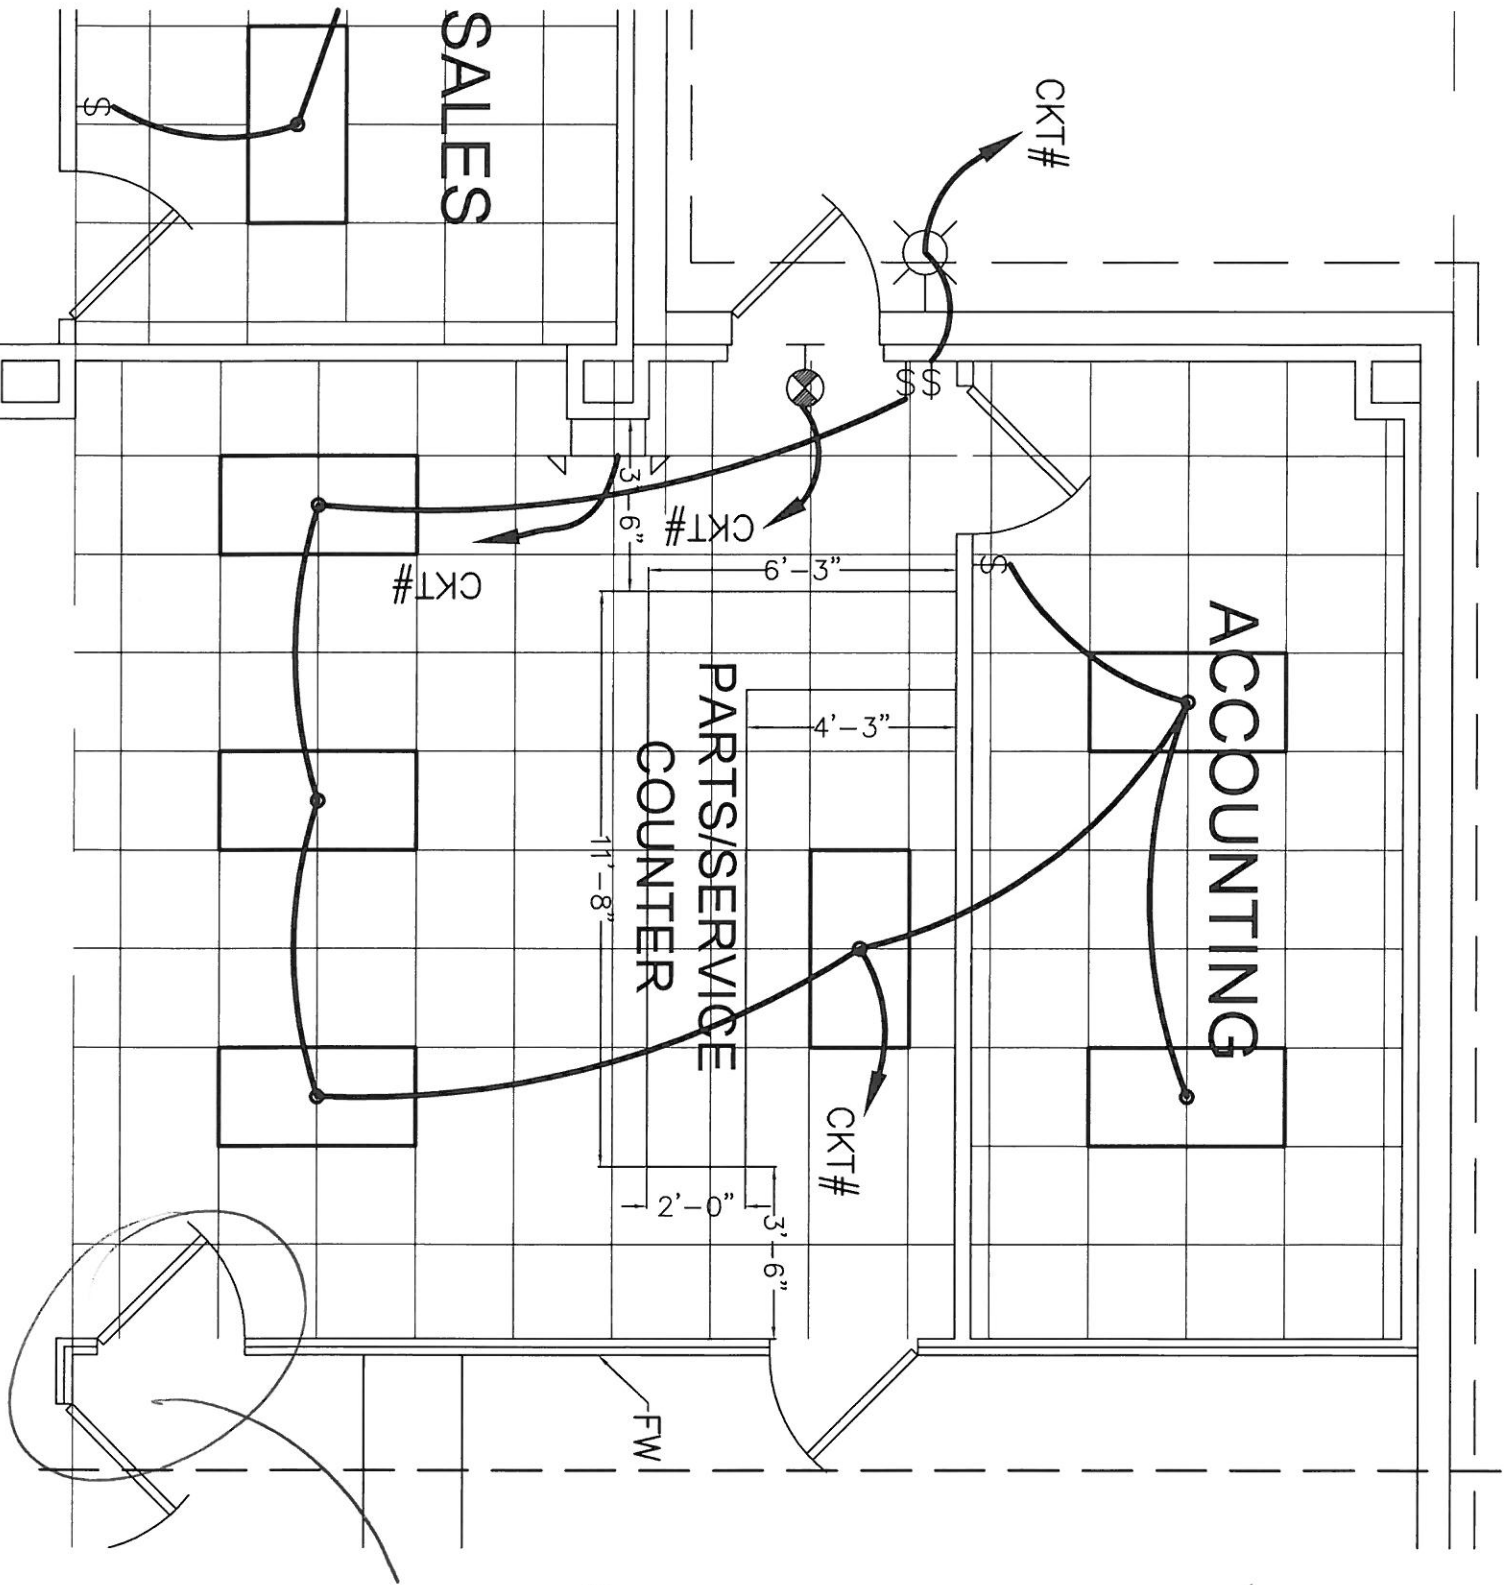

Remove Door & Extend wall!