

Dammon Engineering Inc.

1095 Florida Ave.
Slidell, LA 70458
(985) 649-5832
Fax: (985) 641-5950

FAX COVER SHEET

FAX NUMBER TRANSMITTED TO: 985-624-1847

TO: Danny Brown

FROM: Jennie Tiffany

CLIENT/MATTER: Northlake Marine

REFERENCE: _____

DATE: Feb. 14, 2007 NO. OF PAGES INCLUDING COVER SHEET: 3


COMMENTS:


Danny,


Here are the requested changes. Please let
us know what you think.

Thanks!

IF YOU EXPERIENCE ANY PROBLEMS RECEIVING THIS FAX, PLEASE CALL (985) 649-5832,
OR FAX (985) 641-5950

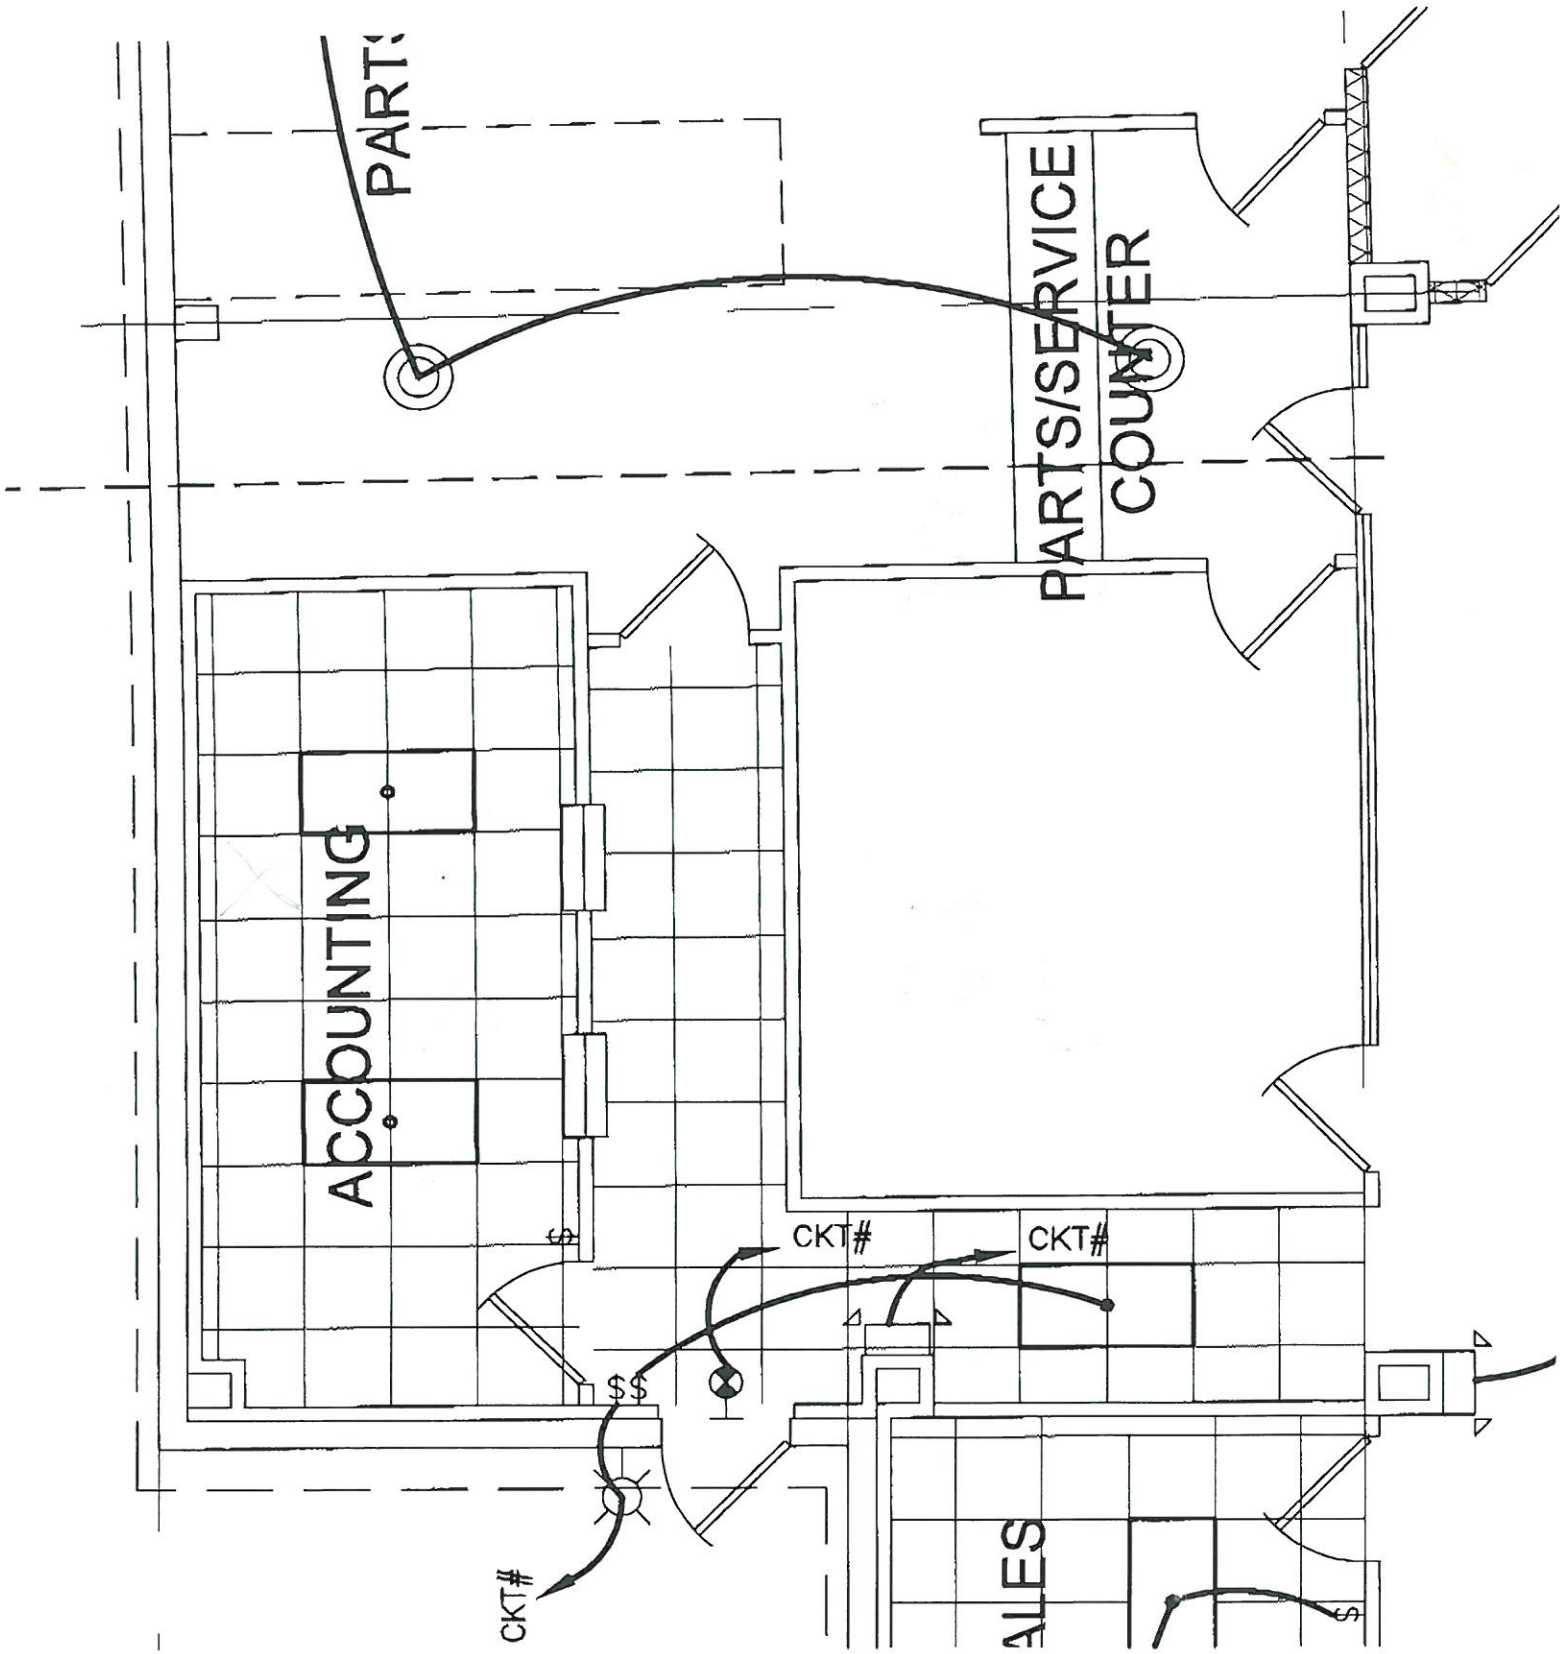

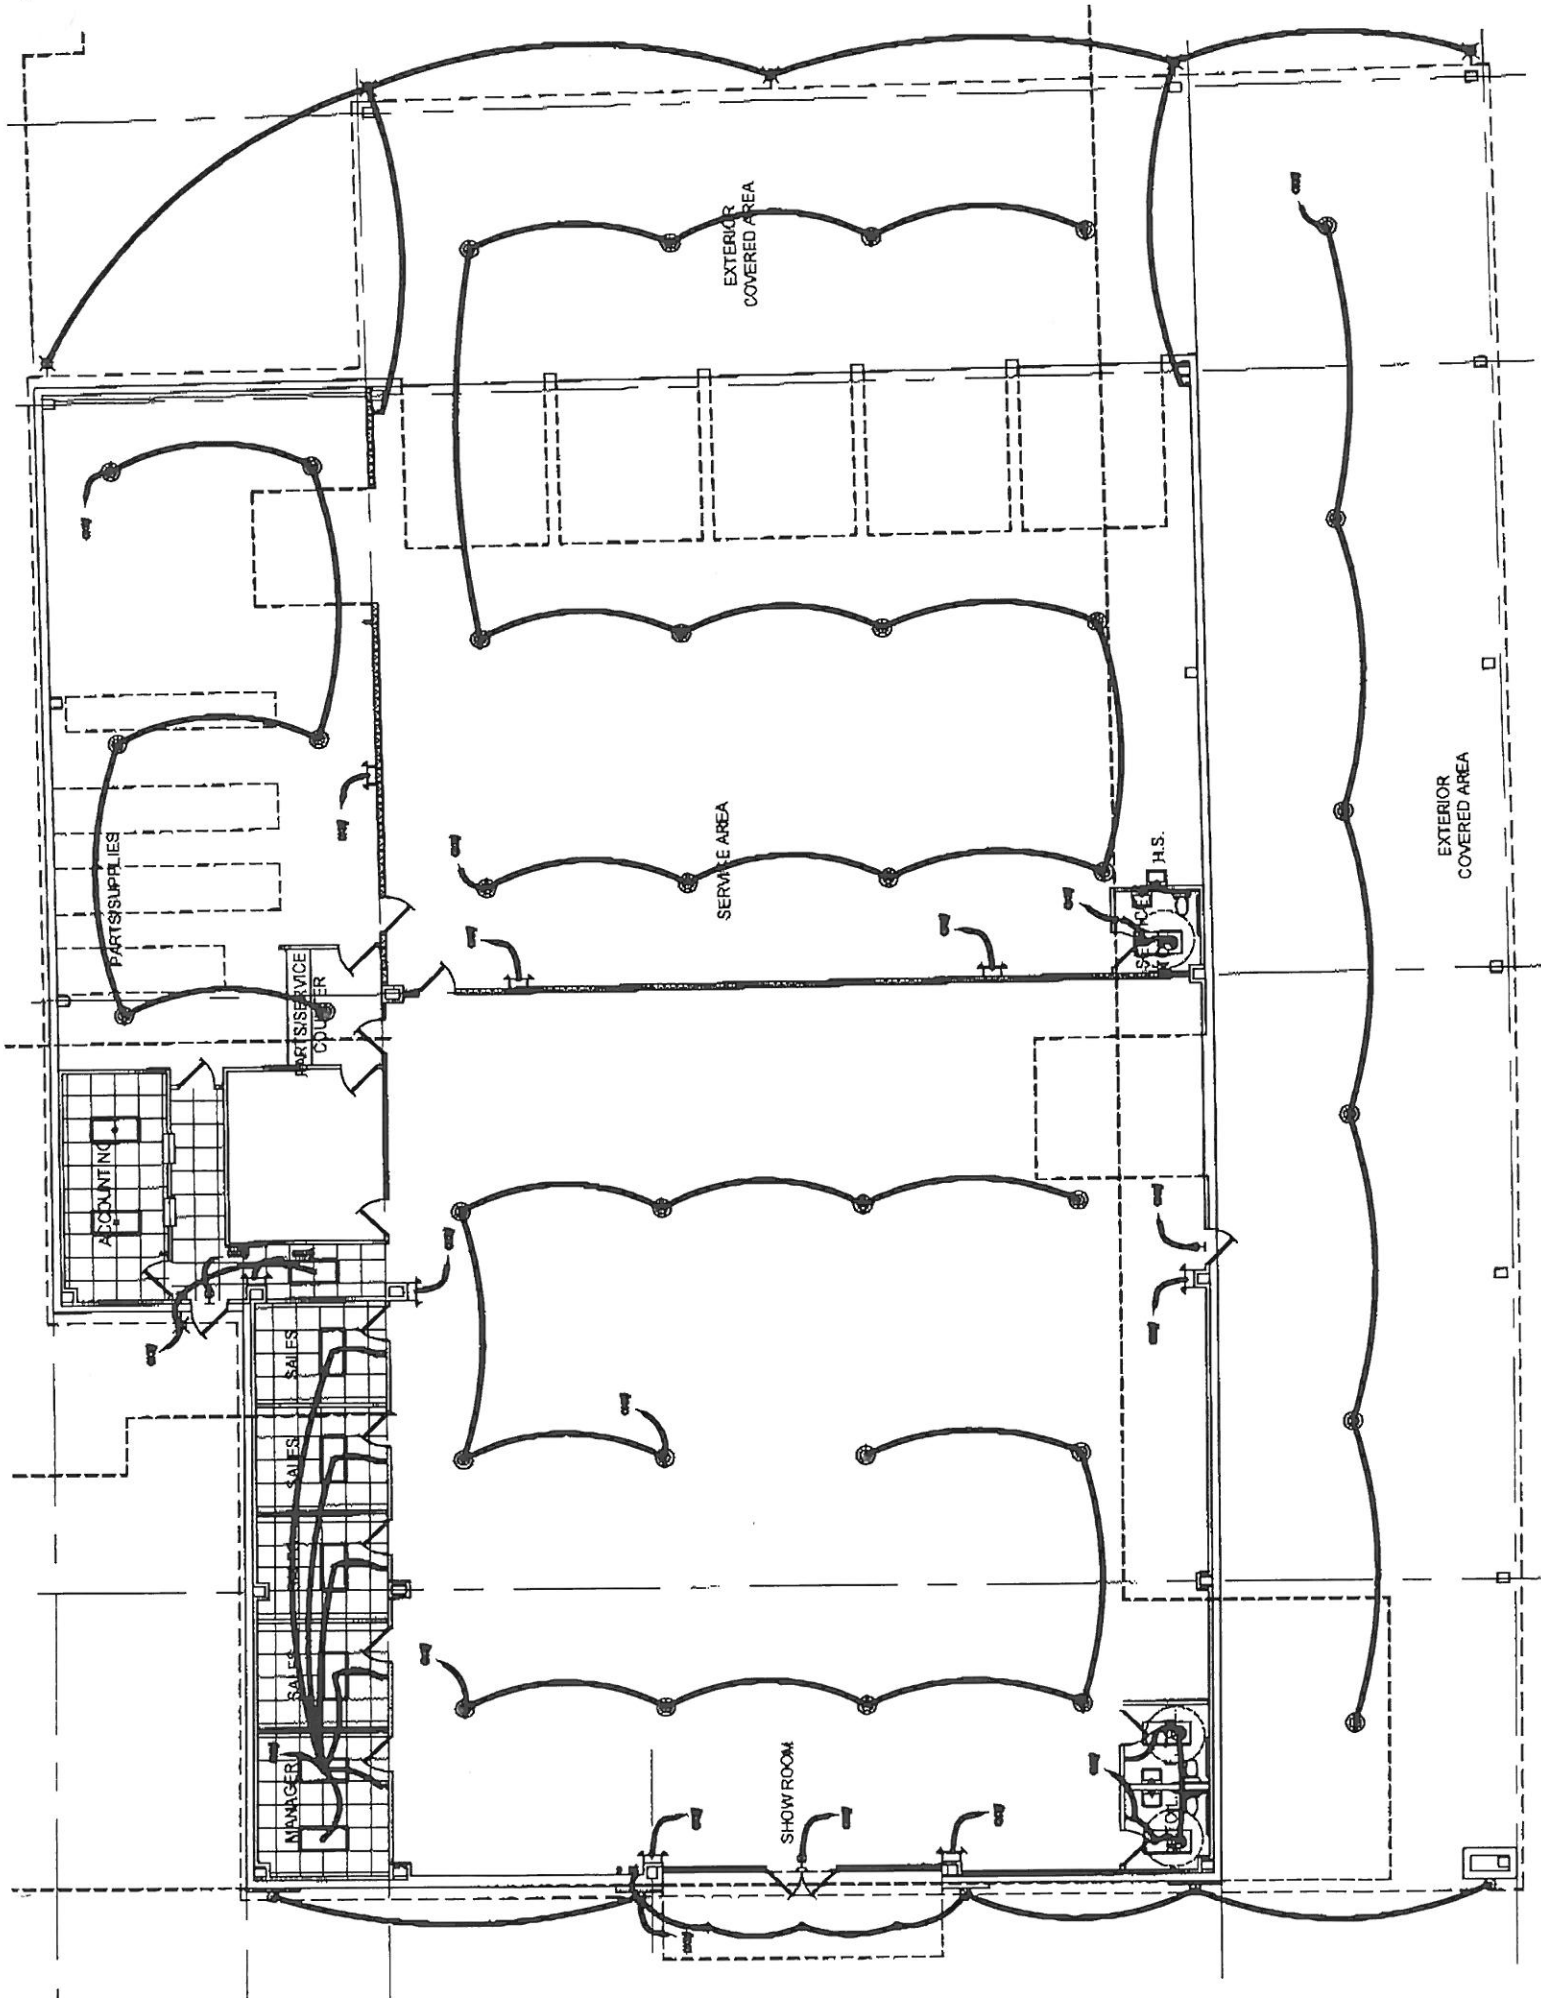

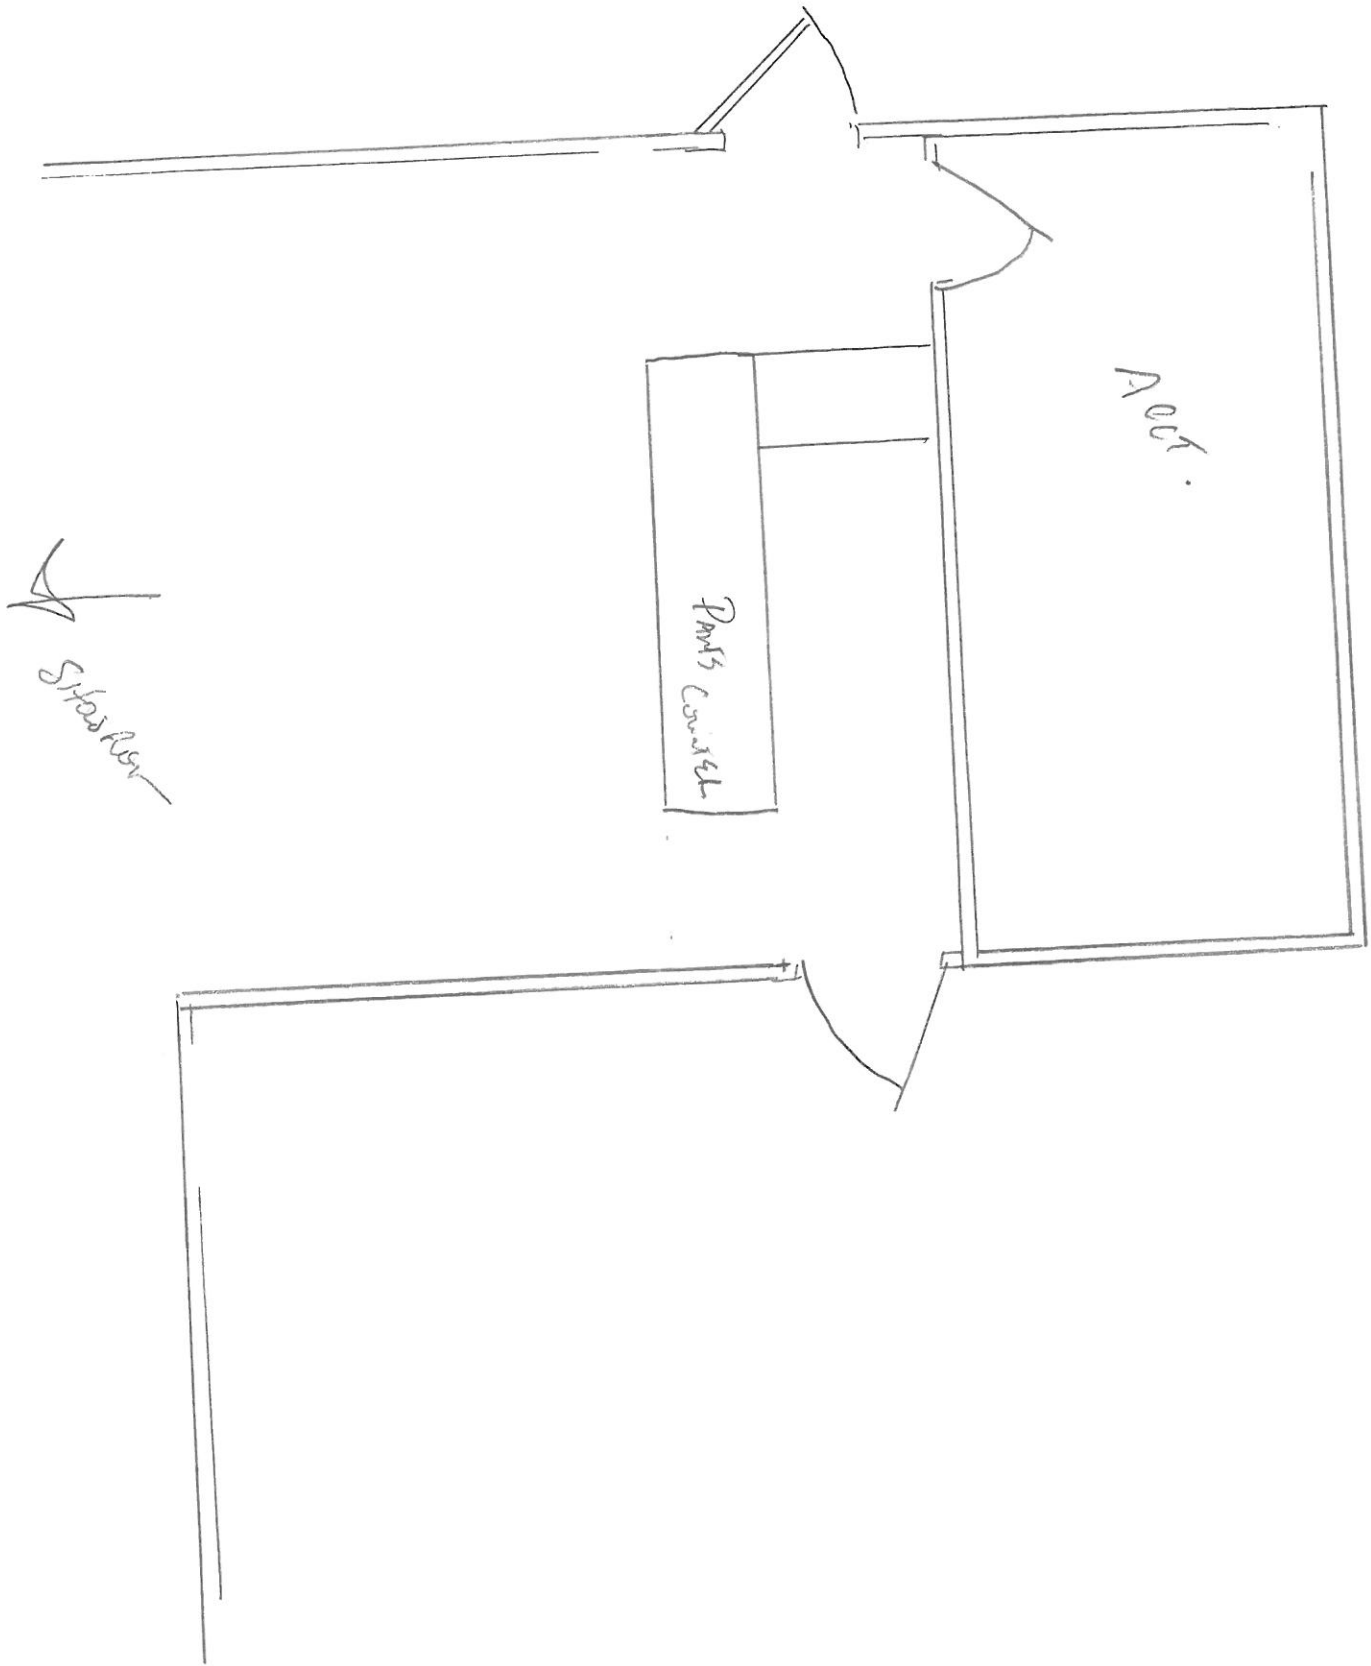

↓
Siberia Ave

Dammon Engineering Inc.

1095 Florida Ave.
Slidell, LA 70458
(985) 649-5832
Fax: (985) 641-5950

FAX COVER SHEET

FAX NUMBER TRANSMITTED TO: 985-624-6847

TO: Dannan Brown To Chuck

FROM: Jennifer Tiffany/Chuck Dammon

CLIENT/MATTER: _____ Danny Br

REFERENCE: _____


DATE: 2-28-07 NO. OF PAGES INCLUDING COVER SHEET: 2

COMMENTS:

Let Chuck know what you want to do.
Thanks,
Jen

SEE ATTACHED

IF YOU EXPERIENCE ANY PROBLEMS RECEIVING THIS FAX, PLEASE CALL (985) 649-5832,
OR FAX (985) 641-5950

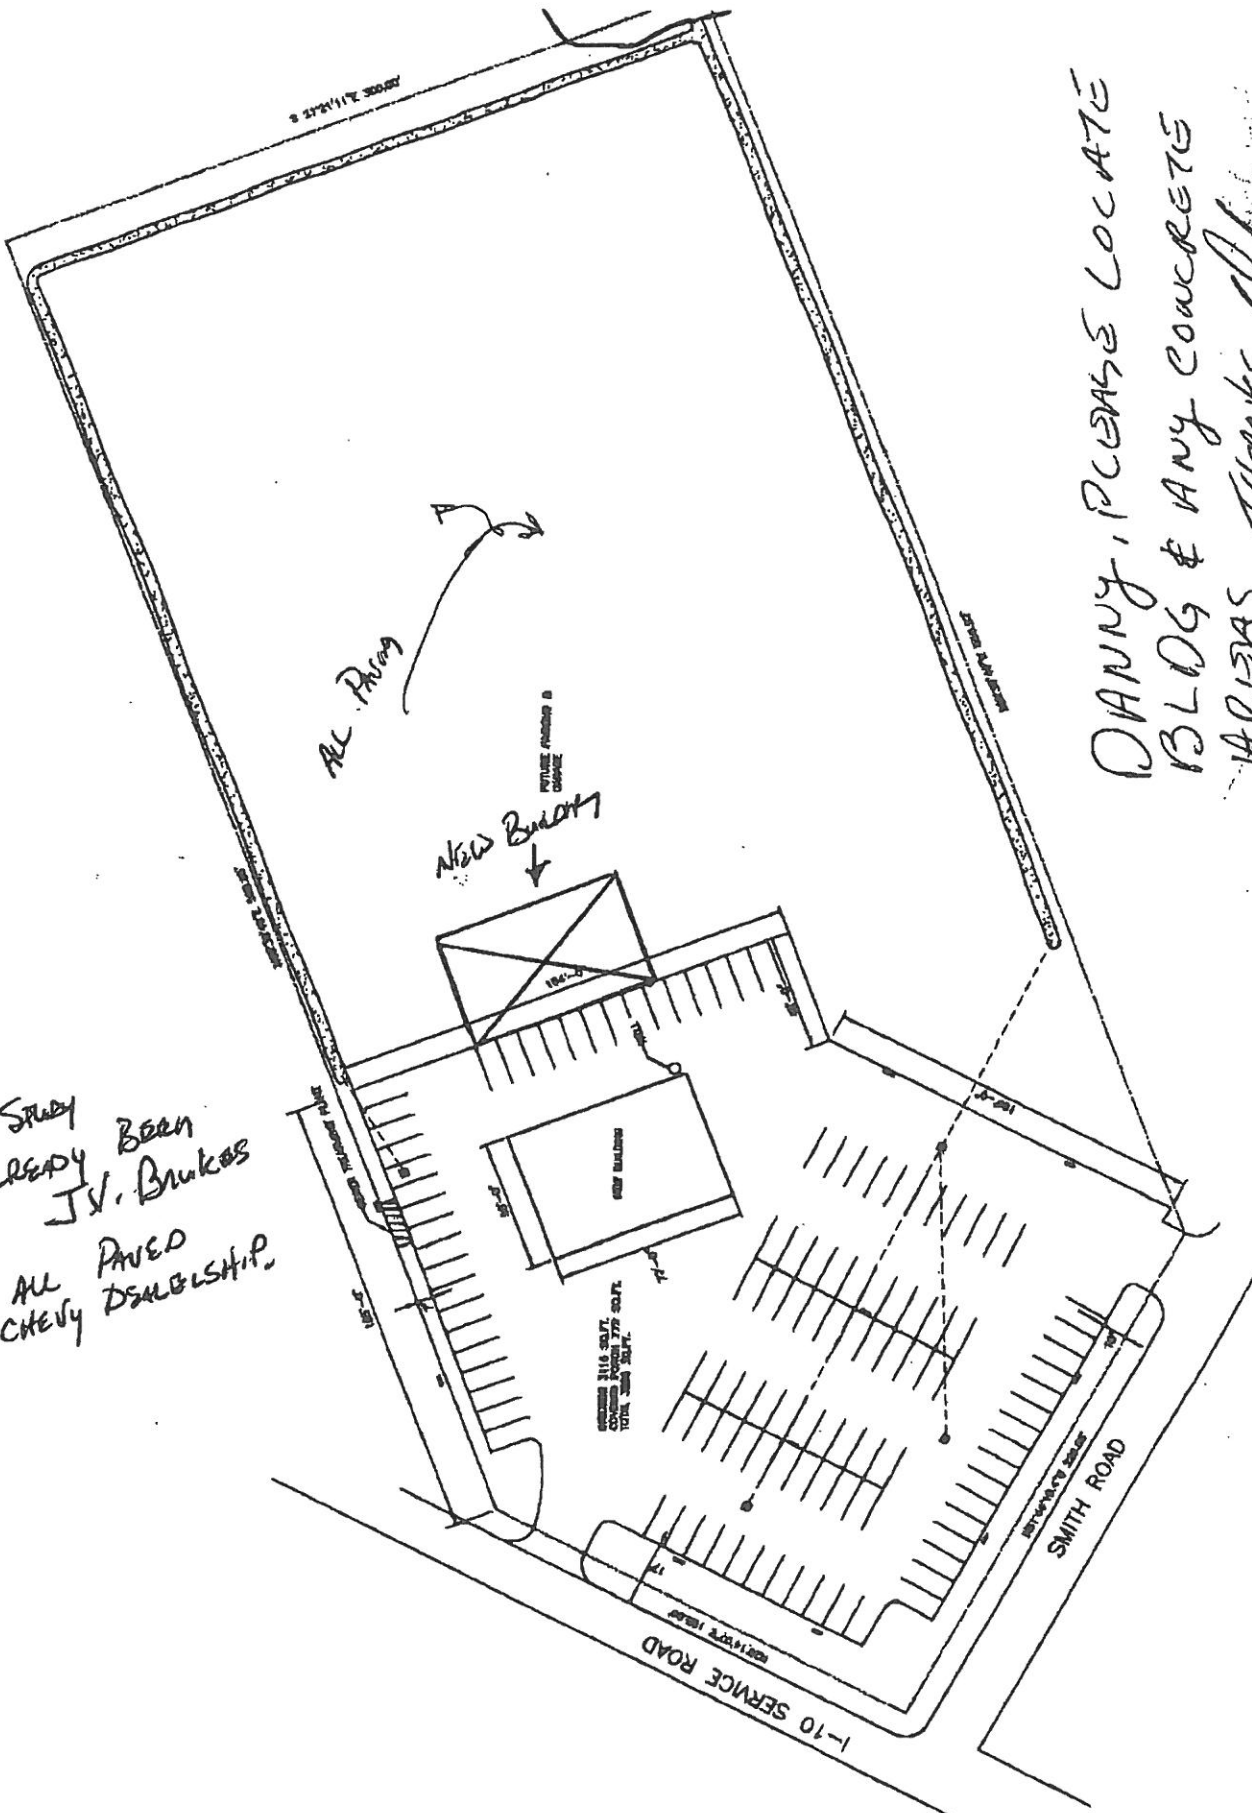

Drainage Study
 HAS ALREADY BEEN
 DONE JV. BRUKAS
 IT IS ALL PAVED
 WITH CHEVY DEALERSHIP.

DANNY, PLEASE LOCATE
 BLDG & ANY CONCRETE
 AREAS. THANKS DANNY

Dammon Engineering Inc.

1095 Florida Ave.
Slidell, LA 70458
(985) 649-5832
Fax: (985) 641-5950

FAX COVER SHEET

FAX NUMBER TRANSMITTED TO: 985-624-6847

TO: Danny Brown

FROM: Jennie Tiffany

CLIENT/MATTER: Northlake Marine

REFERENCE: _____

DATE: Feb. 14, 2007 NO. OF PAGES INCLUDING COVER SHEET: 3


COMMENTS:

Danny,

Here are the requested changes. Please let us know what you think.

Thanks!

IF YOU EXPERIENCE ANY PROBLEMS RECEIVING THIS FAX, PLEASE CALL (985) 649-5832,
OR FAX (985) 641-5950

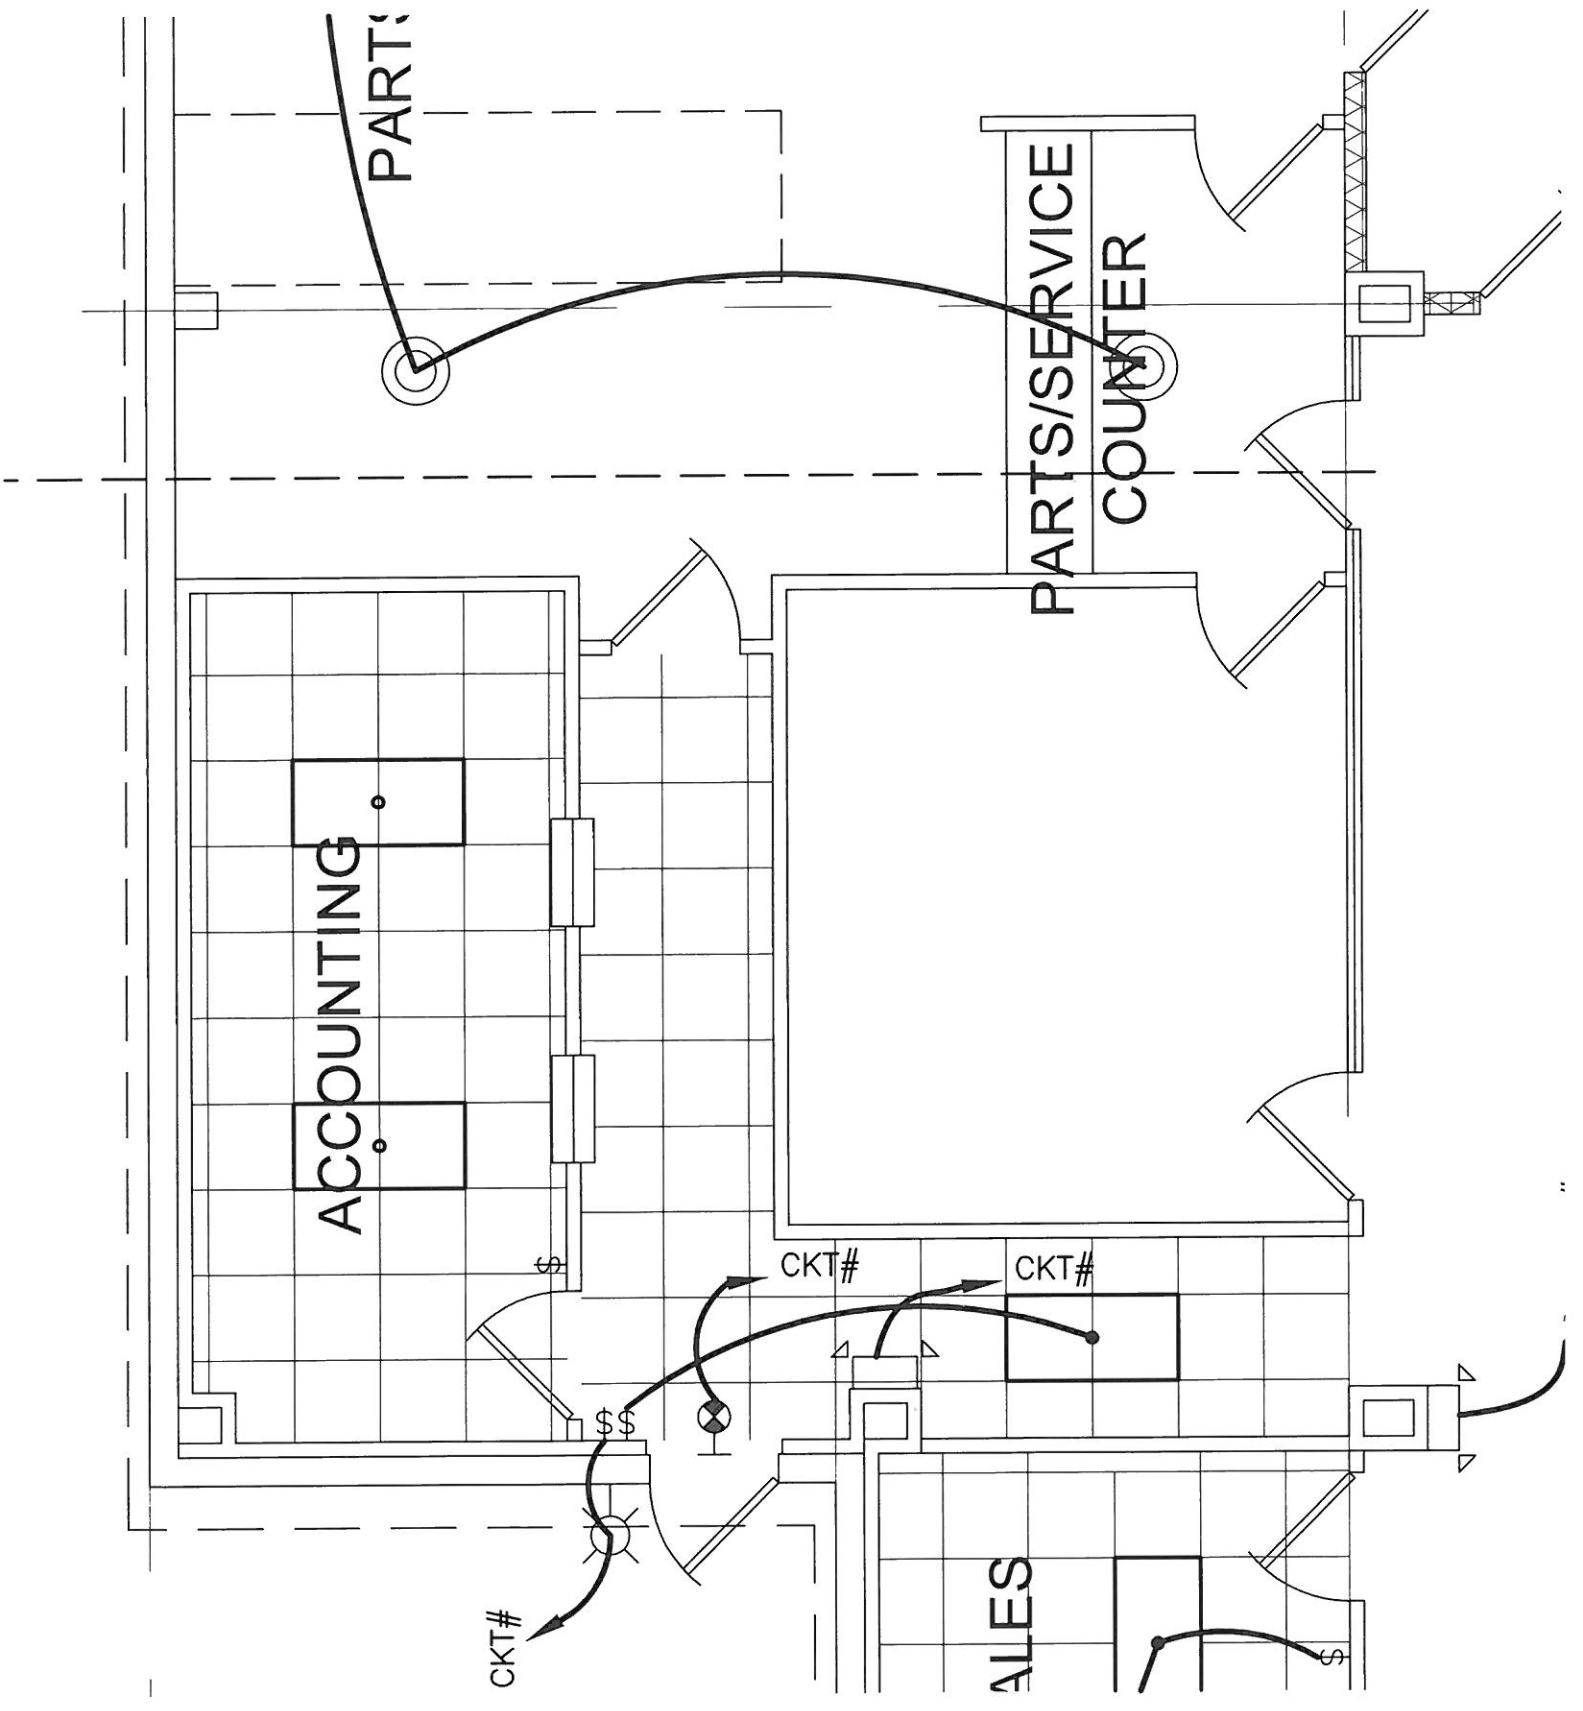

Dammon Engineering Inc.

1095 Florida Ave.
Slidell, LA 70458
(985) 649-5832
Fax: (985) 641-5950

FAX COVER SHEET

FAX NUMBER TRANSMITTED TO: 985-624-6847

TO: Danny Brown

FROM: Jennie Tiffany

CLIENT/MATTER: _____

REFERENCE: Northlake Marine

DATE: 2-27-07 NO. OF PAGES INCLUDING COVER SHEET: 2

COMMENTS: _____

Danny,


Please look at these changes rather than
the fax earlier today. I forgot to
remove the door and extend the wall.
Sorry about that.

Let us know what you think!

Thanks!

Jennie

IF YOU EXPERIENCE ANY PROBLEMS RECEIVING THIS FAX, PLEASE CALL (985) 649-5832,
OR FAX (985) 641-5950

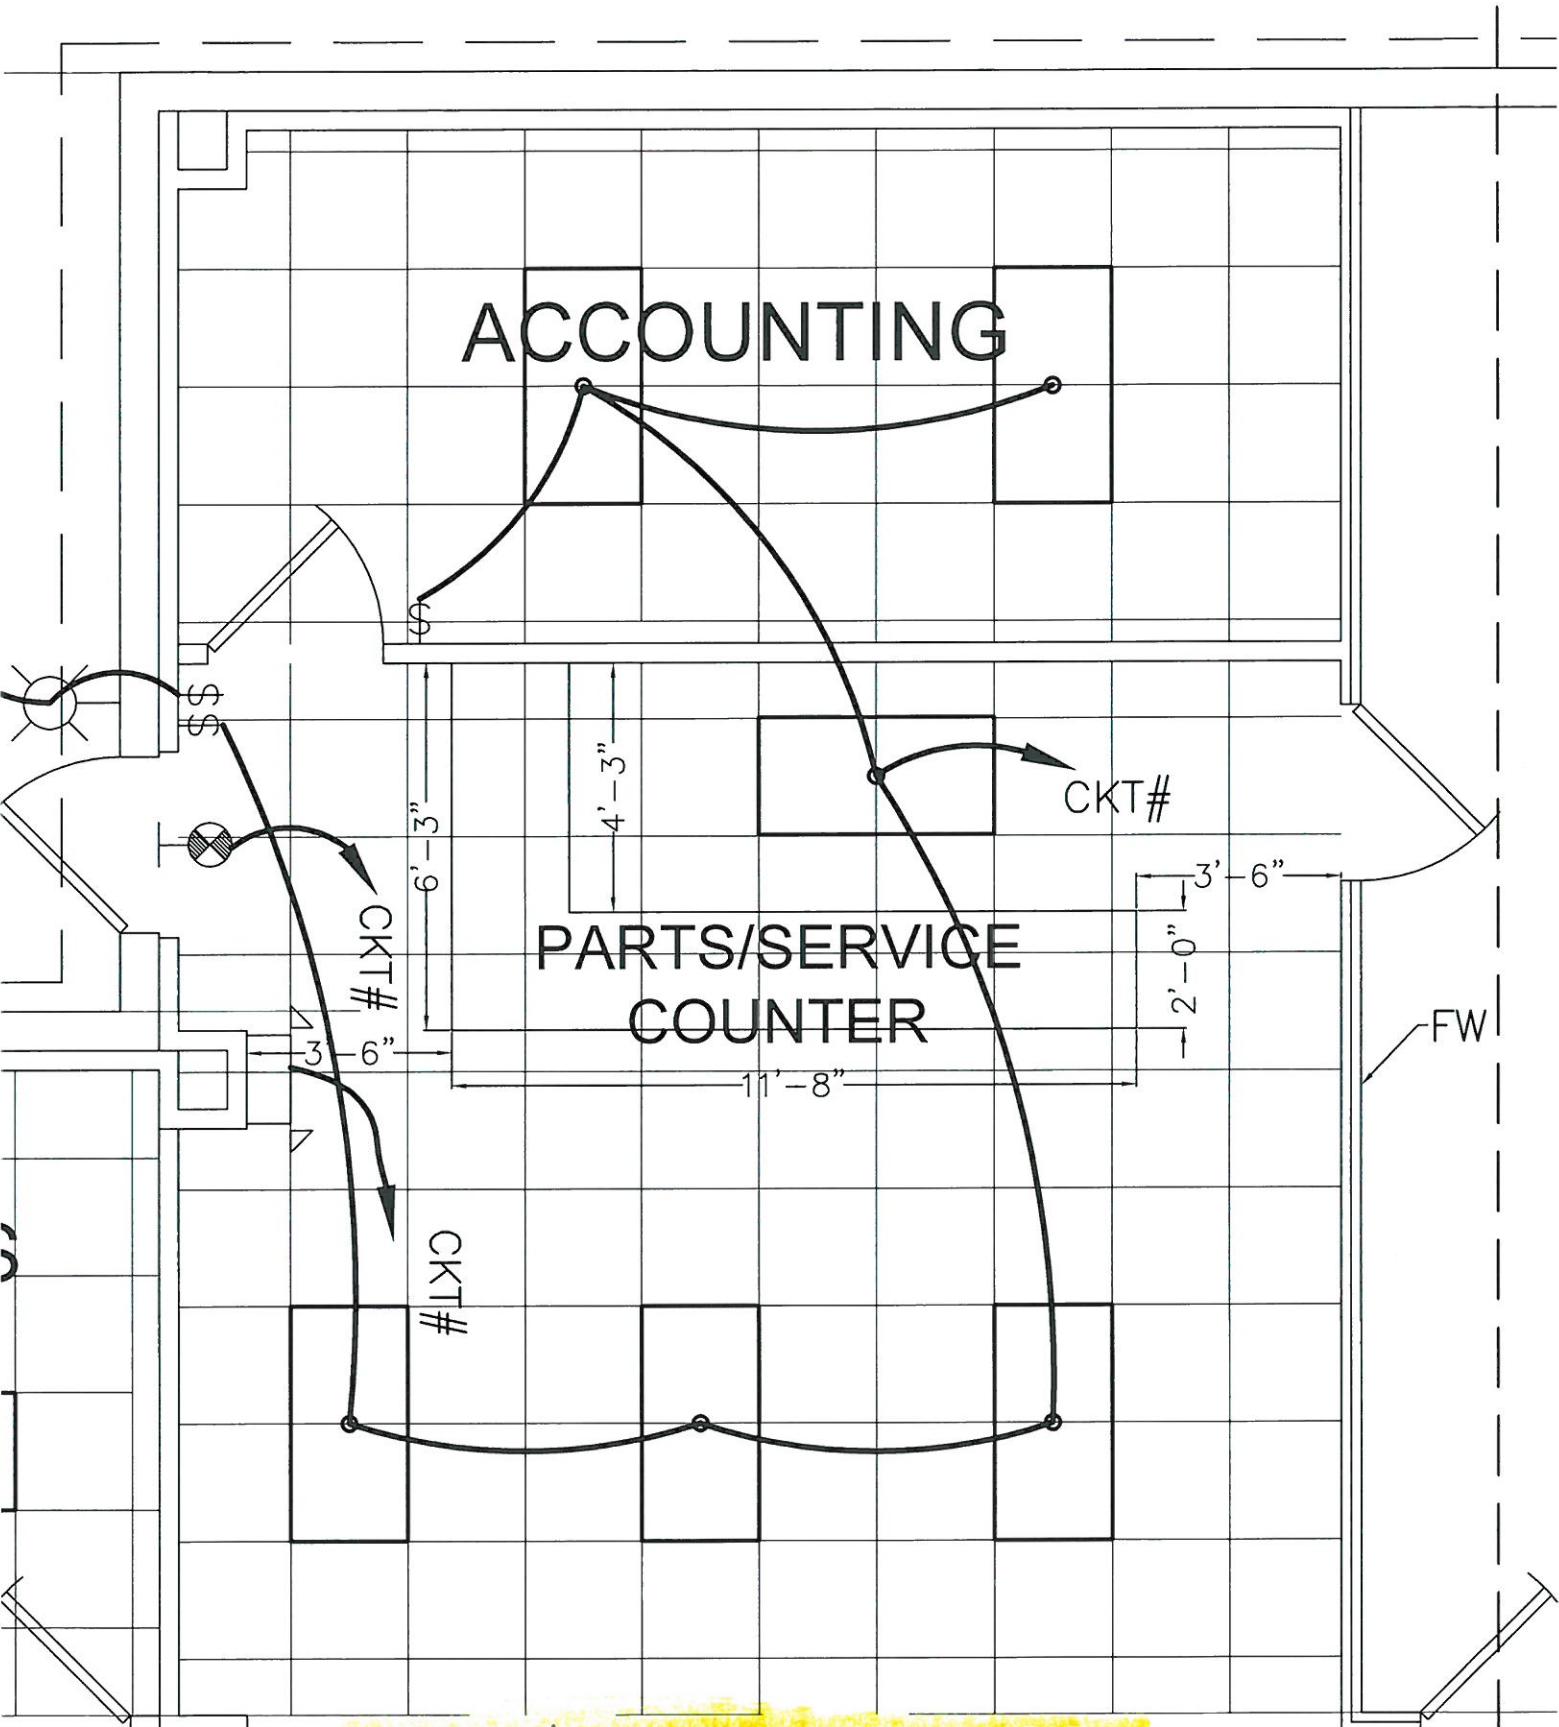

*Talked w/ Danny 3-1-07 2:30pm
 He wants to go with
 this layout.

Dammon Engineering Inc.

1095 Florida Ave.
Slidell, LA 70458
(985) 649-5832
Fax: (985) 641-5950

FAX COVER SHEET

FAX NUMBER TRANSMITTED TO: 985-624-6847
TO: Danny Brown
FROM: Jennie Tiffany
CLIENT/MATTER: _____
REFERENCE: Northlake Marine
DATE: 2-27-07 NO. OF PAGES INCLUDING COVER SHEET: 2

COMMENTS:


Danny,

Please look at these changes rather than
the fax earlier today. I forgot to
remove the door and extend the wall.
Sorry about that.

Let us know what you think!

Thanks!

Jennie

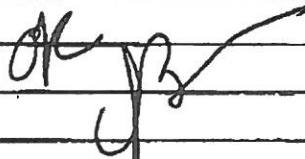

IF YOU EXPERIENCE ANY PROBLEMS RECEIVING THIS FAX, PLEASE CALL (985) 649-5832,
OR FAX (985) 641-5950

