


Elwin
 Hubcap Tire & Wheel (Debbie Hudson)
 Job 1853

502-9558
 Fax 645-9164
 Ofc. 985-641-5298
 Cell. 504-234-6957

Alonso - Ofc. 504-835-8779 Cell. 504-570-0693 Fax (Alonso) 504-835-5159

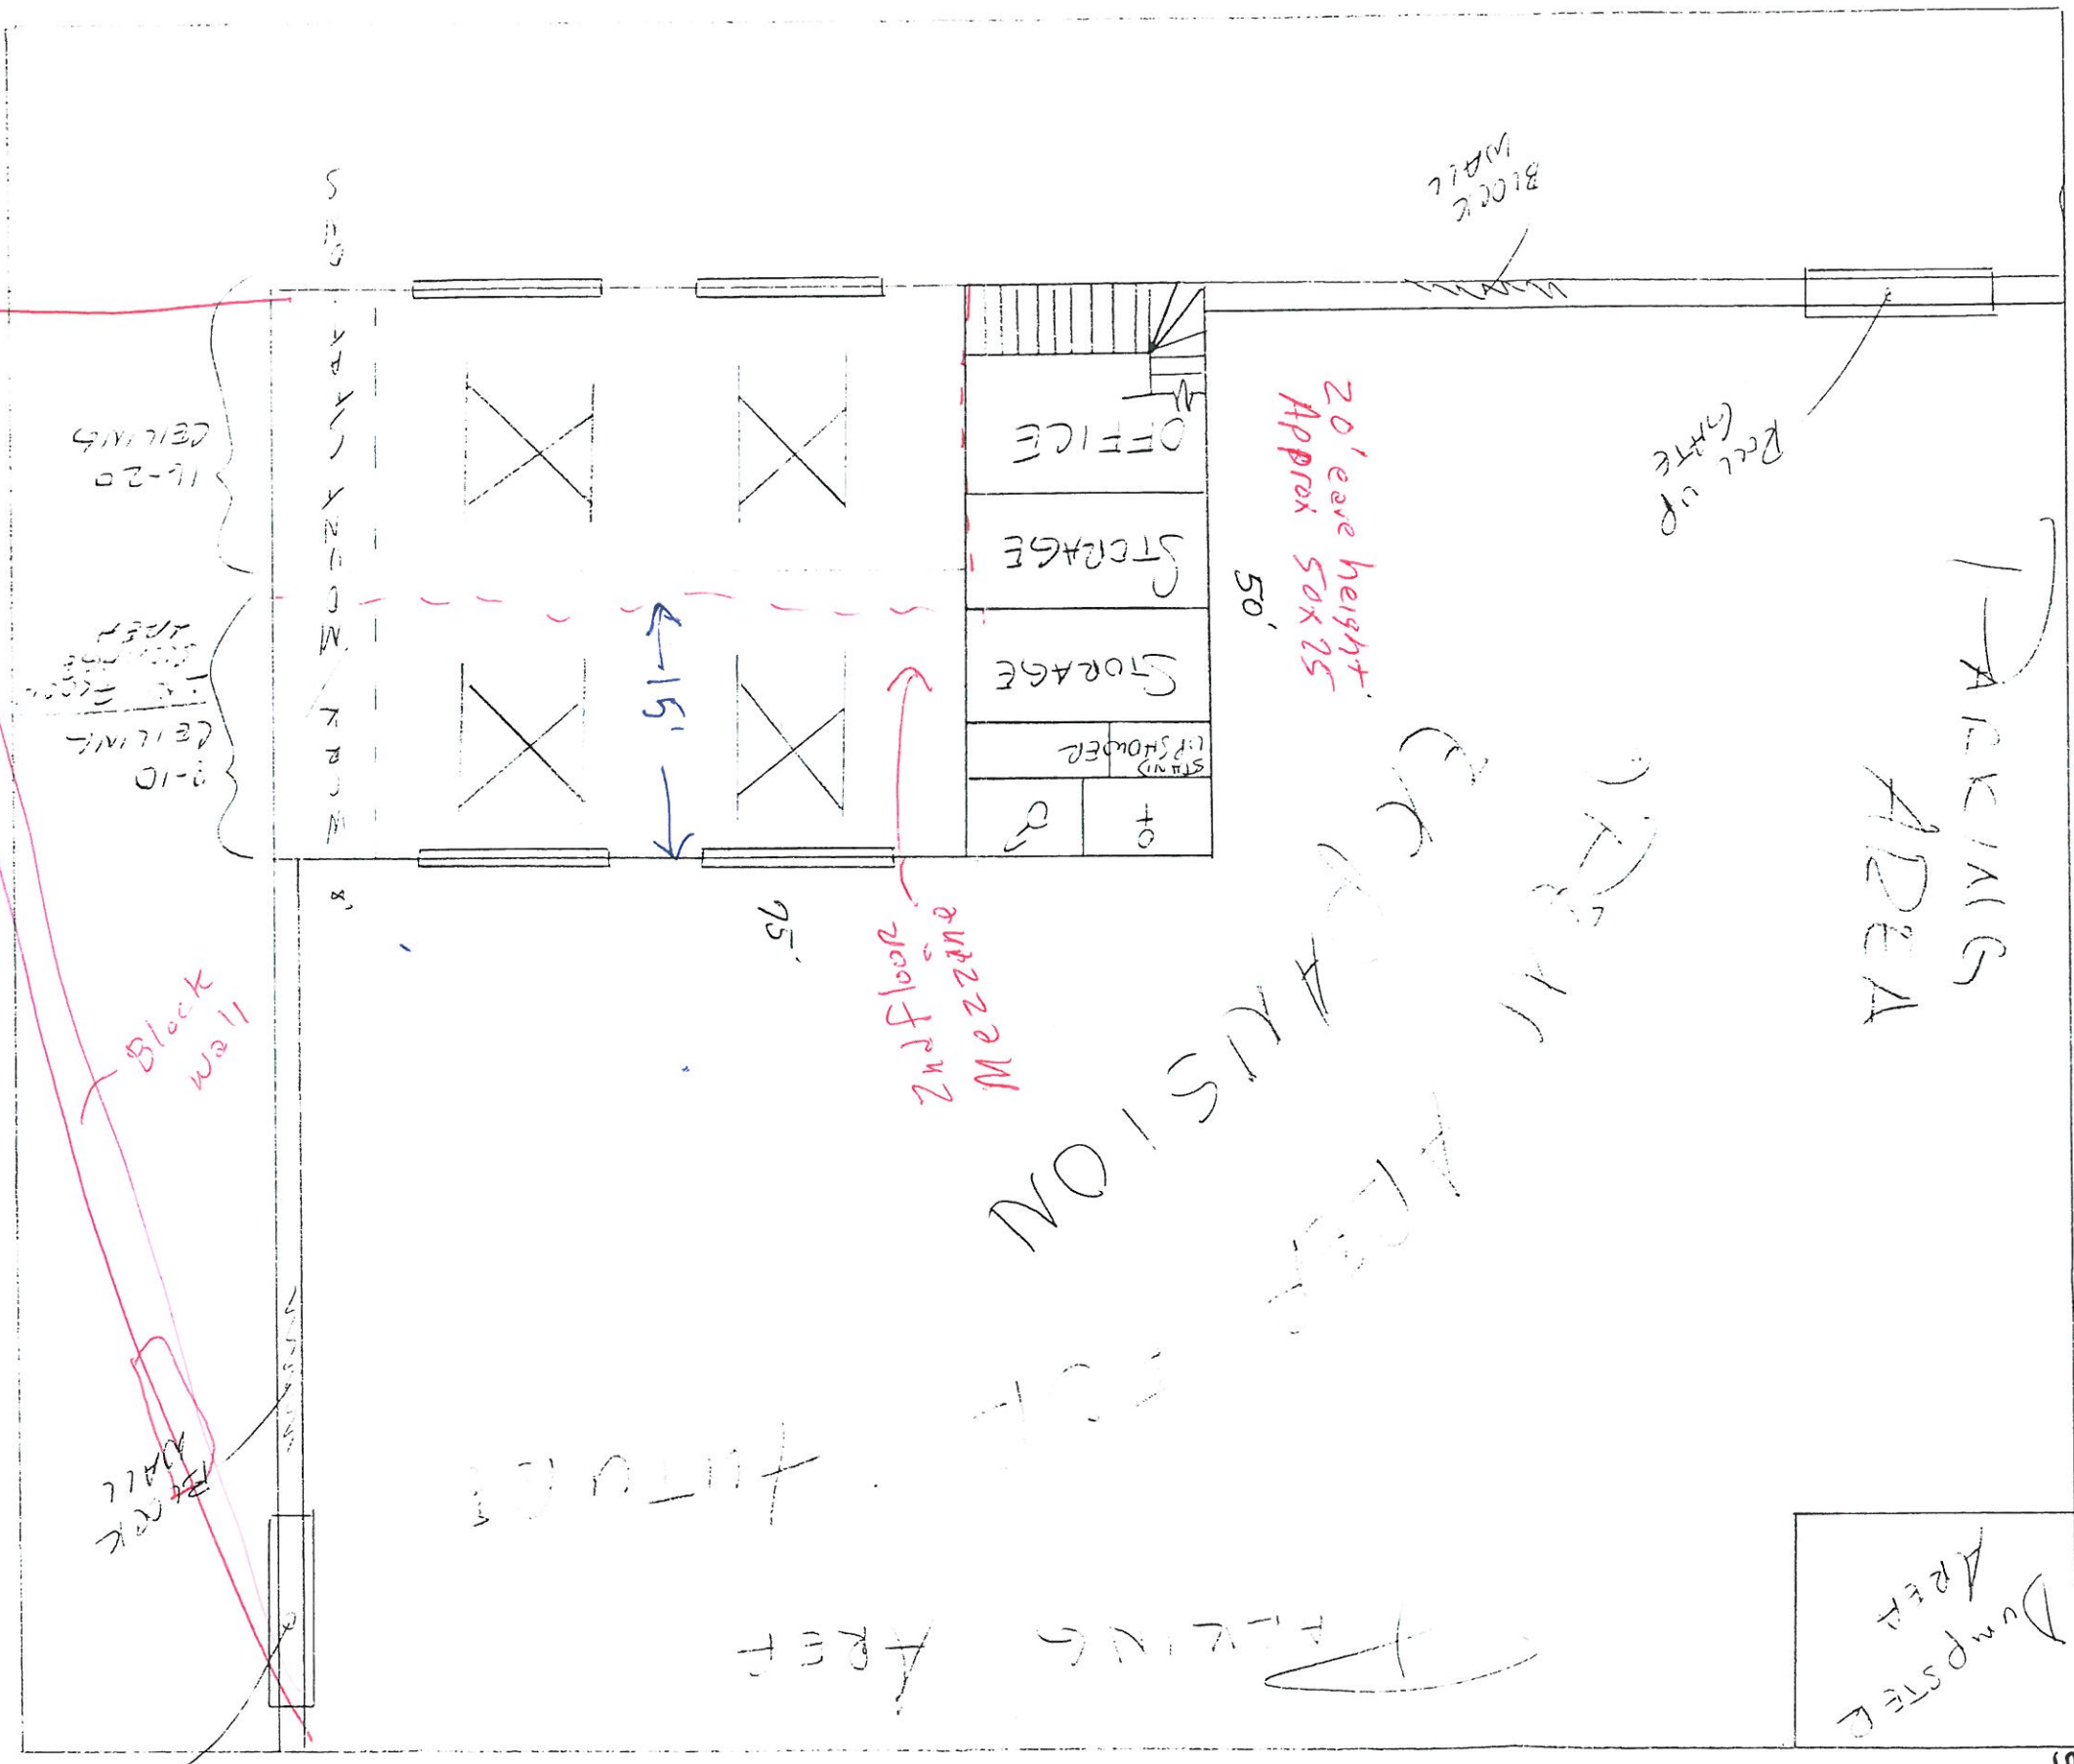

18" bar joists (truss)

JEFFERSON Highway