




1 TYPICAL WALL SECTION  
A-10 THRU A-15

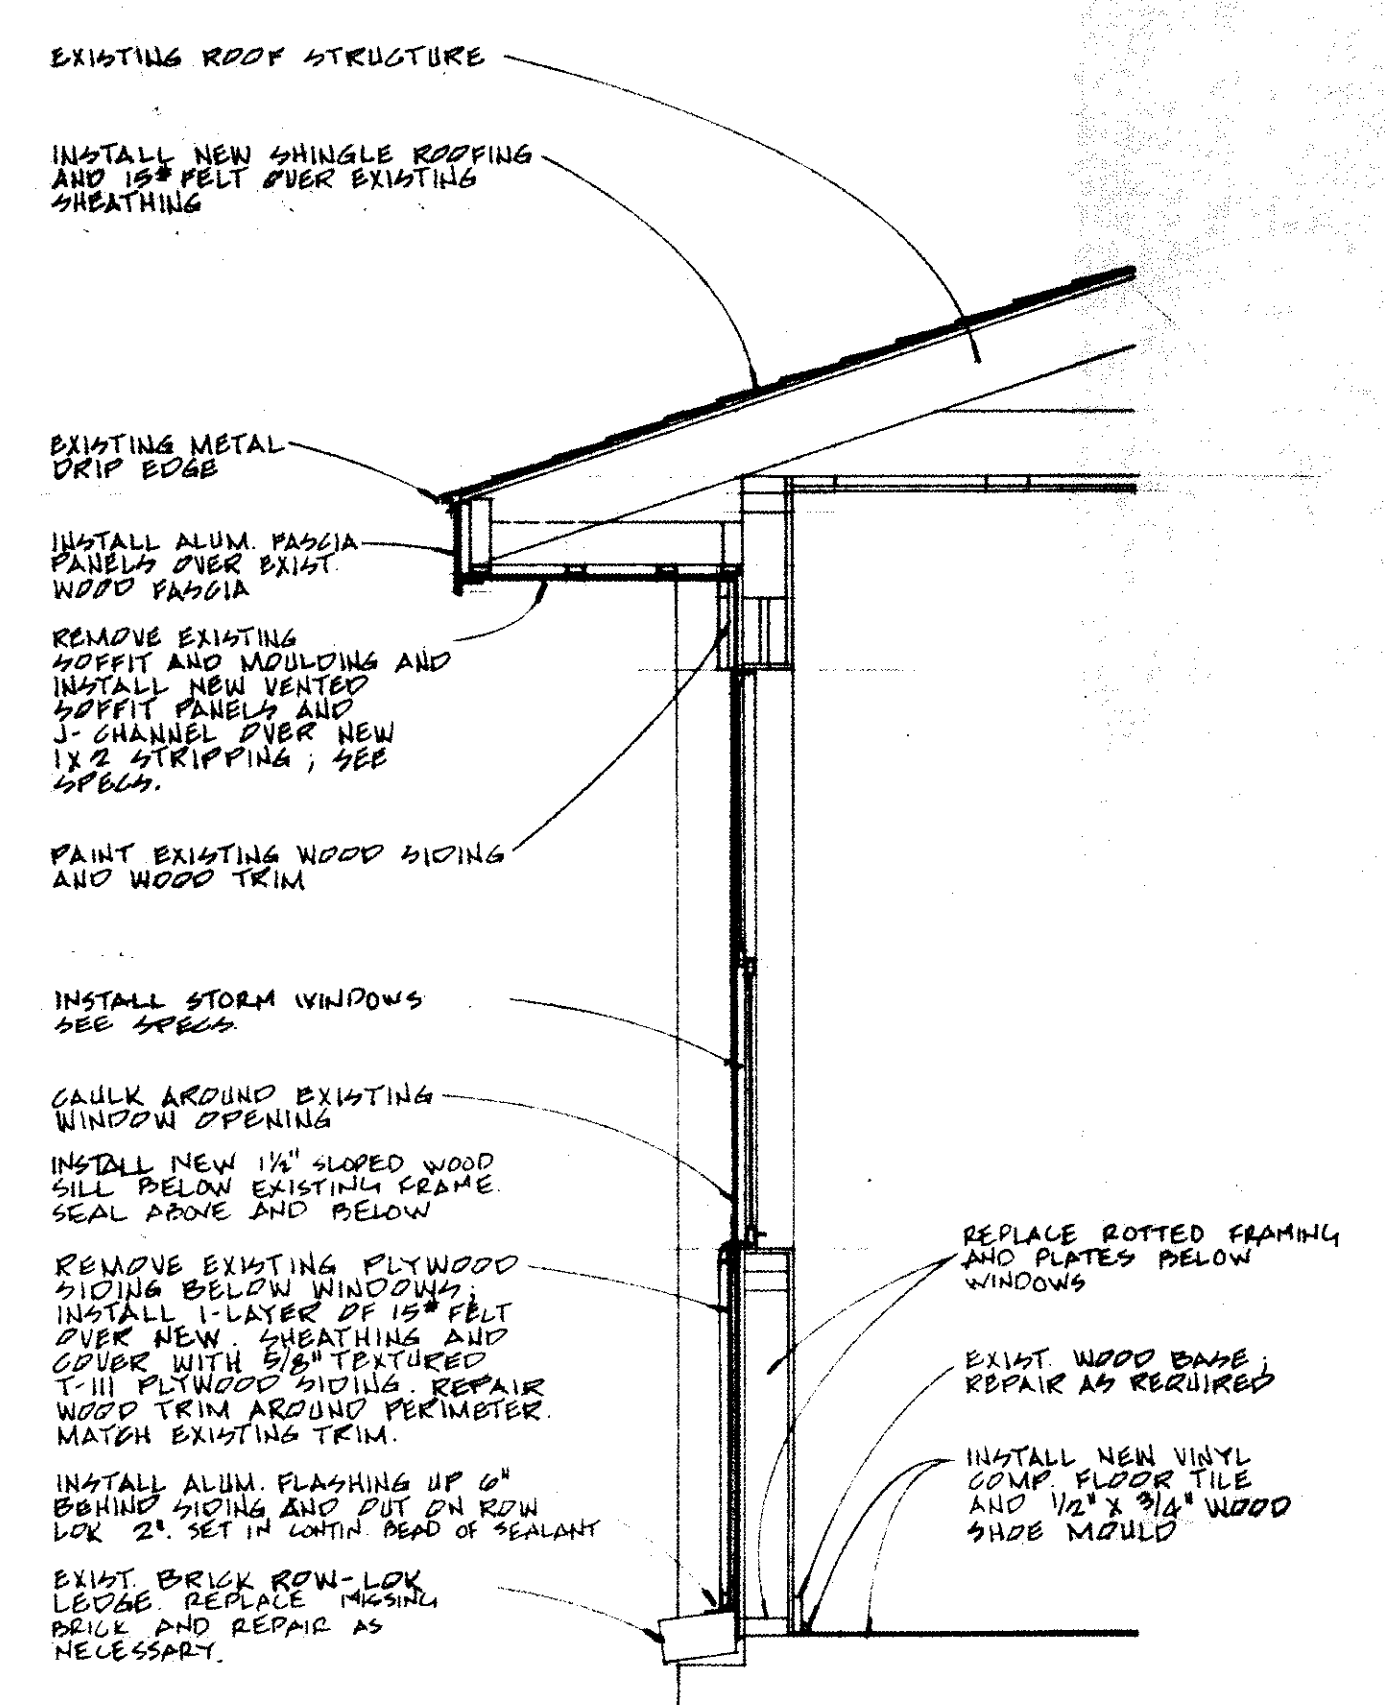


2 TYPICAL WALL SECTION AT WINDOWS  
A-10 THRU A-15

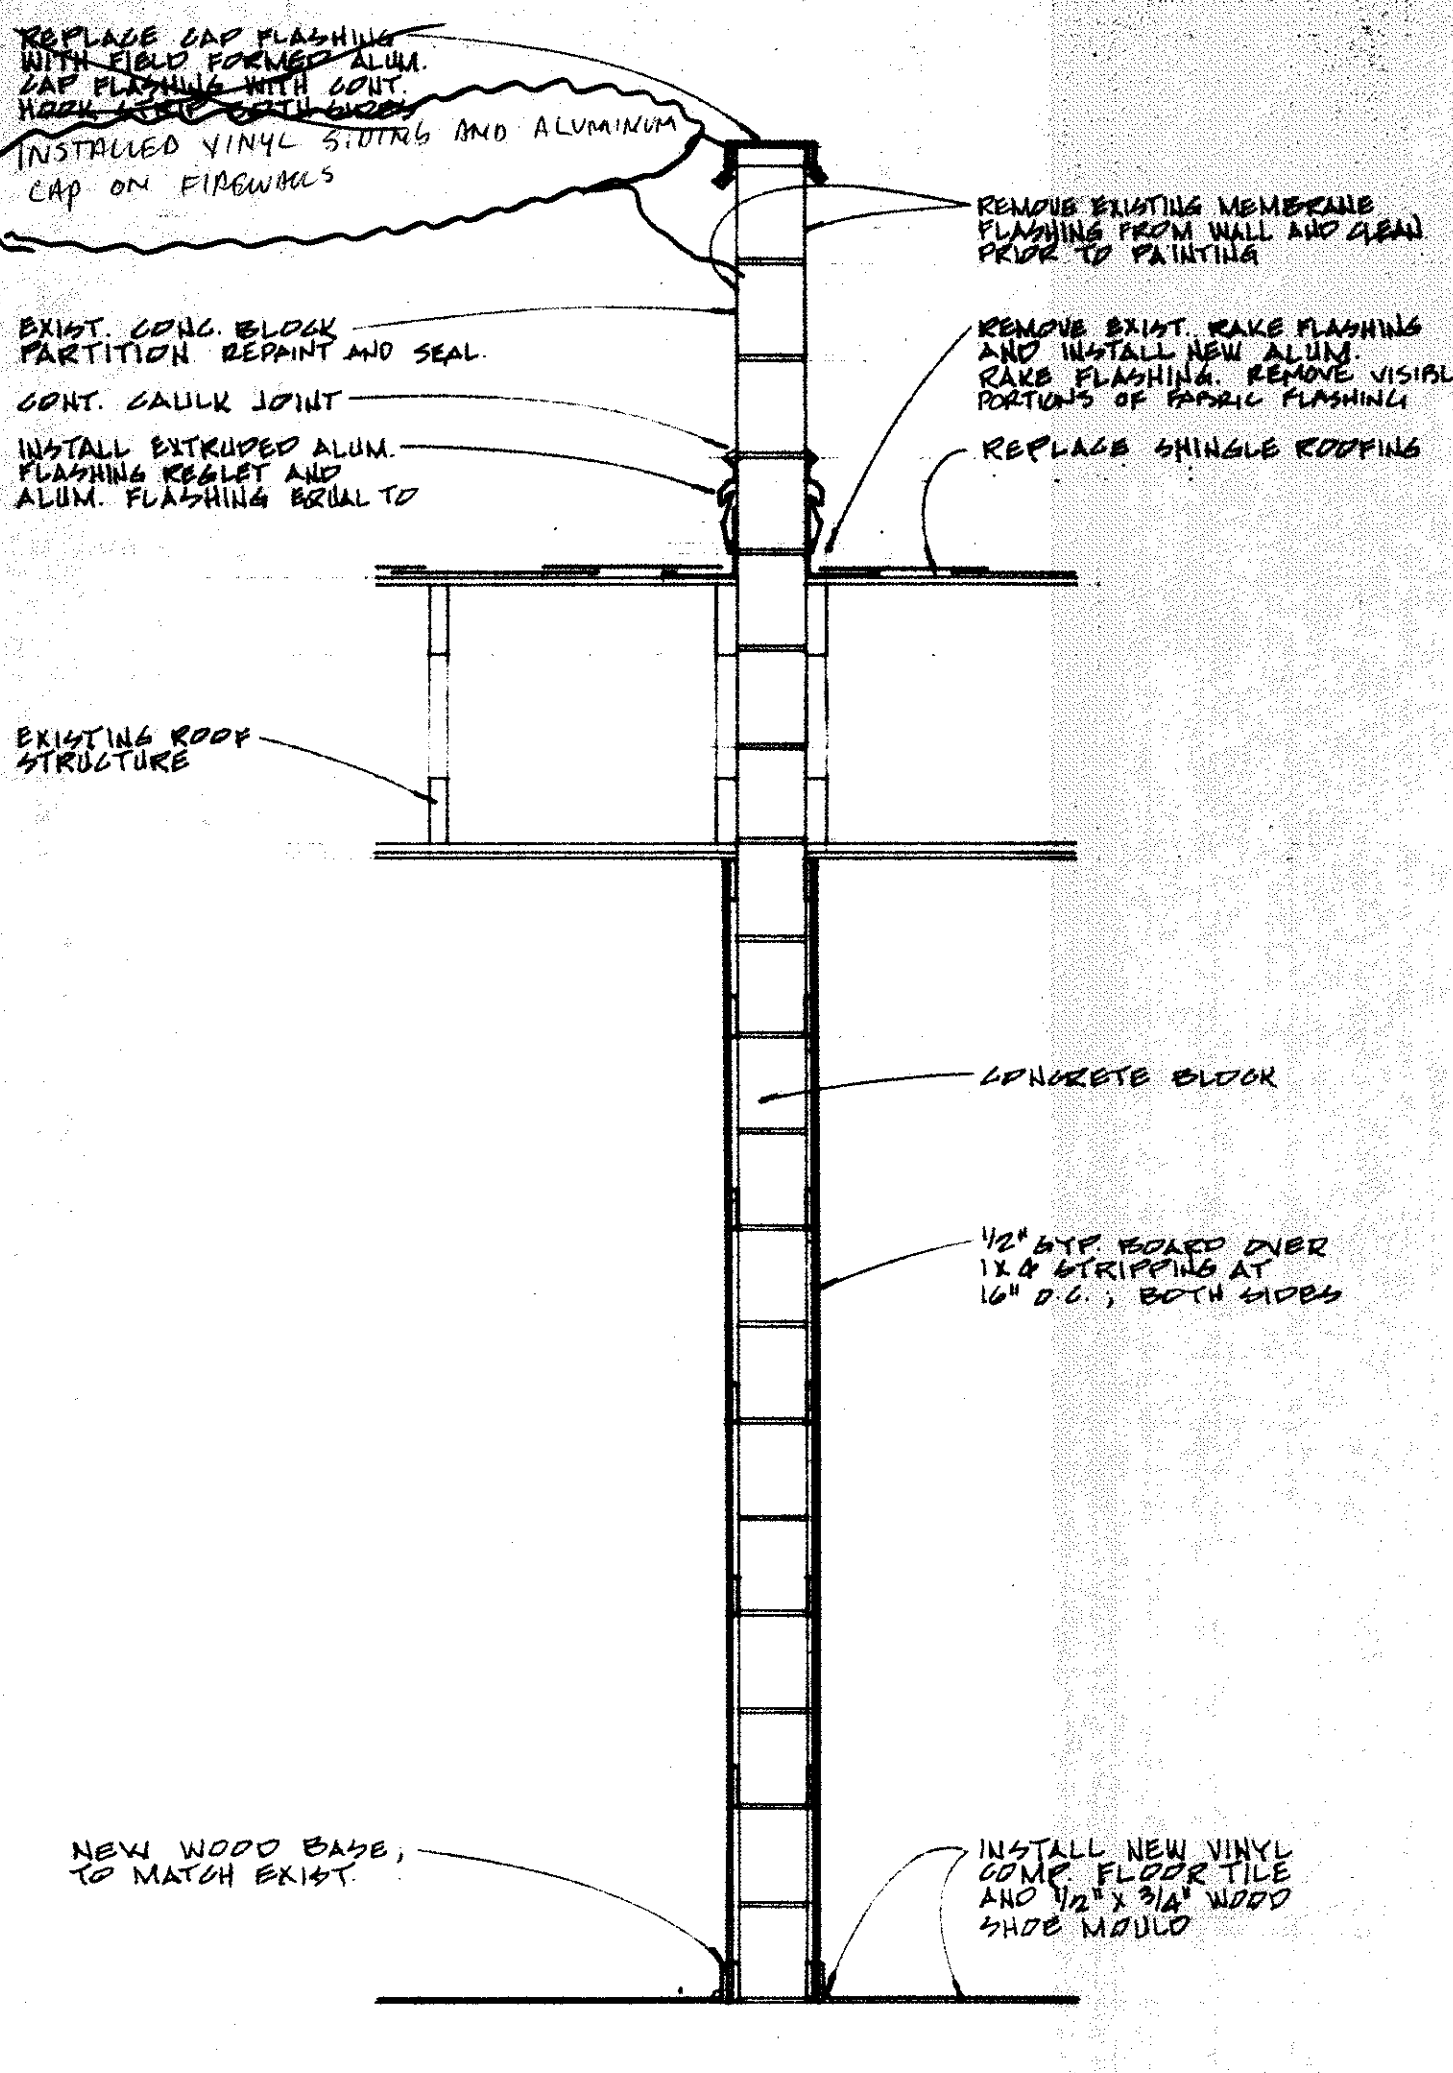


3 TYPICAL SECTION AT FIREWALL  
A-4, A-5

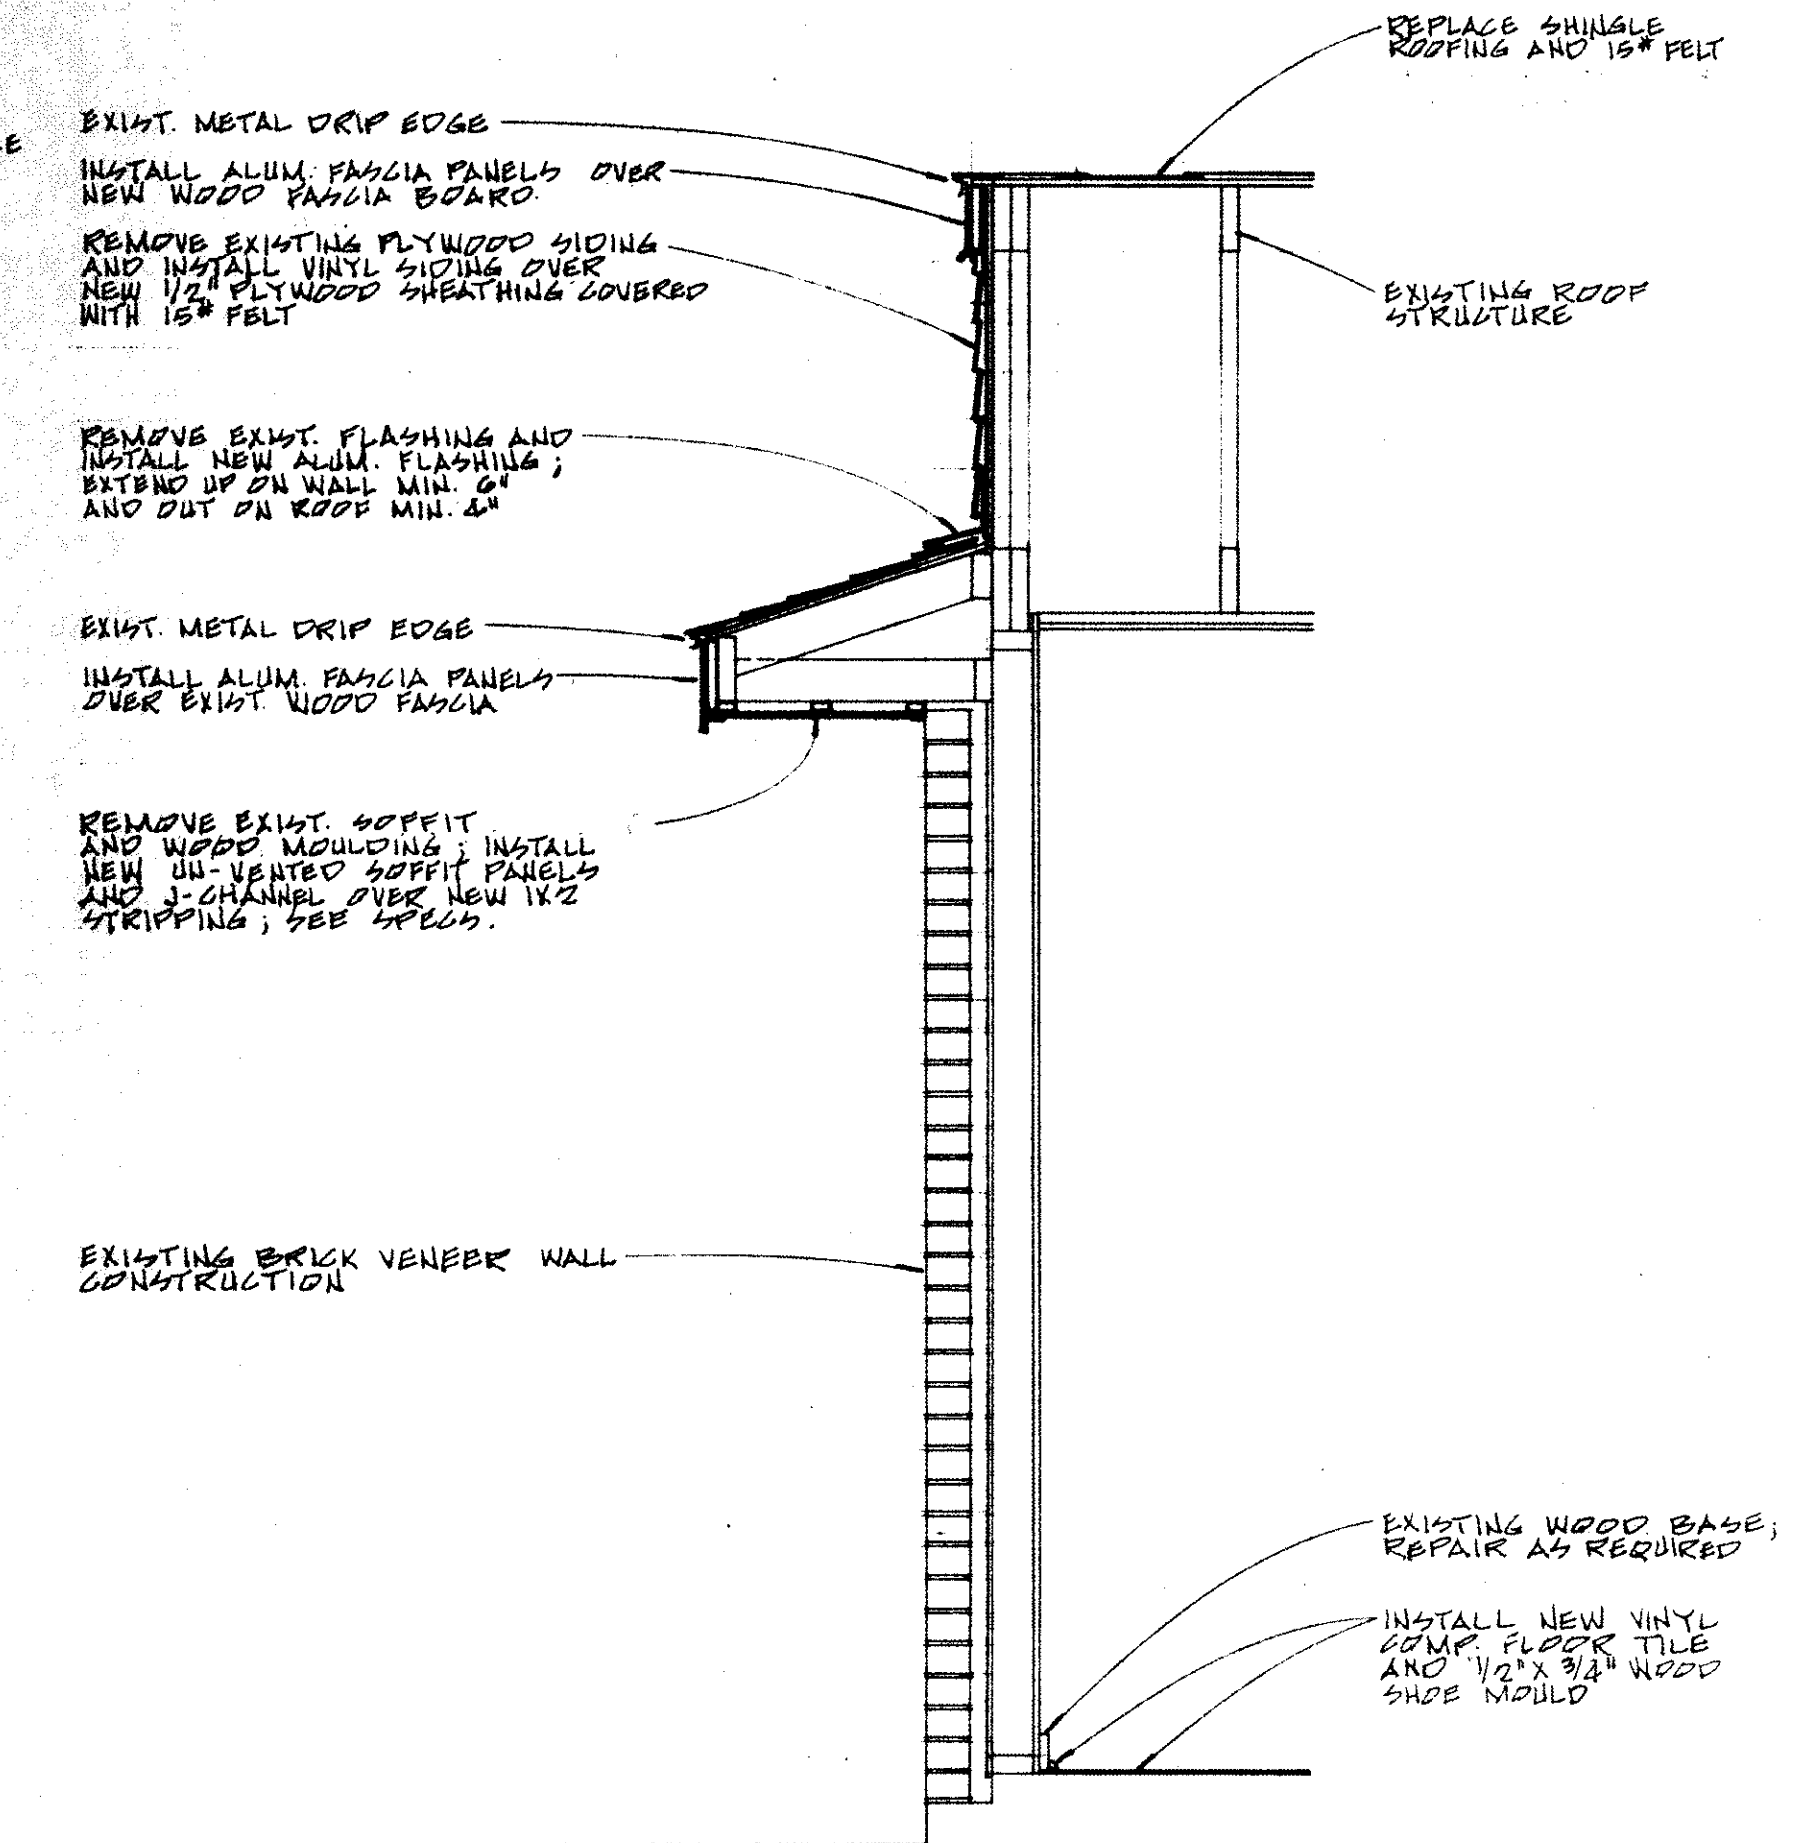


4 TYPICAL SECTION AT GABLES  
A-10 THRU A-15

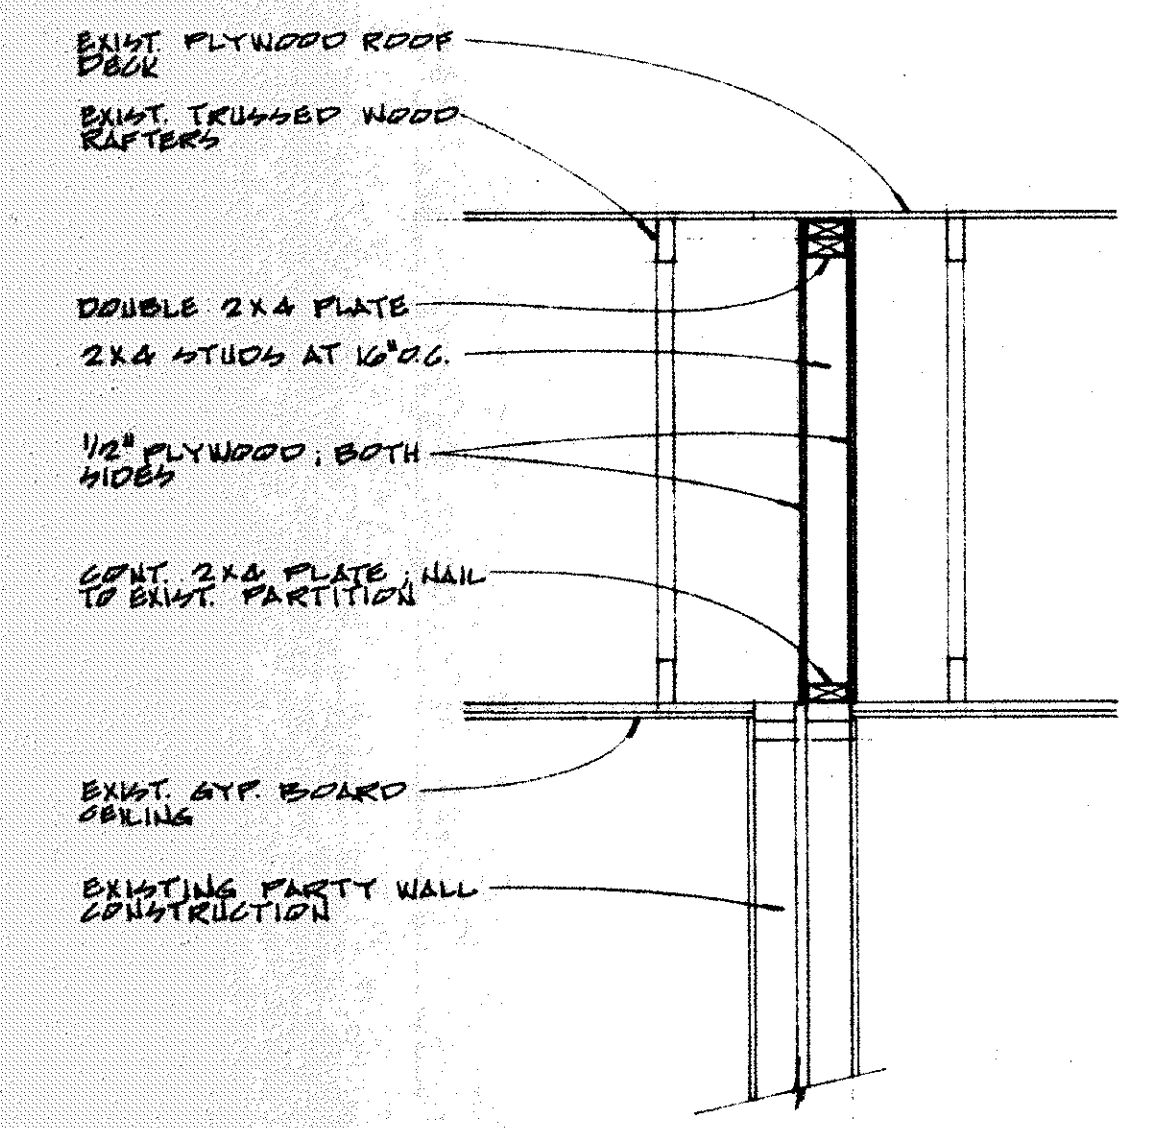


5 SECT. AT ATTIC CLOSURE BETWEEN APT.  
A-10 THRU A-12

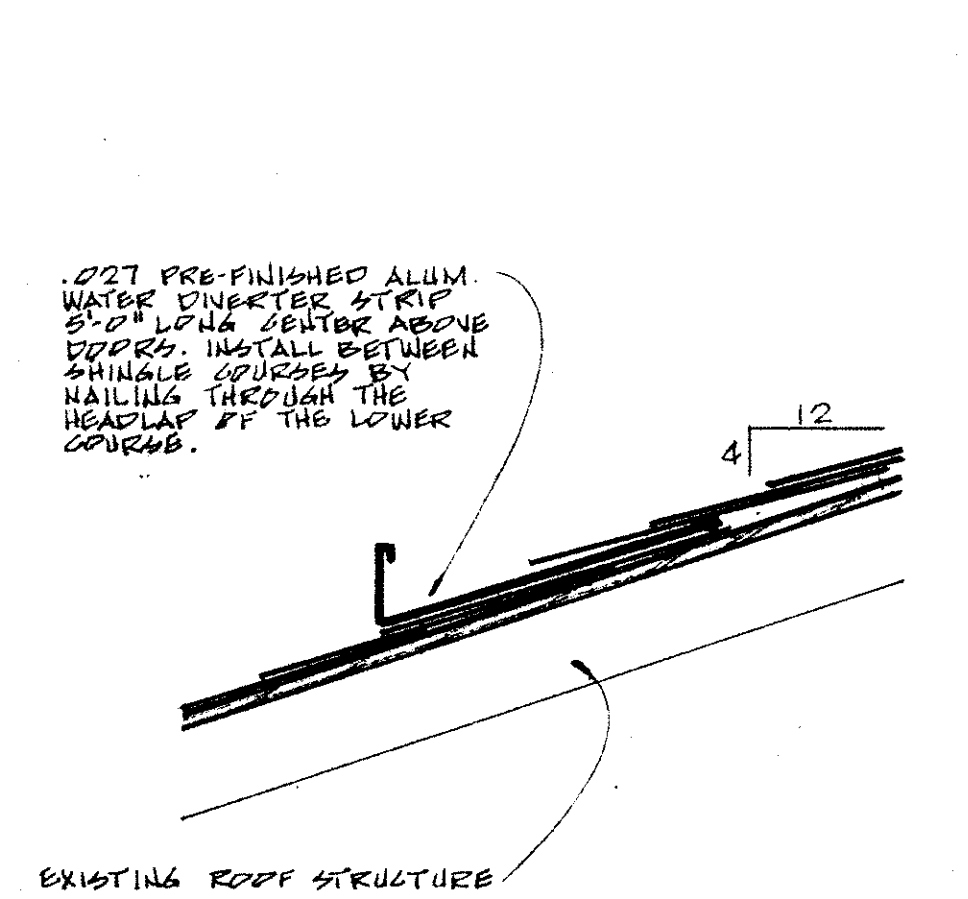

6 WATER DIVERTER STRIP

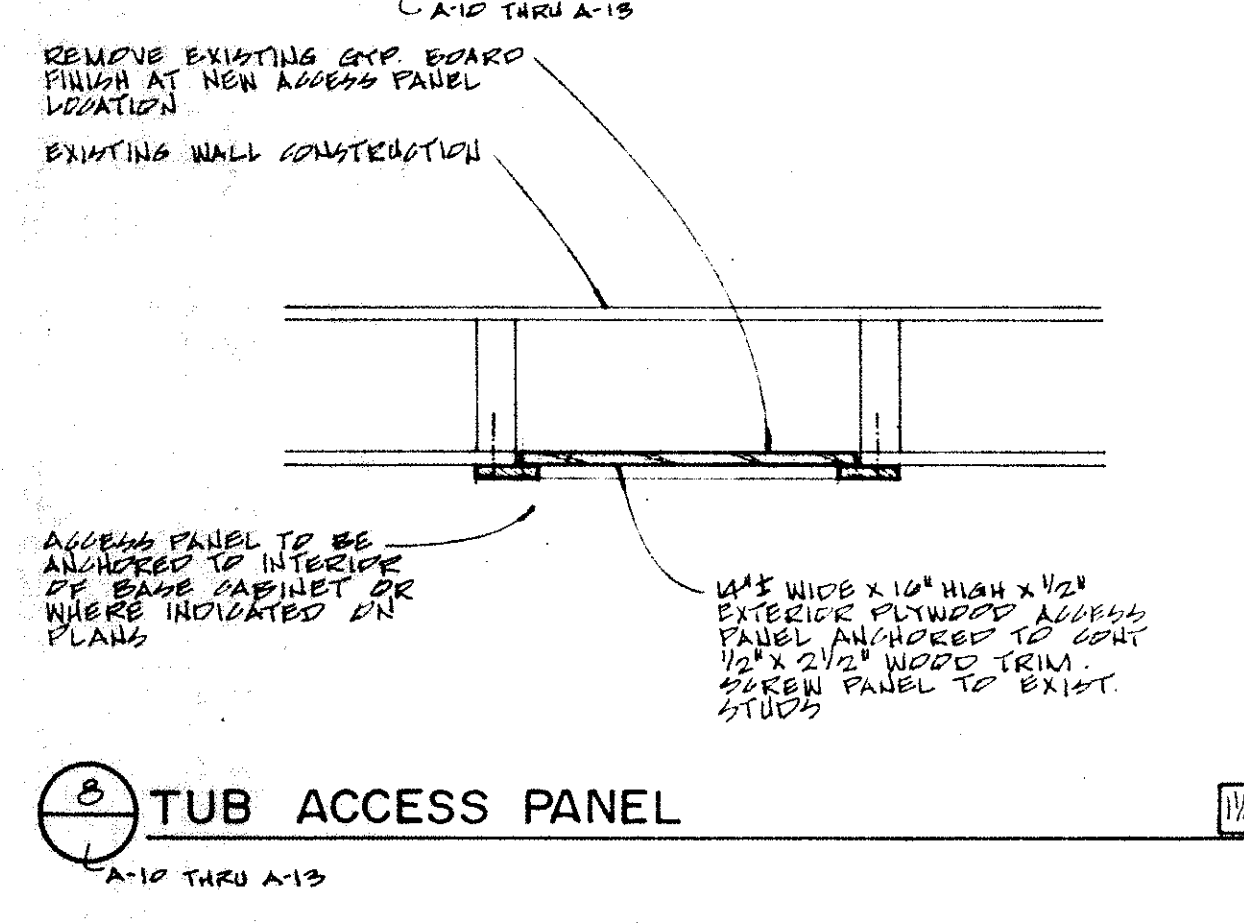

8 TUB ACCESS PANEL  
A-10 THRU A-15

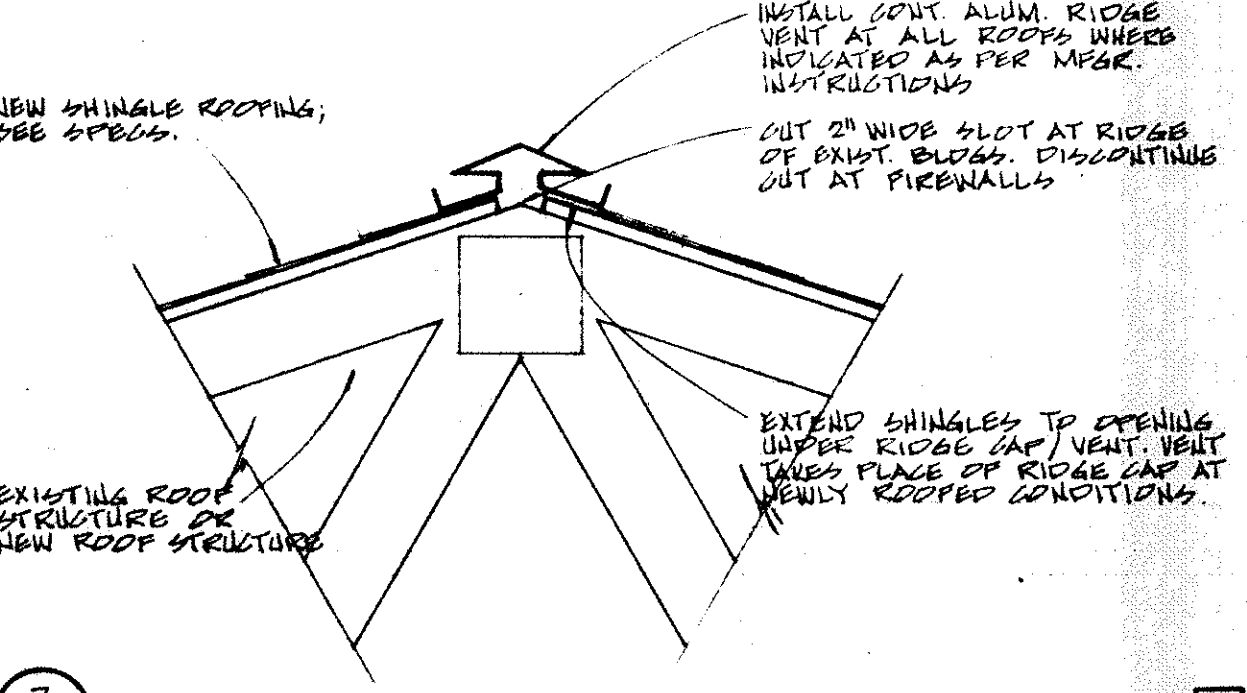

7 TYPICAL RIDGE VENT DETAIL

**FAUNTLEROY & LATHAM, INCORPORATED**  
ARCHITECTS, ENGINEERS, PLANNERS

316 NORTH LEE LANE • COVINGTON, LA 70433 • (504) 893-4100

PLANS FOR MODERNIZATION WORK FOR THE HOUSING AUTHORITY OF THE CITY OF SLIDELL  
SLIDELL, LOUISIANA SITE LA-103-3

WALL SECTIONS LIVING UNITS

DWG. NO. 80  
REV. NO. 1  
DATE 8-28-90 10-29-91

**A-14**

CONTRACTOR SHALL BE RESPONSIBLE FOR VERIFYING ALL EXISTING CONDITIONS AND DIMENSIONS BEFORE COMMENCING WORK AND SHALL REPORT ANY DISCREPANCIES TO ARCHITECT