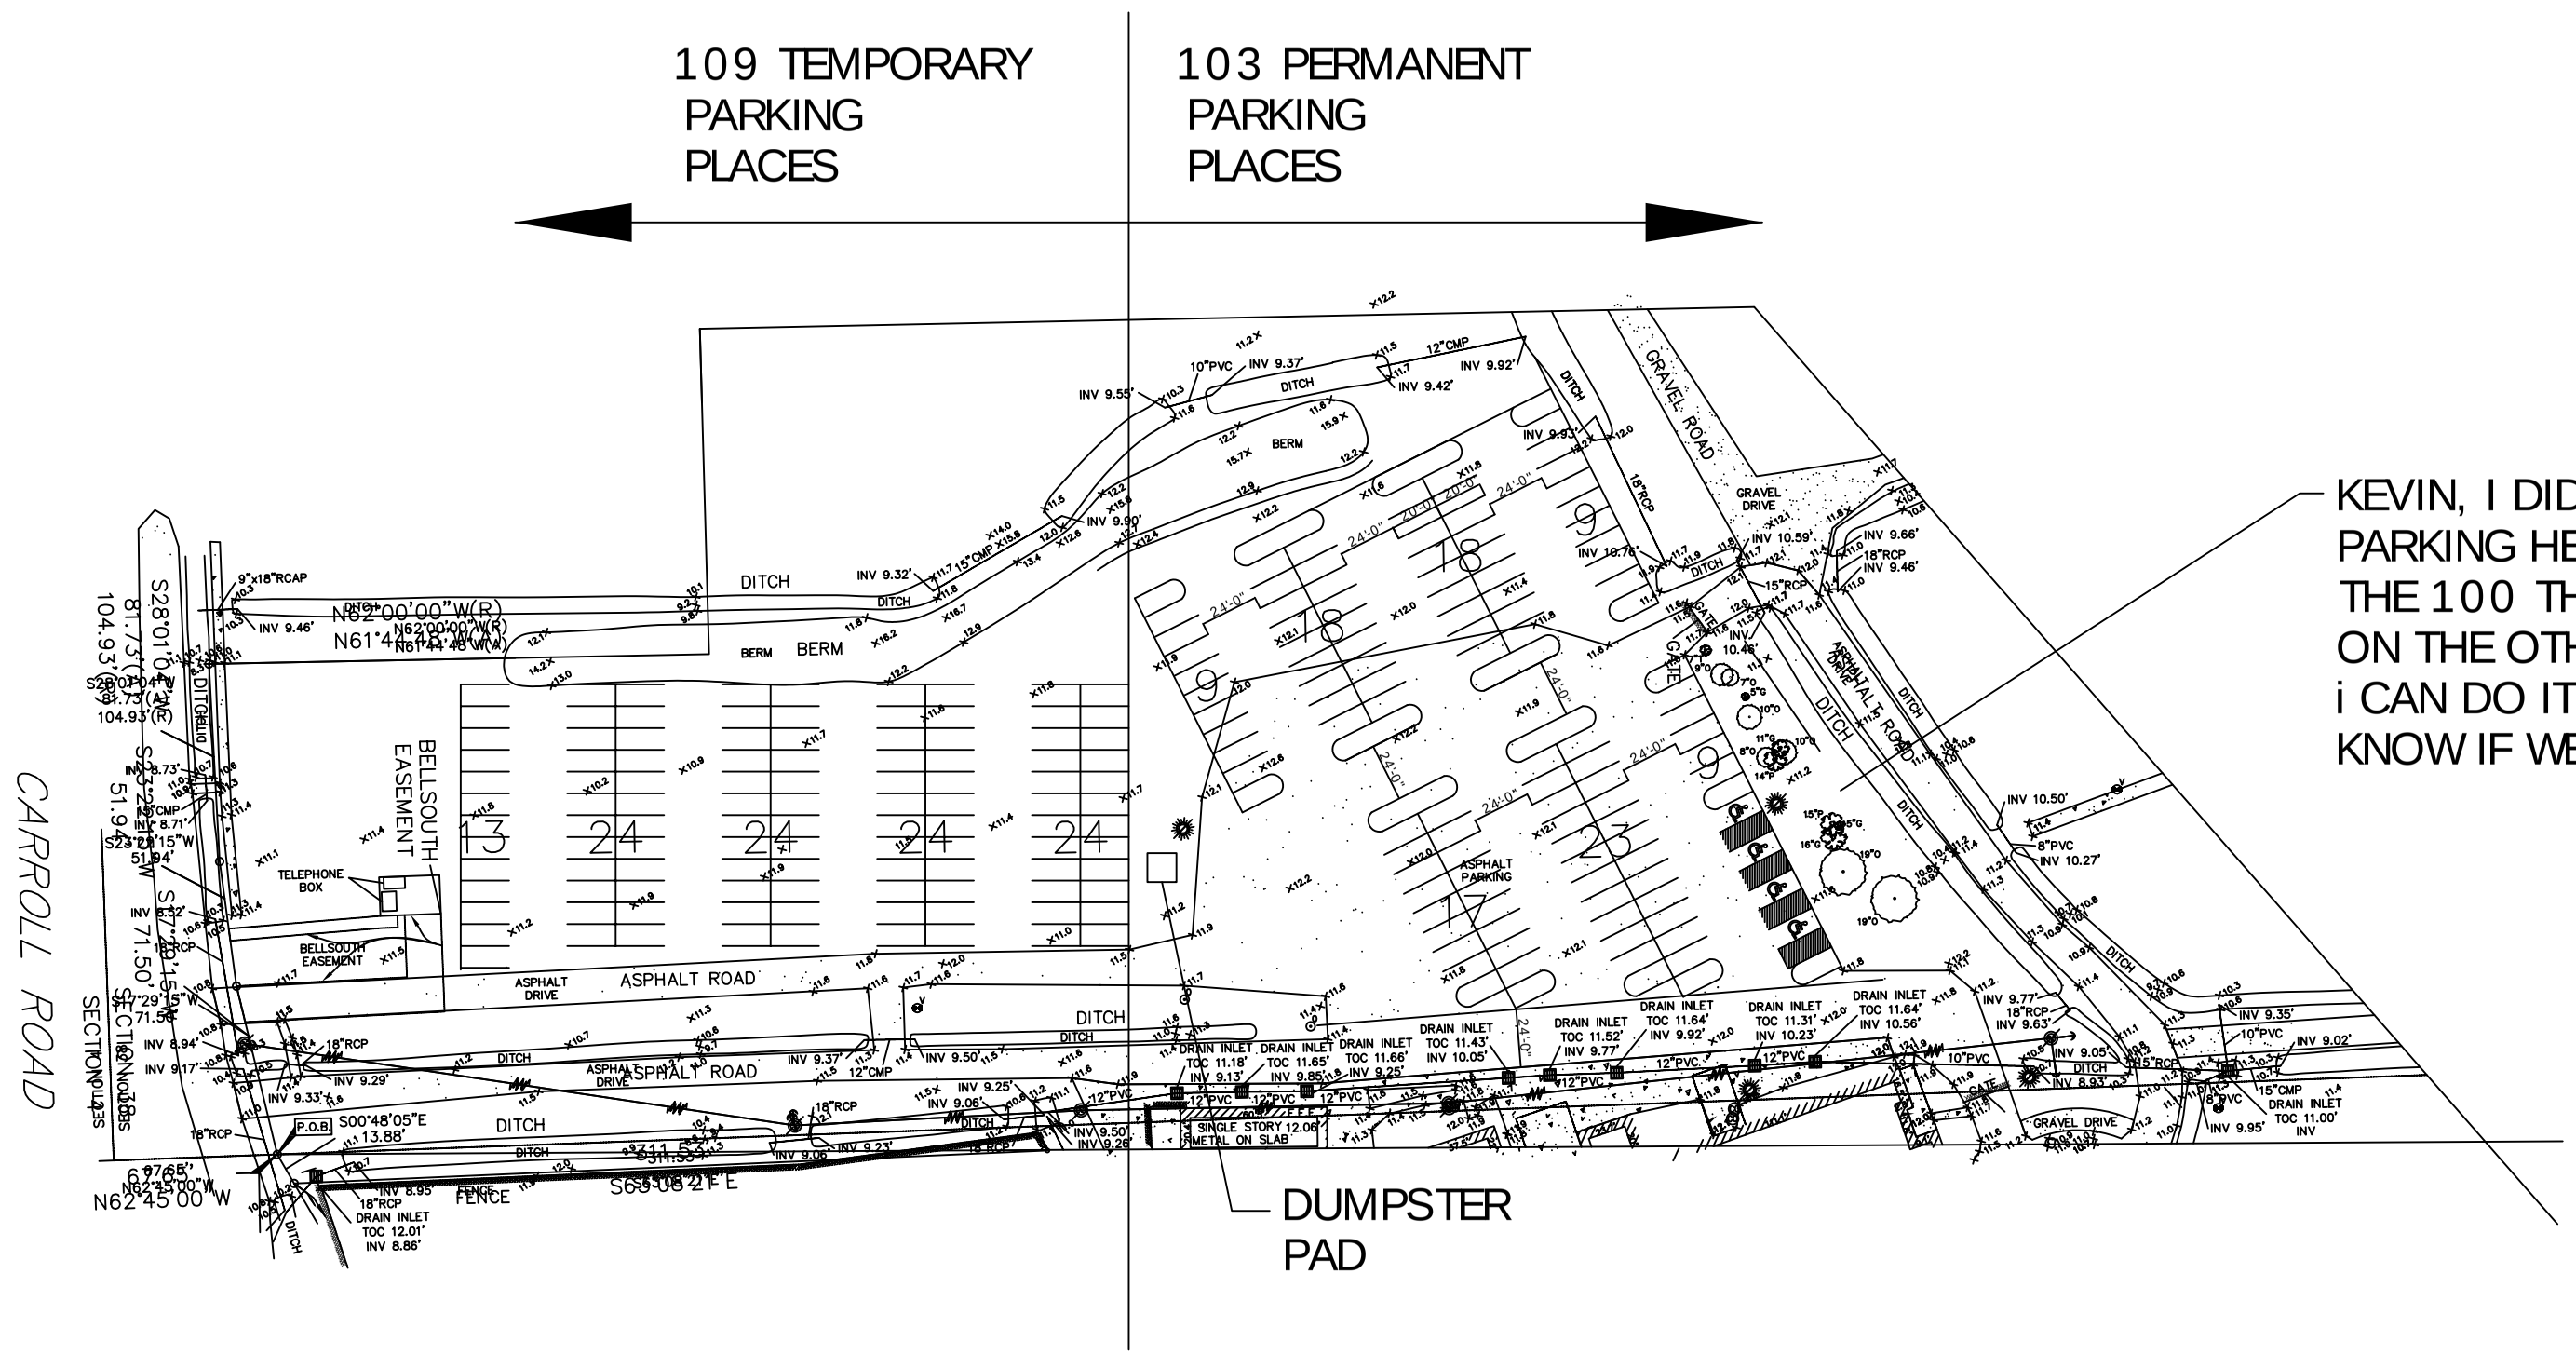
109 TEMPORARY PARKING PLACES
103 PERMANENT PARKING PLACES
CARROLL ROAD
DUMPSTER PAD
KEVIN, I DIDNT PUT ANY PARKING HERE YET, DUE TO THE 100 THAT WE HAVE ON THE OTHER SIDE.
i CAN DO IT, JUST LET ME KNOW IF WE STILL NEED IT.
ASPHALT ROAD
GRAVEL ROAD
GRAVEL DRIVE
ASPHALT DRIVE
ASPHALT PARKING
BELLSOUTH EASEMENT
TELEPHONE BOX
DITCH
BERM
FENCE
SINGLE STORY 12.06' METAL ON SLAB
DRAIN INLET
GATE
P.O.B.
S00°48'05"E 13.88'
N62°45'00"W
S89°08'21"E