

**DAMMON ENGINEERING, INC.**

CHIEF ENGINEER  
EMMETT DAMMON, P.E.

CHIEF ARCHITECT  
ROBERT WILTSE

1095 FLORIDA AVENUE  
SLIDELL, LA. 70458  
OFFICE: 985-649-5832  
FAX: 985-641-5950


WEBSITE:  
WWW.DAMMONENGINEERING.COM

EMAIL:  
DAMMONENG@BELLSOUTH.NET

- ARCHITECTURE
- ENGINEERING
- STUDIES
- PLANNING
- INVESTIGATION
- EXPERT WITNESS

GREEN-STATEFARM  
RETAIL COMPLEX  
383 GAUSE  
BLVD., WEST  
SLIDELL, LA

**FLOOR PLAN**

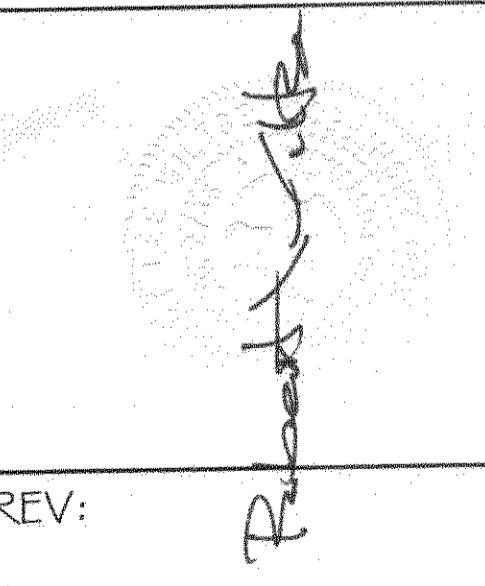

REV: \_\_\_\_\_


SCALE: AS NOTED

JOB#: 2057

DATE: 04-29-10

SHEET 8

A-1

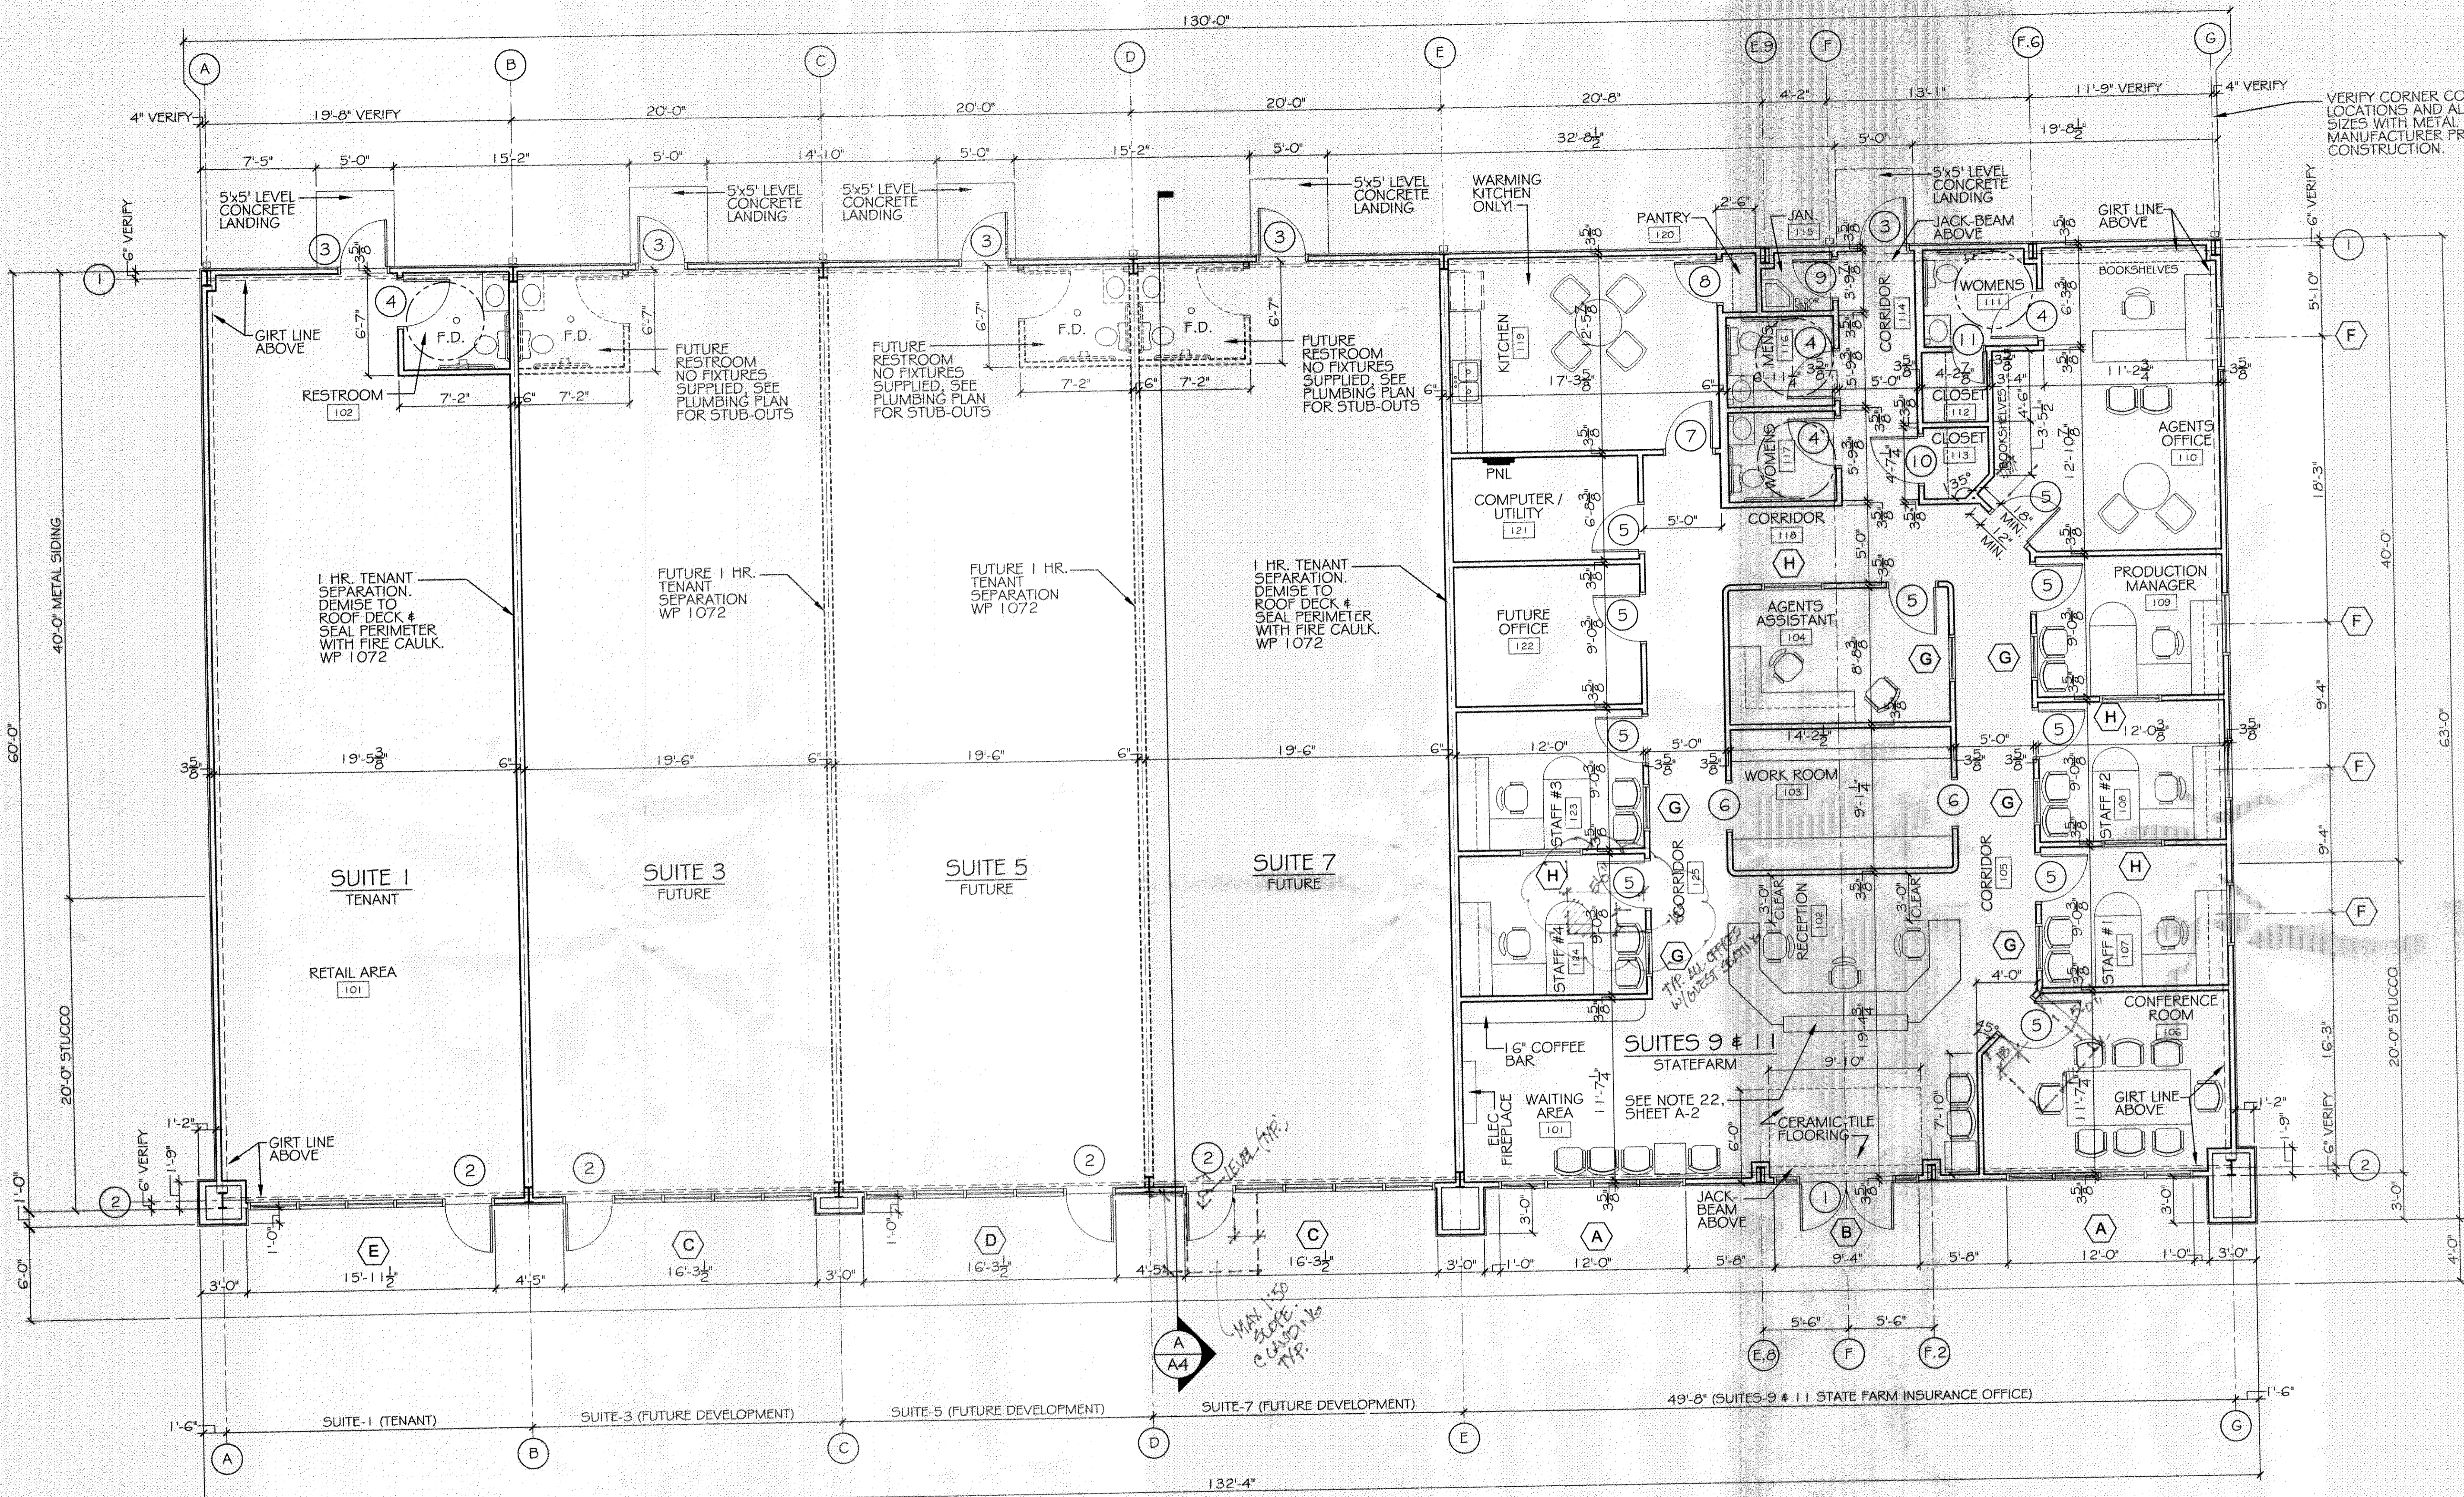

VERIFY CORNER COLUMN LOCATIONS AND ALL STEEL SIZES WITH METAL BUILDING MANUFACTURER PRIOR TO CONSTRUCTION.

40'-0" METAL SIDING

20'-0" STUCCO

40'-0"

20'-0" STUCCO

16'-3"

4'-0"

**FLOOR PLAN**  
SCALE: 3/16"=1'

NOTE: ALL DIMENSIONS ARE TO FACE OF STUD, EXCEPT COLUMN GRID LINES, UNLESS OTHERWISE NOTED.

**GA FILE NO. WP 1072 GENERIC**

ONE LAYER 5/8" TYPE X GYPSUM WALLBOARD OR GYPSUM VENEER BASE APPLIED PARALLEL OR AT RIGHT ANGLES TO EACH SIDE OF 3-5/8" STEEL STUDS 24" O.C. WITH 1" TYPE S DRYWALL SCREWS 8" O.C. AT VERTICAL JOINTS AND 12" O.C. AT FLOOR AND CEILING RUNNERS AND INTERMEDIATE STUDS.

JOINTS STAGGERED 24" ON EACH SIDE AND ON OPPOSITE SIDES. SOUND TESTED WITH 3-12" GLASS FIBER FRICTION FIT IN STUD SPACE. (NON-LOAD BEARING)

1 HOUR FIRE 45 TO 49 STC SOUND



THICKNESS: 4-7/8"  
APPROX. WEIGHT: 6 PSF  
FIRE TEST:

SOUND TEST:

SEE WP 1200 (FM WP-45, 6-19-68);  
OSU T-1770, 8-6-1; ULC 79T484, 79T500,  
79T497, 8-12-81, ULC DESIGN W415)  
NRCC 816-NV, 2-3-81

**1 HR SEPARATION DETAIL**

NTS

Fire Extinguisher SIZES & LOCATIONS

380899  
REVIEWED FOR  
STATE FIRE MARSHAL  
AS PER REVIEW LETTER  
BY: JAMES WHITE, ARCHITECT  
*James White*