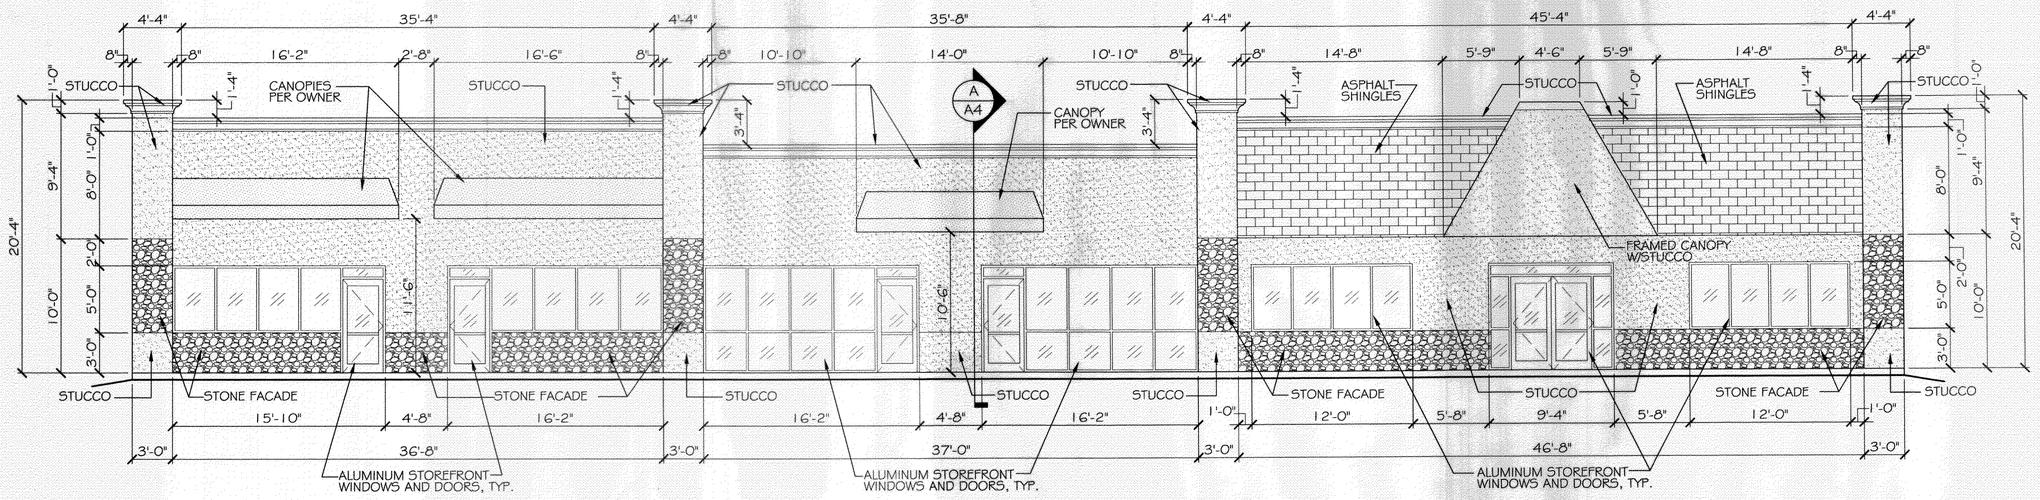

NORTHEAST (FRONT) ELEVATION

SCALE: 3/16"=1'

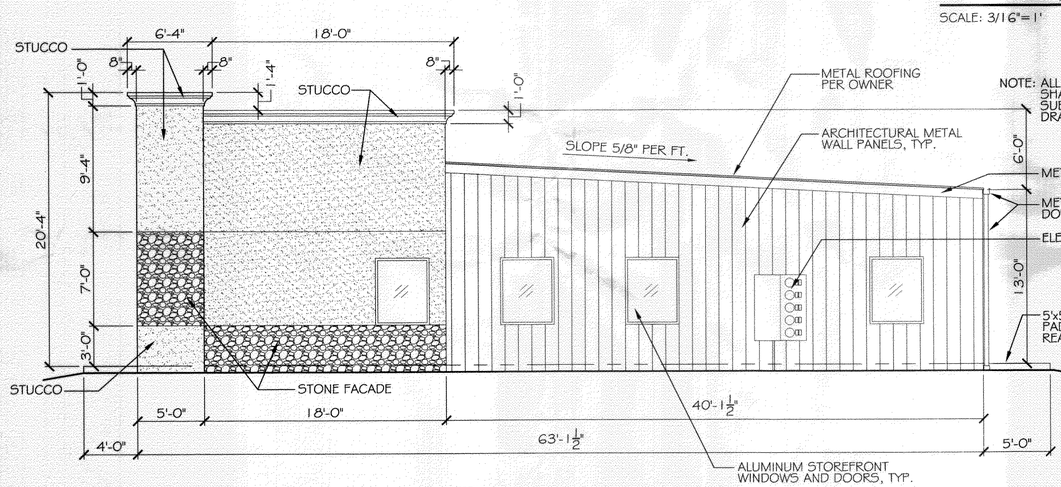

NORTHWEST (SIDE) ELEVATION

SCALE: 3/16"=1'

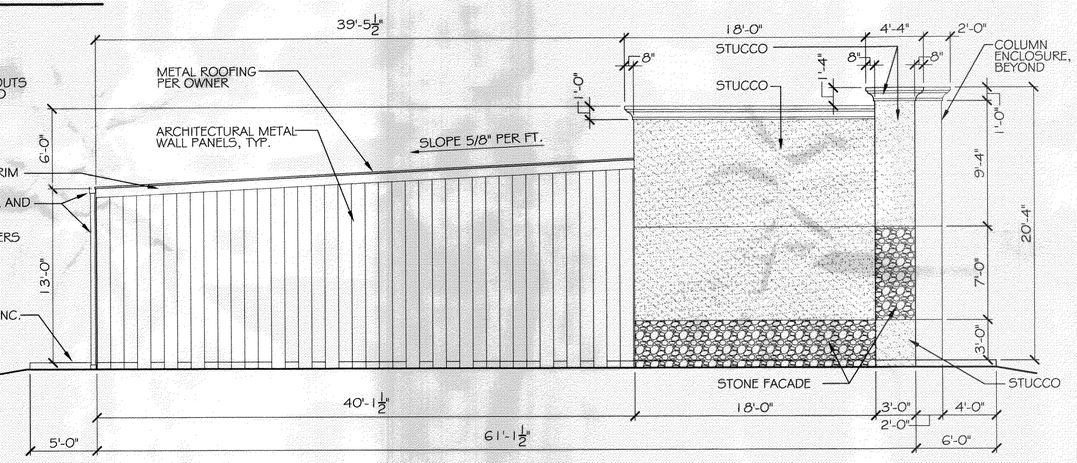

SOUTHEAST (SIDE) ELEVATION

SCALE: 3/16"=1'

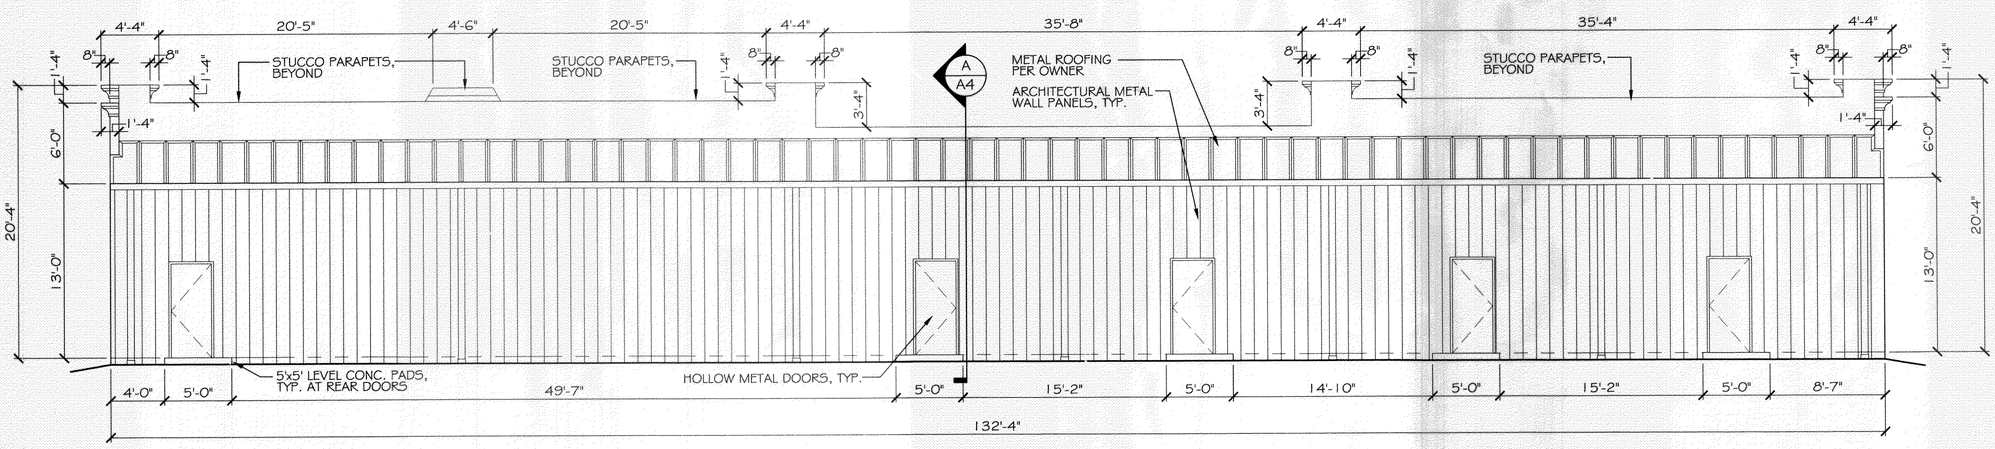

SOUTHWEST (REAR) ELEVATION

SCALE: 3/16"=1'

380899

REVIEWED FOR STATE FIRE MARSHAL AS PER REVIEW LETTER BY: JAMES WHITE, ARCHITECT, CBO

DAMMON ENGINEERING, INC.

CHIEF ENGINEER
EMMETT DAMMON, P.E.

CHIEF ARCHITECT
ROBERT WILTSE

1095 FLORIDA AVENUE
SLIDELL, LA. 70458
OFFICE: 985-649-5832
FAX: 985-641-5950

WEBSITE:
WWW.DAMMONENGINEERING.COM

EMAIL:
DAMMONENG@BELLSOUTH.NET

ARCHITECTURE

ENGINEERING

STUDIES

PLANNING

INVESTIGATION

EXPERT WITNESS

GREEN-STATEFARM RETAIL COMPLEX
383 GAUSE BLVD., WEST
SLIDELL, LA

EXTERIOR ELEVATIONS

REV:

SCALE: AS NOTED

JOB#: 2057

DATE: 04-29-10

SHEET 10

A-3

OF 19