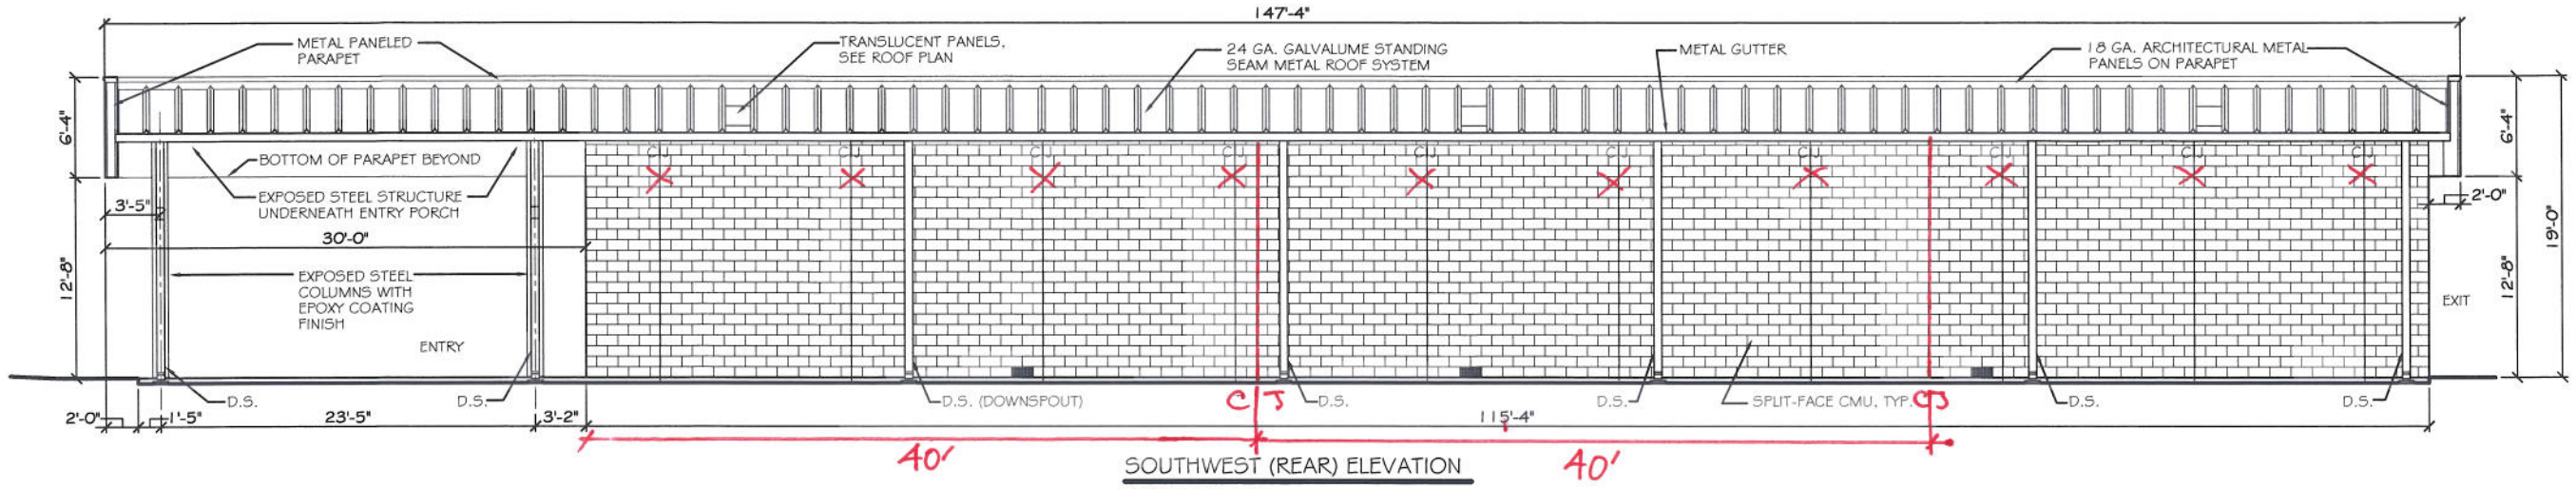

SOUTHWEST (REAR) ELEVATION

SCALE: 3/16"= 1'-0"

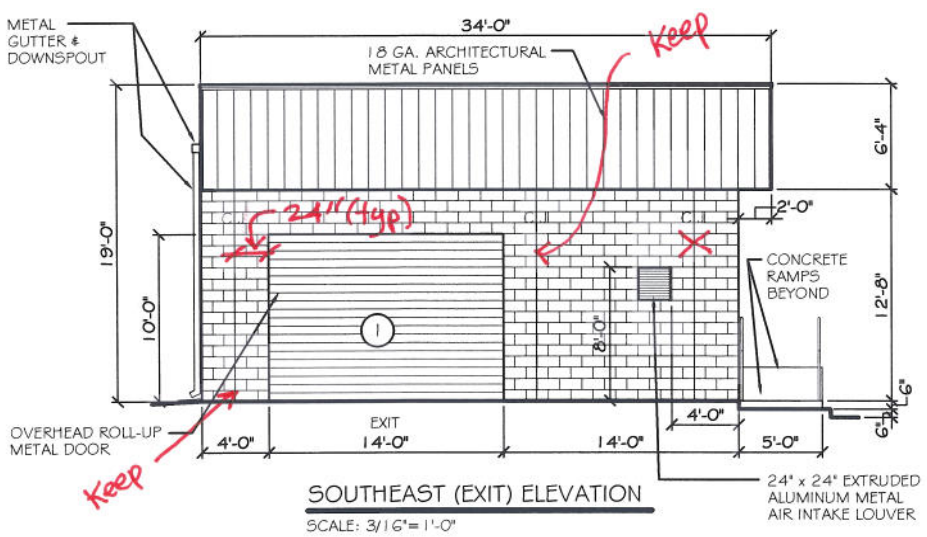

SOUTHEAST (EXIT) ELEVATION

SCALE: 3/16"= 1'-0"

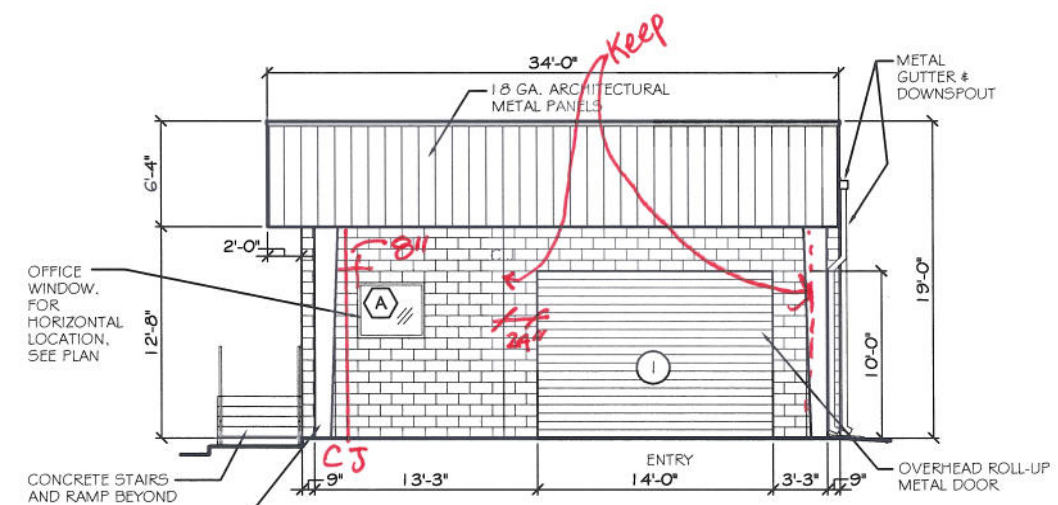

NORTHWEST (ENTRY) ELEVATION

SCALE: 3/16"= 1'-0"

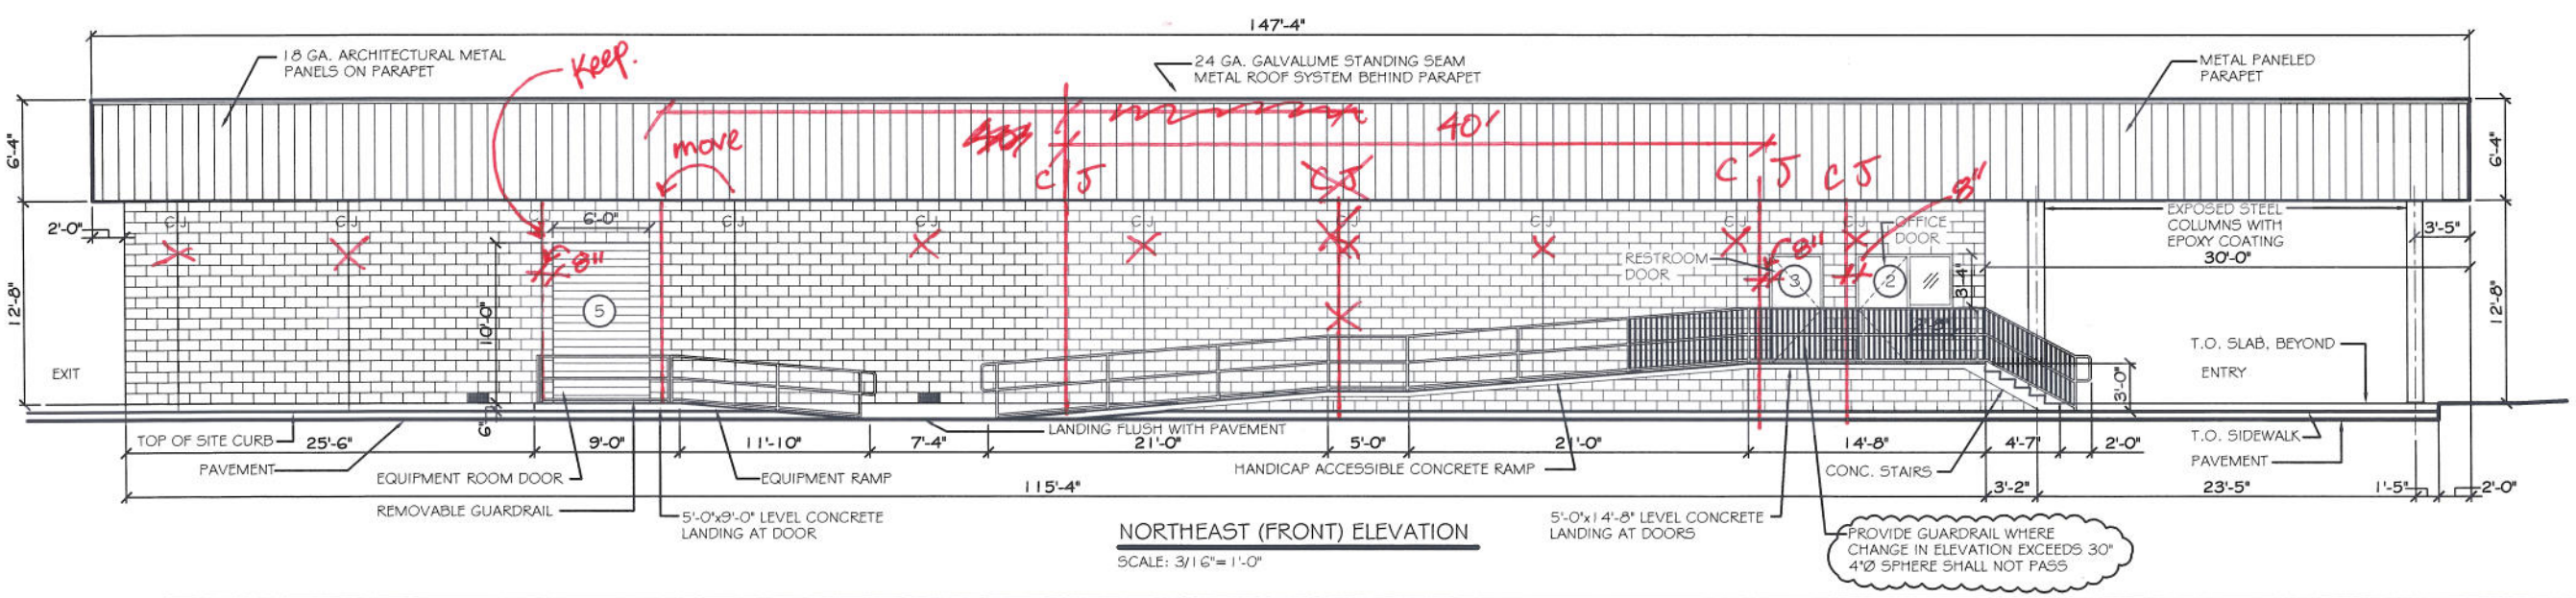

NORTHEAST (FRONT) ELEVATION

SCALE: 3/16"= 1'-0"

DAMMON ENGINEERING, INC.

CHIEF ENGINEER
EMMETT DAMMON, P.E.

CHIEF ARCHITECT
ROBERT WILTSE

554 OLD SPANISH TRAIL
SLIDELL, LA. 70458
OFFICE: 985-649-5832
FAX: 985-641-5950

WEBSITE:
WWW.DAMMONENGINEERING.COM

EMAIL:
DAMMONENG@BELLSOUTH.NET

ARCHITECTURE

ENGINEERING

STUDIES

PLANNING

INVESTIGATION

EXPERT WITNESS

RAIN FOREST CARWASH

3017 PONTCHARTRAIN DRIVE
SLIDELL, LA 70458

EXTERIOR ELEVATIONS

REV:

SCALE: AS NOTED

JOB#: 2085

DATE: 03-23-11

SHEET 18

A-3

OF 25