


FIRE DEPARTMENT NOTES		PARKING		LEGEND	
1. WHERE REQUIRED BY CODE, BUILDINGS ARE TO BE PROVIDED WITH...	2. WHERE REQUIRED BY CODE, STAIRWELLS ARE TO BE PROVIDED AT EACH FLOOR IN ORDER TO MAINTAIN A MINIMUM 20' DISTANCE FROM ANY...	PARKING REQUIRED: 111 SPACES	248 ROOM UNITS = 188 SPACES		HANDICAPPED PARKING SPACE
3. MINIMUM CLEARANCE HEIGHT SHALL BE 7'0" UNLESS OTHERWISE SPECIFIED.	4. MINIMUM CLEARANCE HEIGHT SHALL BE 7'0" UNLESS OTHERWISE SPECIFIED.	TOTAL RESIDENTIAL REQUIRED: 227 SPACES	248 ROOM UNITS = 188 SPACES		FIRE ALARM PANEL BY 792 OR AS SPECIFIED ON SCHEDULE

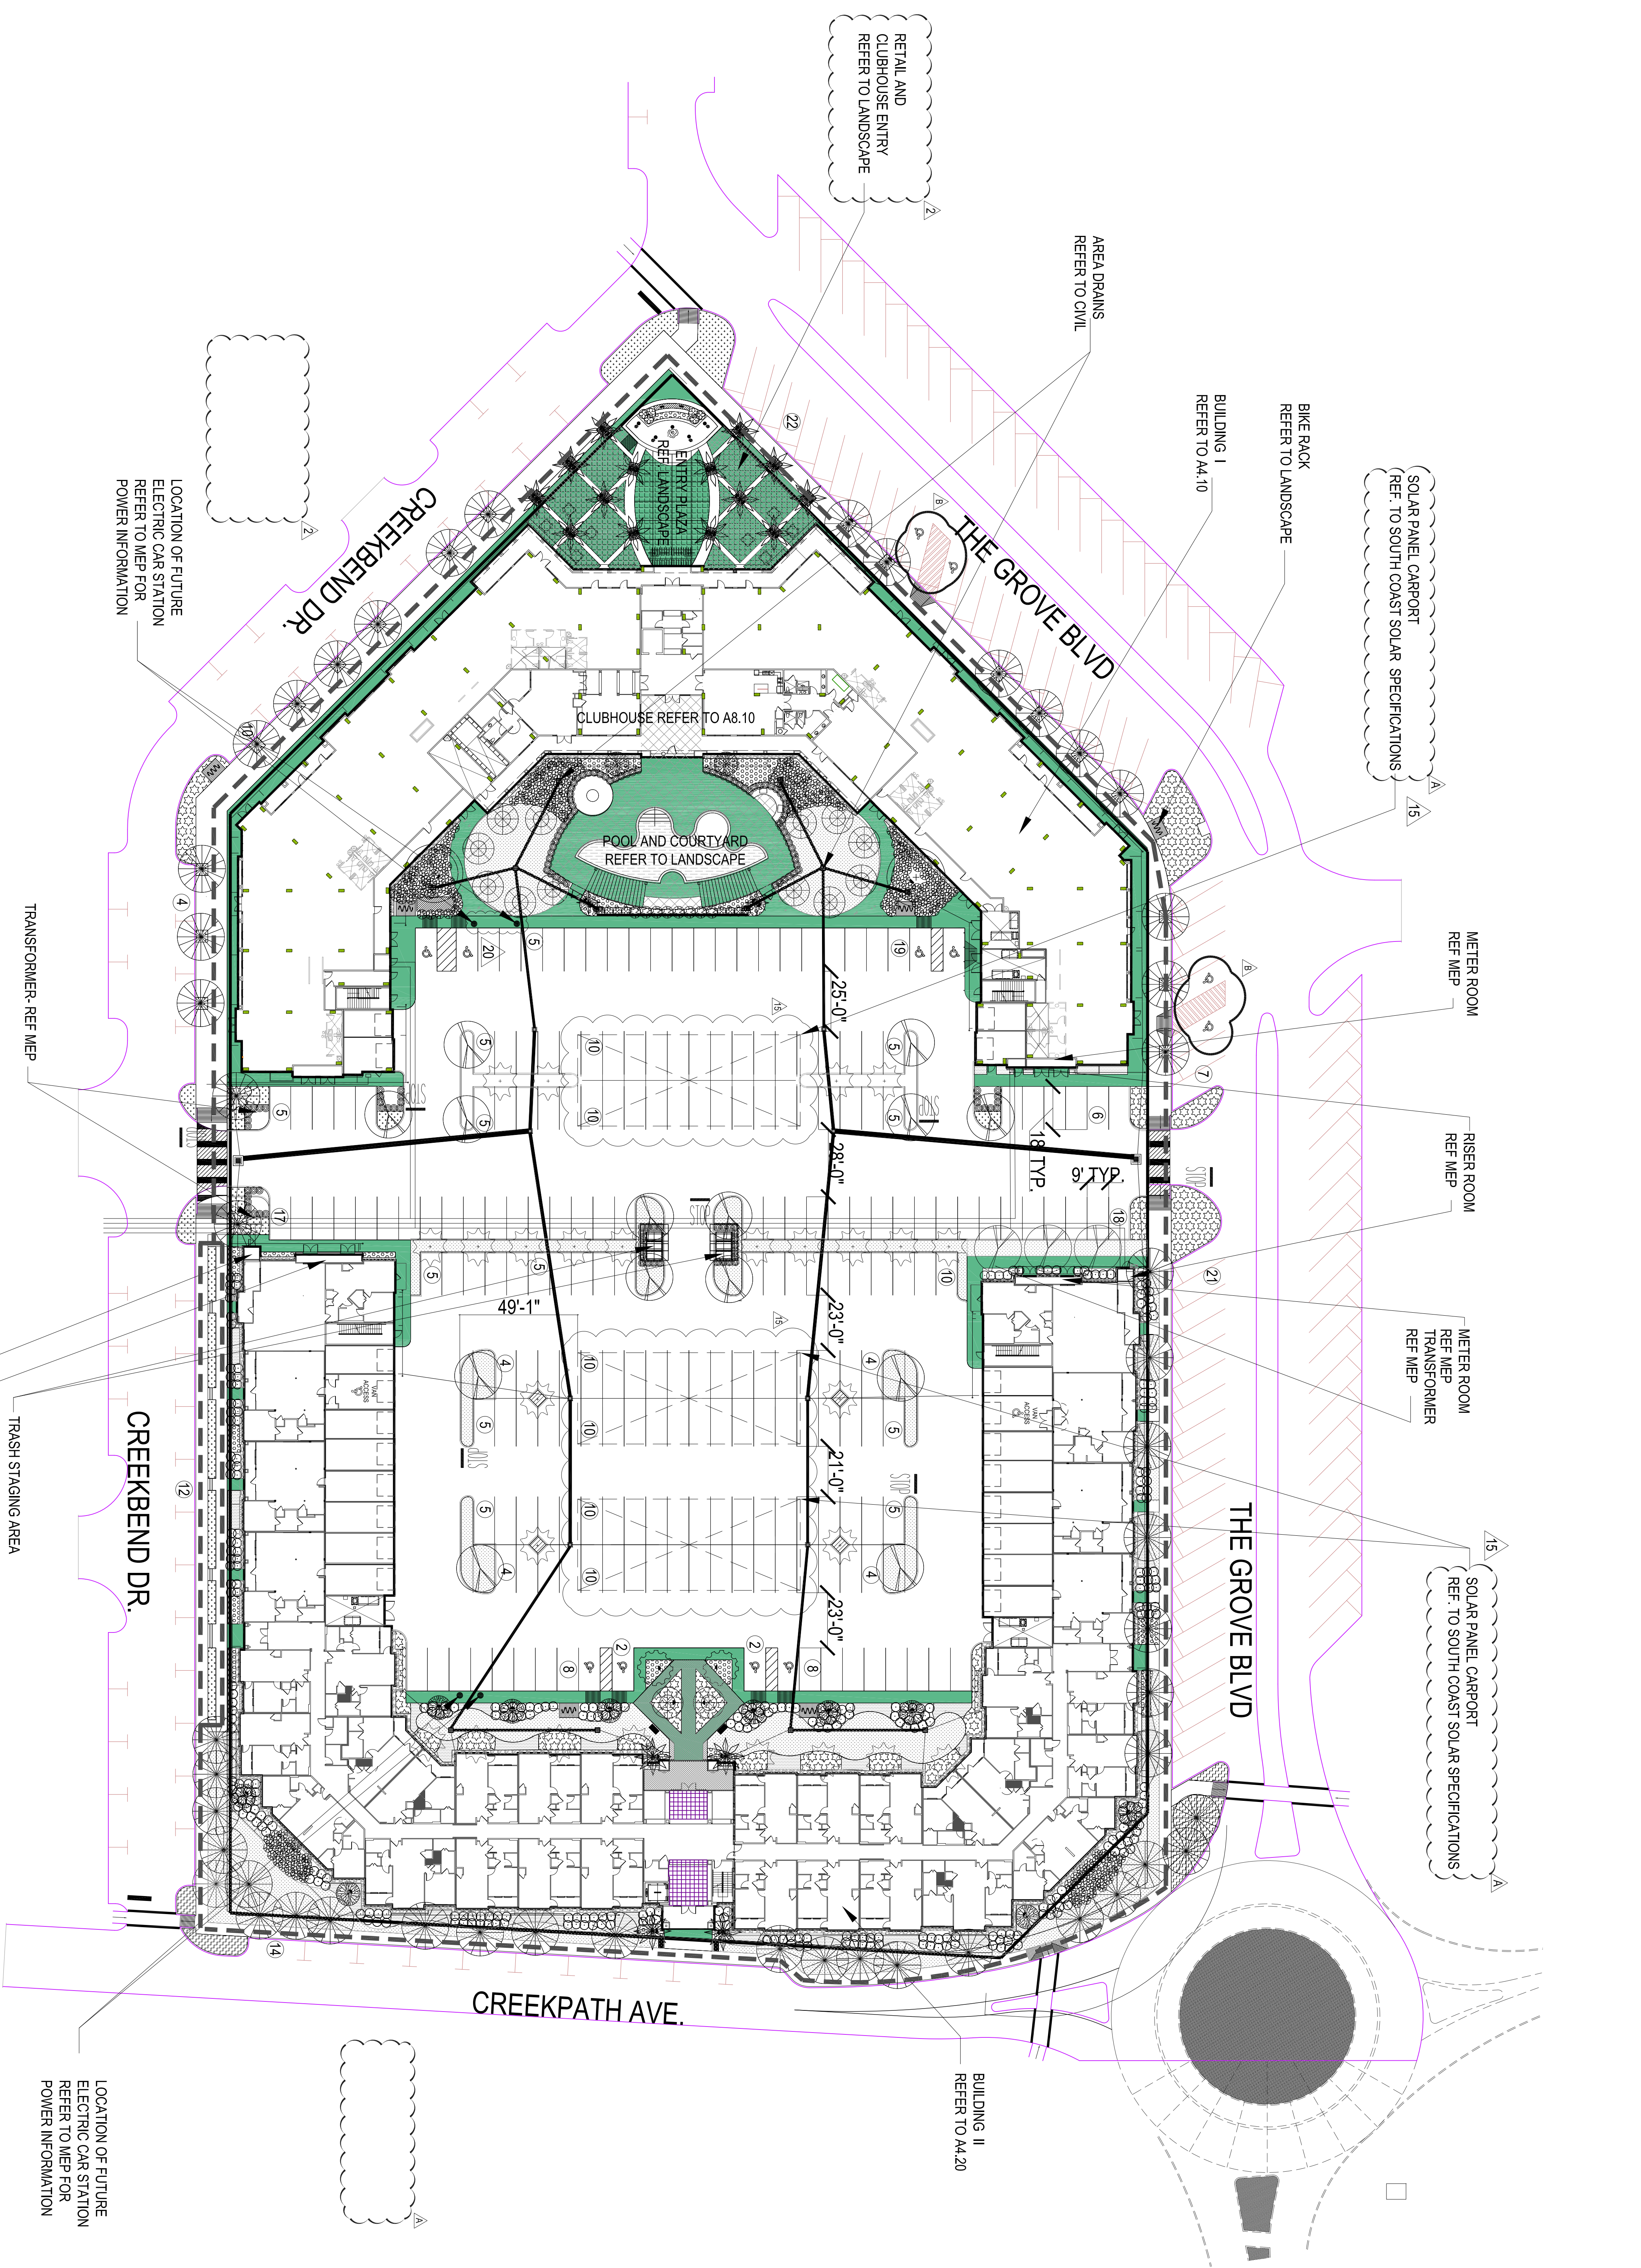

**SITE NOTES**

- THIS SITE PLAN FOR REFERENCE ONLY. REFER TO CIVIL FOR SITE DIMENSIONAL CONTROL.
- LANDSCAPE PLANNING FOR SPACES AND ACCESSIBLE ROUTE THROUGHOUT SITE. FINISH, GATE LOCATIONS AND DETAILS WILL BE PROVIDED IN LATER DRAWINGS.
- PERMITTING AND USE OF THIS SITE MUST CONFORM WITH ALL APPLICABLE CODES AND ORDINANCES.
- APPLICABLE CODES AND ORDINANCES.
- ANY LIGHTING WILL BE PLACED SO AS TO DIRECT LIGHT AWAY FROM RESIDENTIAL DISTRICTS AND WILL NOT EXCEED ONE FOOT CANDLE AT ANY POINT. NO NOISE, COLOR OR VIBRATION WILL BE EMITTED AT ANY LEVEL EXCEEDING THE GENERAL LEVEL OF HOUSE, COOK OR VIBRATION.
- OWNERS OF PROPERTY ADJACENT TO PUBLIC HIGHWAY SHALL HAVE RESPONSIBILITY FOR MAINTAINING ALL LANDSCAPING PLANS.
- AFTER FINAL APPROVAL, THE PROJECT WILL BE INSPECTED FOR CONFORMANCE WITH ALL APPLICABLE CODES AND ORDINANCES.
- ALL SERVICE AREAS SHALL BE SCREENED TO CONCEAL TRASH CONTAINERS, GAS METERS, LOADING DOCKS, TRANSFORMERS, ETC.
- EQUIPMENT FROM LEVEL ADJACENT TO ALL PUBLIC STREETS.
- BARBED RAZOR OR CONCRETE WIRE OR SIMILAR SHALL NOT ADJACENT TO PUBLIC STREETS.
- GRADE SHALL NOT EXCEED 5% CROSS SLOPES NOT TO EXCEED 2% TYP. CONT.
- SOIL SHALL BE REMOVED AND REPLACED WITH FERTILIZER.

1 ARCHITECTURAL SITE PLAN  
SCALE: 1" = 30'

HUD CLOSING/CONSTRUCTION SET

**HUMPHREYS & PARTNERS ARCHITECTS, L.L.C.**  
 603 JULIA STREET • NEW ORLEANS, LOUISIANA 70130  
 (504) 717-4700 • (504) 558-7762 FAX  
 DALLAS • ORLANDO • NEW ORLEANS  
 IRVINE • PHOENIX  
 www.humphreys.com

**THE HIGH GROVE APARTMENTS**  
 BATON ROUGE, LOUISIANA  
 High Grove Baton Rouge, LLC.

Designed by: JLS, A.W., T.D., M.H., Y.S.  
 Date of Report: 04-16-12  
 Project Name: 07-20-11  
 Scale: 1" = 30'

**LEGEND**

NO.	DATE	COMMENTS
1	08/01/11	ADDITIONAL COMMENT
2	04/16/12	CONTRACTOR COMMENTS

10025