



SYMBOL LEGEND - EXTERIOR ELEVATION			
	WINDOW/SWIFTING TAG		ELEV. (W/07)
	WALL SECTION TAG		FINISH FLOOR ELEVATION TAG
	TOP OF PLATE		TOP OF DECK
	DETAIL SECTION TAG		TOP OF DECK

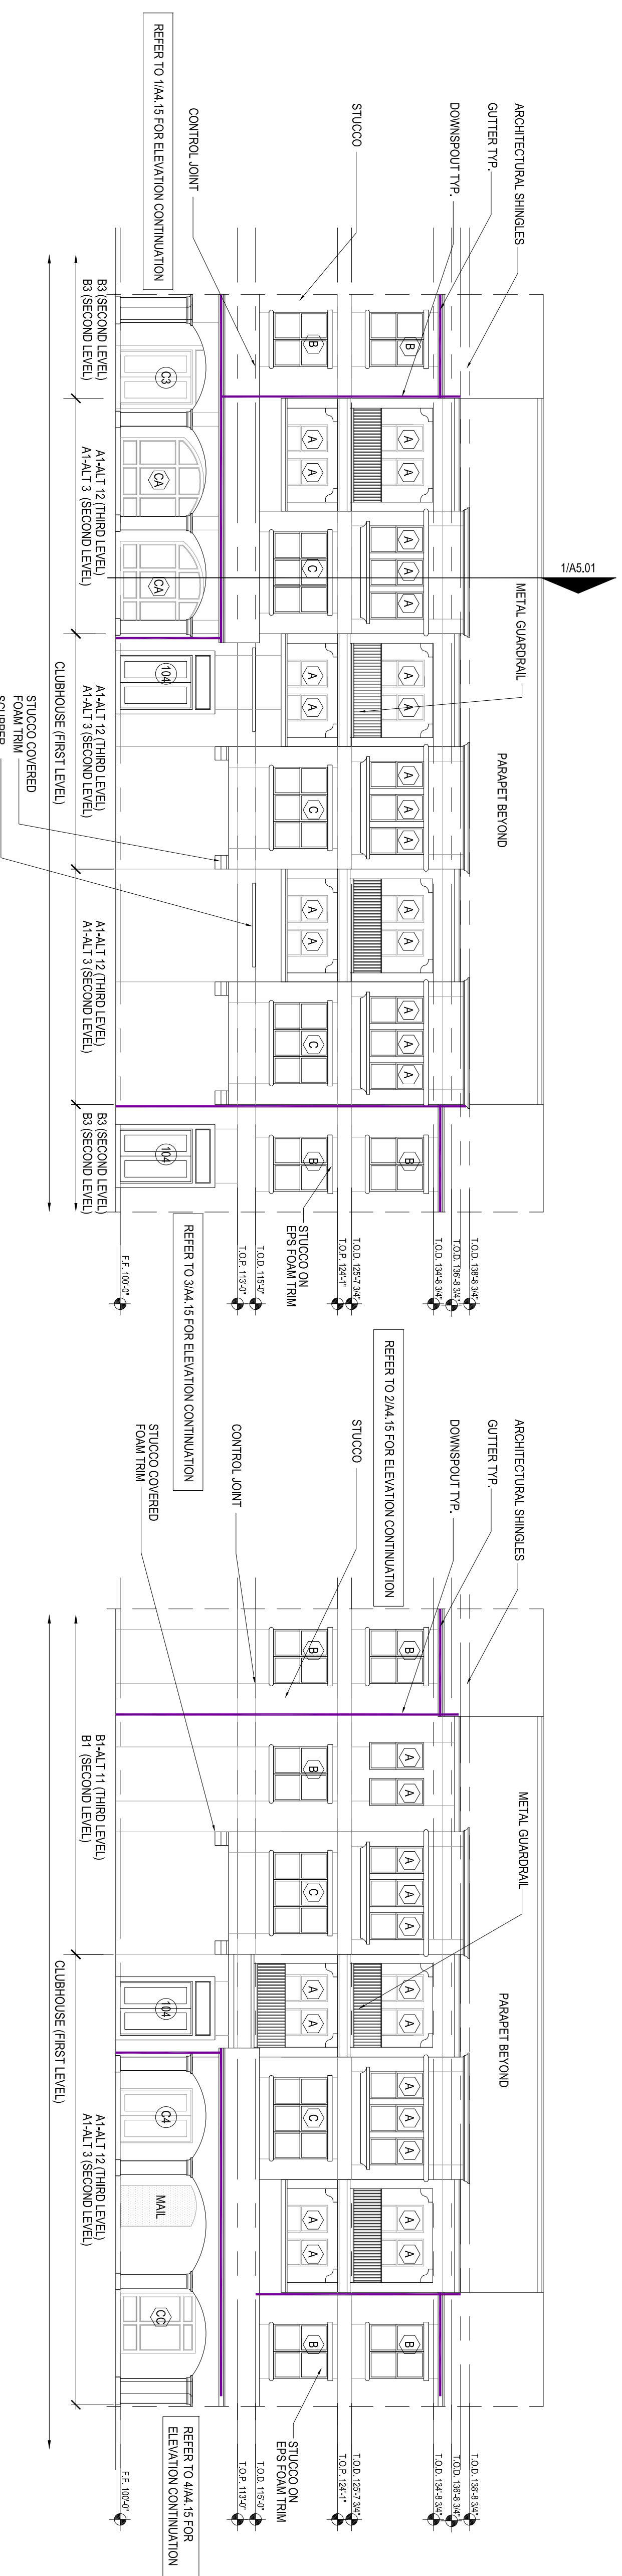


**5 BUILDING 1 - COURTYARD ELEVATION**  
SCALE: 3/32" = 1'-0"

ELEVATION NOTES	
1.	STUCCO CONTROL JOINT MINIMUM SPACING IS 11'-0" O.C. EACH WAY OR AS RECOMMENDED BY TEXAS LATH & PLASTER BUREAU.
2.	TRIMMED ROOF CORNERS, DOWNERS, ETC. TO HAVE A MINIMUM ROOF PITCH OF 1/4" PER 12" MINIMUM OR 1/8" PER 12" MINIMUM.
3.	PROVIDE 1/2" MINIMUM OF CLEAR AWAY FROM WALL ON TOP SURFACE OF WALL PROJECTIONS. ALL EXTERIOR WALL JOINT FINISHES AT 5'-0" A.F.T. TO BOTTOM OF FINISH FLOOR.
4.	GRANDES AROUND ALL EXTERIOR WALLS OF THE BUILDING TO BE 3 INCHES BELOW FINISH FLOOR.
5.	FLASHING WATERPROOF MEMBRANES, PROPER GULCHES AND SEALANTS BACKER SHALL BE INSTALLED AROUND ALL WINDOWS, DOORS, ROOF DOWNERS, WALLS, INTERIORS, STAIRS, TERRACES, BALCONIES AND OTHER WEATHER EXPOSED AREAS.
6.	PROVIDE NUMBER LIGHT BUILDINGS, ROOF AND EXTERIOR ENVELOPE THAT MEETS ALL APPLICABLE CODES AND REGULATIONS.
7.	ALL PATIOS, PORCHES, BALCONIES, TERRACES AND EXTERIOR CONDITIONS TO BE SLOPED 1/8" PER 12" MINIMUM IN DIRECTION INDICATED ON PLANS AND MAINTAINED FREE OF OBSTRUCTIONS.
8.	REQUIRED AREAS BASED ON GENERAL EXHAUST ARE:


**4 BUILDING 1 - COURTYARD ELEVATION**  
SCALE: 3/32" = 1'-0"

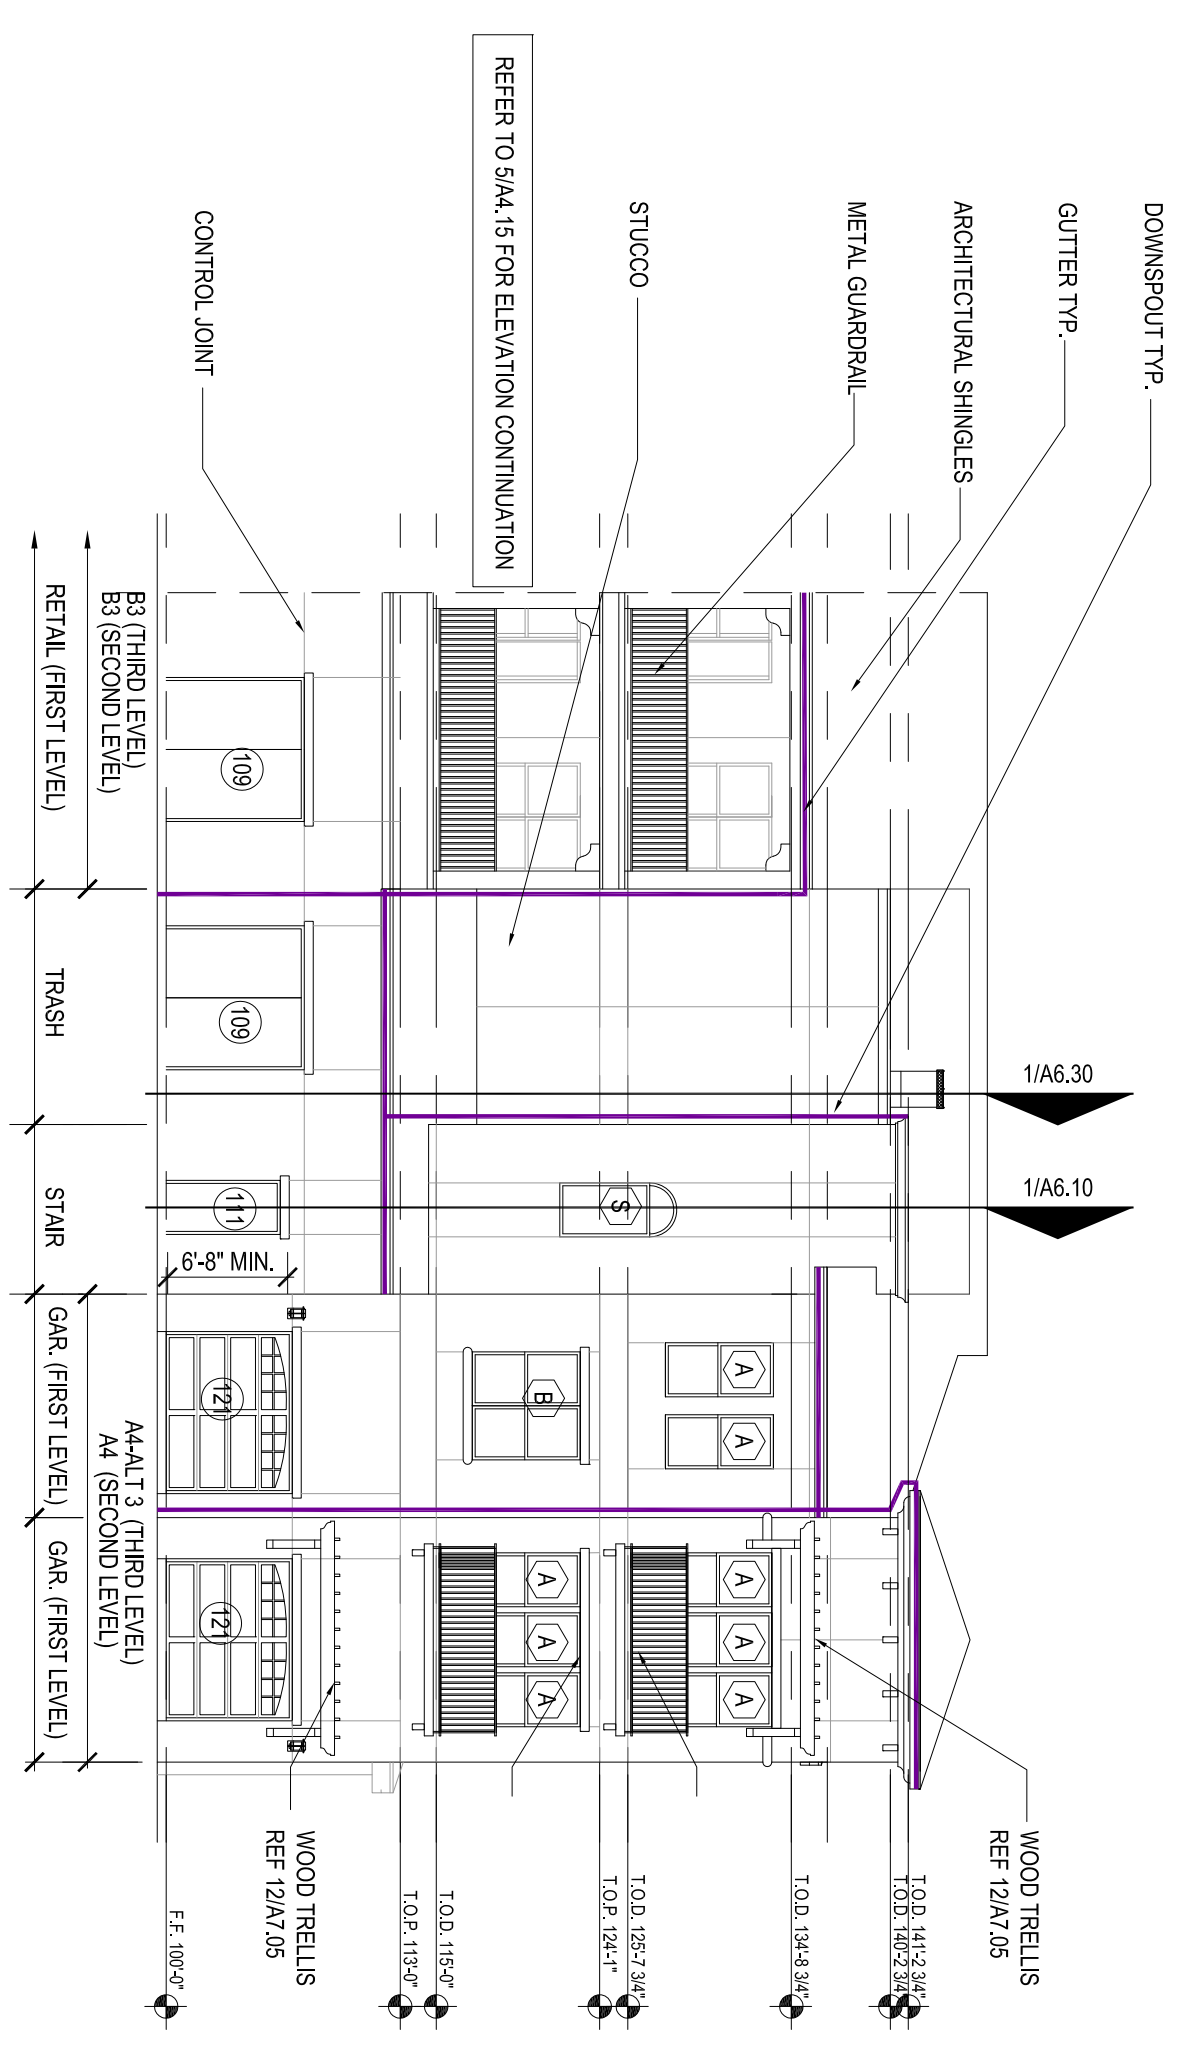

**3 BUILDING 1 - COURTYARD ELEVATION**  
SCALE: 3/32" = 1'-0"

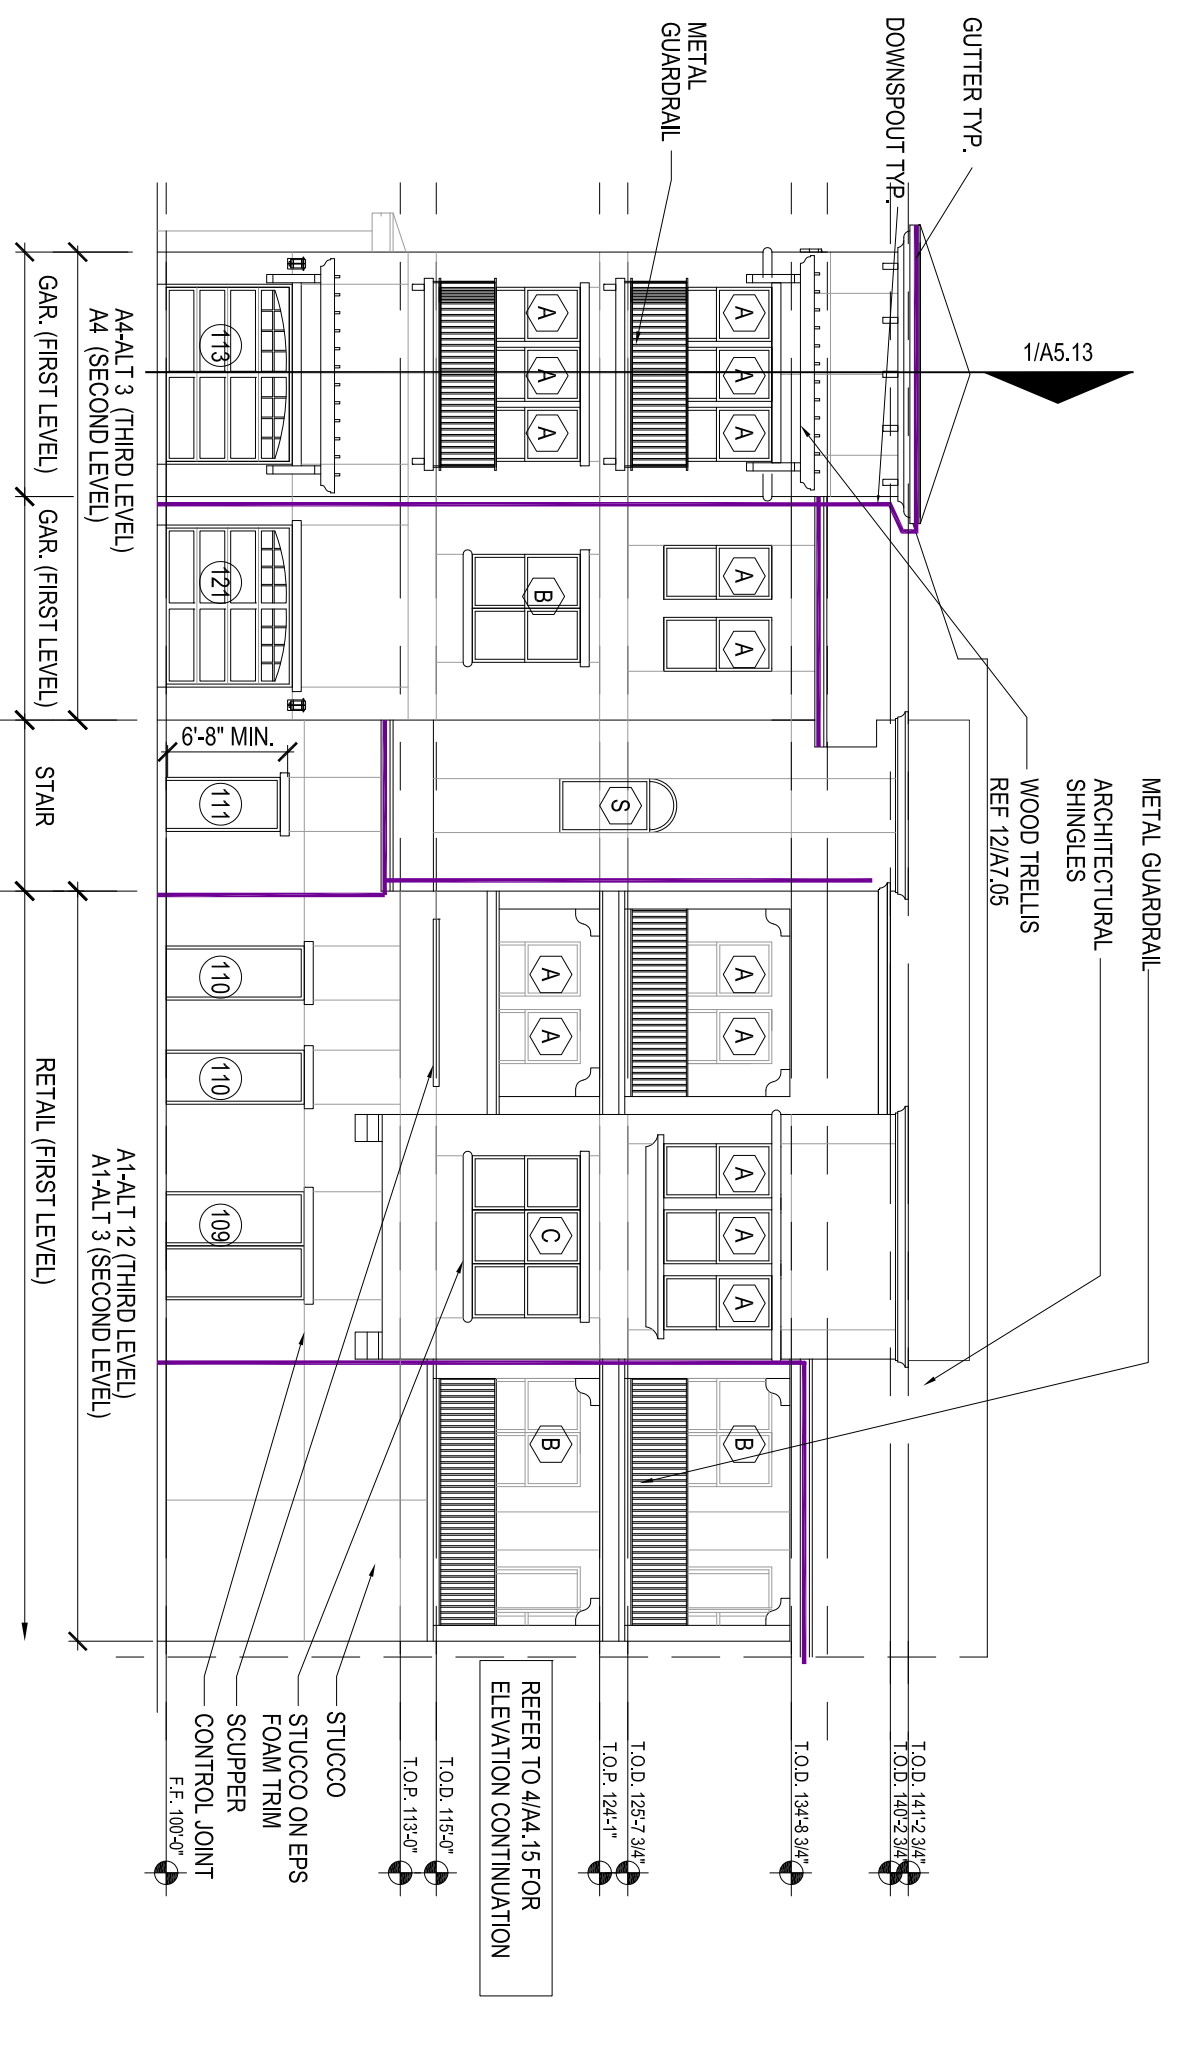

**2 BUILDING 1 - COURTYARD ELEVATION**  
SCALE: 3/32" = 1'-0"

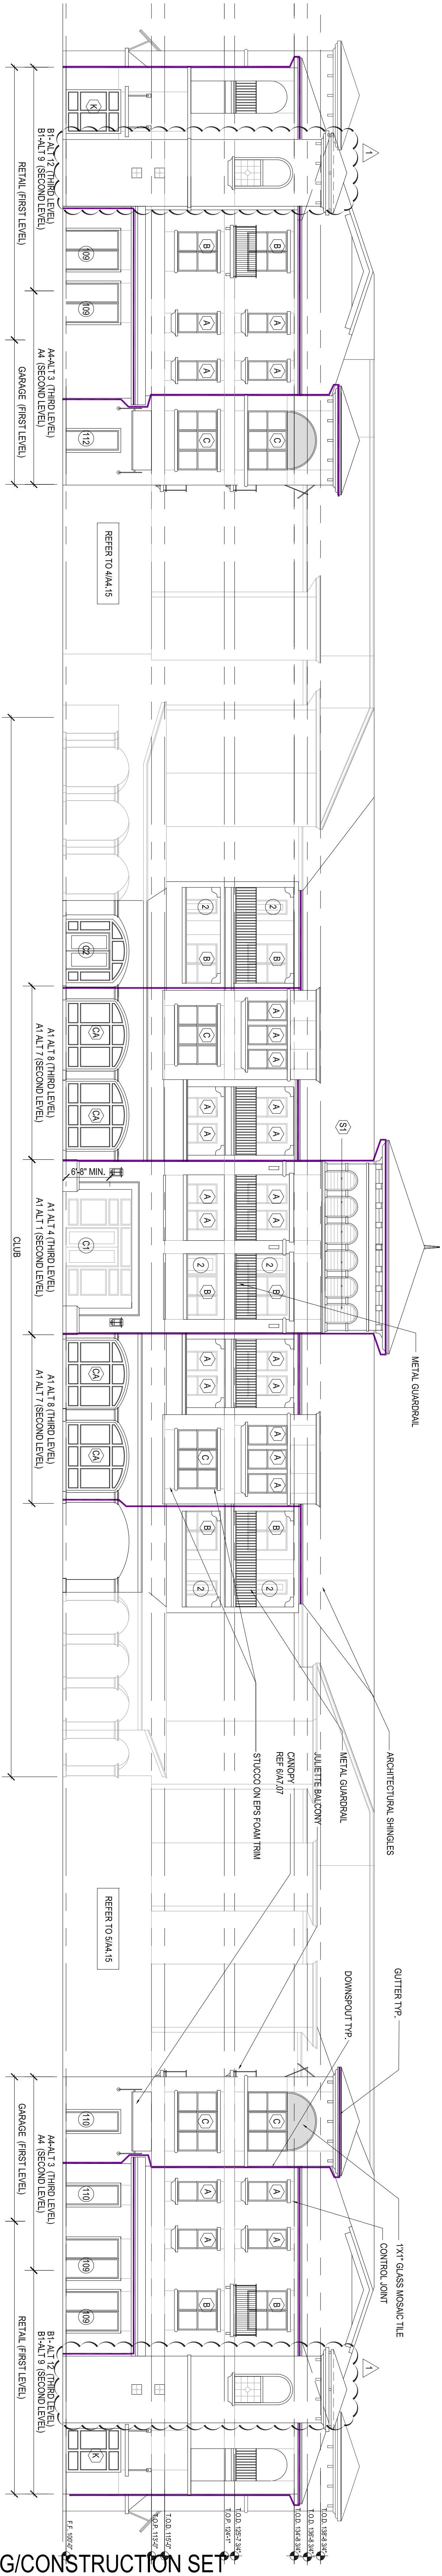


**1 BUILDING 1 - COURTYARD/CLUB ELEVATION**  
SCALE: 3/32" = 1'-0"

#	DATE	COMMENTS
1	04/10/11	OWNER COMMENTS

**THE HIGH GROVE APARTMENTS**  
BATON ROUGE, LOUISIANA  
High Grove Baton Rouge, LLC.

**HUMPHREYS & PARTNERS ARCHITECTS, L.L.C.**  
603 JULIA STREET • NEW ORLEANS, LOUISIANA 70130  
(504) 717-4700 • (504) 558-7762 FAX  
DALLAS • ORLANDO • NEW ORLEANS  
IRVINE • PHOENIX  
www.humphreys.com

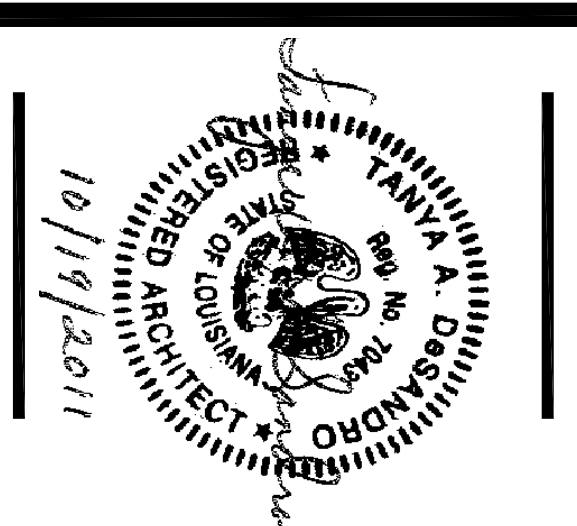

HUD CLOSING/CONSTRUCTION SET  
SHEET NO. **A4.15**  
SHEET CONTENTS:  
BLDG 1  
COURTYARD ELEVATIONS

