"WHITE BOX" PANEL RETAIL "A"

PANEL A	N-1	120/208V	3 PH	4W			
400 MLO	SURFACE	42 KAIC					
CKT	LOAD	BKR	WIRE	CKT	LOAD	BKR	WIRE
1	LTG	20/1	1/2"C#12	2	LTG	20/1	1/2"C#12
3	LTG	20/1	1/2"C#12	4	LTG	20/1	1/2"C#12
5	LTG	20/1	1/2"C#12	6	LTG	20/1	1/2"C#12
7	LTG	20/1	1/2"C#12	8	LTG	20/1	1/2"C#12
9	LTG	20/1	1/2"C#12	10	LTG	20/1	1/2"C#12
11	SPARE	20/1	1/2"C#12	12	SPARE	20/1	1/2"C#12
13	SPARE	20/1	1/2"C#12	14	SPARE	20/1	1/2"C#12
15	SPARE	20/1	1/2"C#12	16	SPARE	20/1	1/2"C#12
17	SIGN (TC)	20/1	1/2"C#12	18	SPARE	20/1	1/2"C#12
19	RECEPTACLE	20/1	1/2"C#12	20	SPARE	20/1	1/2"C#12
21	RECEPTACLE	20/1	1/2"C#12	22	SPARE	20/1	1/2"C#12
23	RECEPTACLE	20/1	1/2"C#12	24	SPARE	20/1	1/2"C#12
25	RECEPTACLE	20/1	1/2"C#12	26	SPARE	20/1	1/2"C#12
27	RECEPTACLE	20/1	1/2"C#12	28	SPARE	20/1	1/2"C#12
29	RECEPTACLE	20/1	1/2"C#12	30	SPARE	20/1	1/2"C#12
31	RECEPTACLE	20/1	1/2"C#12	32	SPARE	20/1	1/2"C#12
33	SPARE	20/1	1/2"C#12	34	SPARE	20/1	1/2"C#12
35	SPARE	20/1	1/2"C#12	36	SPARE	20/1	1/2"C#12
37	SPARE	20/1	1/2"C#12	38	EXT. LTG (PEC)	20/1	1/2"C#12
39	SPARE	20/1	1/2"C#12	40	SUB PNL	200/3	2"C#3/0
41	SPARE	20/1	1/2"C#12	42	--		2"C#3/0

"WHITE BOX" RETAIL "A" SUB PNL

PANEL SUB	N-1	120/208V	3 PH	4W			
200 MLO	SURFACE	42 KAIC					
CKT	LOAD	BKR	WIRE	CKT	LOAD	BKR	WIRE
1	A/C #1	60/2	3/4"C#6	2	AHU-1	60/2	3/4"C#6
3	--		3/4"C#6	4	--		3/4"C#6
5	A/C #2	60/2	3/4"C#6	6	--	40/2	3/4"C#8
7	--		3/4"C#6	8	--		3/4"C#8
9	A/C #3	60/2	3/4"C#6	10	AHU-2	60/2	3/4"C#6
11	--		3/4"C#6	12	--		3/4"C#6
13	A/C #4	60/2	3/4"C#6	14	--	40/2	3/4"C#8
15	--		3/4"C#6	16	--		3/4"C#8
17	SPARE	20/1	1/2"C#12	18	AHU-3	60/2	3/4"C#6
19	SPARE	20/1	1/2"C#12	20	--		3/4"C#6
21	SPARE	20/1	1/2"C#12	22	--	40/2	3/4"C#8
23	SPARE	20/1	1/2"C#12	24	--		3/4"C#8
25	WH	80/2	1"C#4	26	AHU-4	60/2	3/4"C#6
27	--		1"C#4	28	--		3/4"C#6
29				30	--	40/2	3/4"C#8
31				32	--		3/4"C#8
33				34	--	20/1	1/2"C#12
35				36			
37				38			
39				40			
41				42			

"WHITE BOX" PANEL RETAIL "B", "C", "E"

PNL B/C/E	N-1	120/208V	3 PH	4W			
100 MLO	SURFACE	42 KAIC					
CKT	LOAD	BKR	WIRE	CKT	LOAD	BKR	WIRE
1	A/C #1	60/2	3/4"C#6	2	AHU-1	60/2	3/4"C#6
3	--		3/4"C#6	4	--		3/4"C#6
5	RECEPTACLE	20/1	1/2"C#12	6	--	40/2	3/4"C#8
7	RECEPTACLE	20/1	1/2"C#12	8	--		3/4"C#8
9	RECEPTACLE	20/1	1/2"C#12	10	SPARE	20/1	1/2"C#12
11	RECEPTACLE	20/1	1/2"C#12	12	SPARE	20/1	1/2"C#12
13				14	SPARE	20/1	1/2"C#12
15				16	SPARE	20/1	1/2"C#12
17	LTG	20/1	1/2"C#12	18	SPARE	20/1	1/2"C#12
19	LTG	20/1	1/2"C#12	20	SPARE	20/1	1/2"C#12
21	LTG	20/1	1/2"C#12	22	SPARE	20/1	1/2"C#12
23	SIGN	20/1	1/2"C#12	24	SPARE	20/1	1/2"C#12
25	WH	40/2	3/4"C8	26	SPARE	20/1	1/2"C#12
27	--		3/4"C8	28	SPARE	20/1	1/2"C#12
29	SPARE	20/1	1/2"C#12	30	SPARE	20/1	1/2"C#12
31	SPARE	20/1	1/2"C#12	32	SPARE	20/1	1/2"C#12
33	SPARE	20/1	1/2"C#12	34	SPARE	20/1	1/2"C#12
35				36			
37				38			
39				40			
41				42			

"WHITE BOX" PANEL RETAIL "F"

PANEL A	N-1	120/208V	3 PH	4W			
400 MLO	SURFACE	42 KAIC					
CKT	LOAD	BKR	WIRE	CKT	LOAD	BKR	WIRE
1	LTG	20/1	1/2"C#12	2	LTG	20/1	1/2"C#12
3	LTG	20/1	1/2"C#12	4	LTG	20/1	1/2"C#12
5	LTG	20/1	1/2"C#12	6	LTG	20/1	1/2"C#12
7	LTG	20/1	1/2"C#12	8	LTG	20/1	1/2"C#12
9	LTG	20/1	1/2"C#12	10	LTG	20/1	1/2"C#12
11	SPARE	20/1	1/2"C#12	12	SPARE	20/1	1/2"C#12
13	SPARE	20/1	1/2"C#12	14	SPARE	20/1	1/2"C#12
15	SPARE	20/1	1/2"C#12	16	SPARE	20/1	1/2"C#12
17	SIGN (TC)	20/1	1/2"C#12	18	SPARE	20/1	1/2"C#12
19	RECEPTACLE	20/1	1/2"C#12	20	SPARE	20/1	1/2"C#12
21	RECEPTACLE	20/1	1/2"C#12	22	SPARE	20/1	1/2"C#12
23	RECEPTACLE	20/1	1/2"C#12	24	SPARE	20/1	1/2"C#12
25	RECEPTACLE	20/1	1/2"C#12	26	SPARE	20/1	1/2"C#12
27	RECEPTACLE	20/1	1/2"C#12	28	SPARE	20/1	1/2"C#12
29	RECEPTACLE	20/1	1/2"C#12	30	SPARE	20/1	1/2"C#12
31	RECEPTACLE	20/1	1/2"C#12	32	SPARE	20/1	1/2"C#12
33	SPARE	20/1	1/2"C#12	34	SPARE	20/1	1/2"C#12
35	SPARE	20/1	1/2"C#12	36	SPARE	20/1	1/2"C#12
37	SPARE	20/1	1/2"C#12	38	EXT. LTG (PEC)	20/1	1/2"C#12
39	SPARE	20/1	1/2"C#12	40	SUB PNL	125/3	2"C#1
41	SPARE	20/1	1/2"C#12	42	--		2"C#1

"WHITE BOX" RETAIL "F" SUB PNL

PANEL SUB	N-1	120/208V	3 PH	4W			
200 MLO	SURFACE	42 KAIC					
CKT	LOAD	BKR	WIRE	CKT	LOAD	BKR	WIRE
1	A/C #1	60/2	3/4"C#6	2	AHU-1	60/2	3/4"C#6
3	--		3/4"C#6	4	--		3/4"C#6
5	A/C #2	60/2	3/4"C#6	6	--	40/2	3/4"C#8
7	--		3/4"C#6	8	--		3/4"C#8
9	A/C #3	60/2	3/4"C#6	10	AHU-2	60/2	3/4"C#6
11	--		3/4"C#6	12	--		3/4"C#6
13				14	--	40/2	3/4"C#8
15				16	--		3/4"C#8
17	SPARE	20/1	1/2"C#12	18	AHU-3	60/2	3/4"C#6
19	SPARE	20/1	1/2"C#12	20	--		3/4"C#6
21	SPARE	20/1	1/2"C#12	22	--	40/2	3/4"C#8
23	SPARE	20/1	1/2"C#12	24	--		3/4"C#8
25	WH	80/2	1"C#4	26			
27	--		1"C#4	28			
29				30			
31				32			
33				34			
35				36			
37				38			
39				40			
41				42			

"WHITE BOX" PANEL RETAIL "D"

PANEL D	N-1	120/208V	3 PH	4W			
200 MLO	SURFACE	42 KAIC					
CKT	LOAD	BKR	WIRE	CKT	LOAD	BKR	WIRE
1	A/C #1	60/2	3/4"C#6	2	AHU-1	60/2	3/4"C#6
3	--		3/4"C#6	4	--		3/4"C#6
5	RECEPTACLE	20/1	1/2"C#12	6	--	40/2	3/4"C#8
7	RECEPTACLE	20/1	1/2"C#12	8	--		3/4"C#8
9	RECEPTACLE	20/1	1/2"C#12	10	RECEPTACLE	20/1	1/2"C#12
11	RECEPTACLE	20/1	1/2"C#12	12	RECEPTACLE	20/1	1/2"C#12
13	LTG	20/1	1/2"C#12	14	SPARE	20/1	1/2"C#12
15	LTG	20/1	1/2"C#12	16	SPARE	20/1	1/2"C#12
17	LTG	20/1	1/2"C#12	18	SPARE	20/1	1/2"C#12
19	LTG	20/1	1/2"C#12	20	SPARE	20/1	1/2"C#12
21	LTG	20/1	1/2"C#12	22	SPARE	20/1	1/2"C#12
23	SIGN	20/1	1/2"C#12	24	SPARE	20/1	1/2"C#12
25	WH	40/2	3/4"C8	26	SPARE	20/1	1/2"C#12
27	--		3/4"C8	28	SPARE	20/1	1/2"C#12
29	SPARE	20/1	1/2"C#12	30	SPARE	20/1	1/2"C#12
31	SPARE	20/1	1/2"C#12	32	SPARE	20/1	1/2"C#12
33	SPARE	20/1	1/2"C#12	34	SPARE	20/1	1/2"C#12
35	A/C #2	60/2		36	AHU-2	60/2	3/4"C#6
37	--			38	--		3/4"C#6
39				40	--	40/2	3/4"C#8
41				42	--		3/4"C#8

RETAIL HOUSE PANEL (TYP)

	100 AMP MCB	CIR. BKR.	MAX. LOAD	CIR. NO.	120/208v/3Ø/4w 10 KAIC FULLY RATED	CIR. NO.	MAX. LOAD	CIR. BKR.	SURFACE MTD NEMA-3R
(PEC)	BACK EXT. LTG	20	600	1		2	1200	20	BLDG SIGN
(PEC)	FRONT EXT LTG	20	600	3		4	1200	20	INT LTG (TIMMER)
	SERV. GFI	20	1080	5		6	1200	20	SIGN
	SERV. GFI	20	1080	7		8			SPACE
	1.5 TON	20	1040	9		10			SPACE
	--3/4"C #12	20	1040	11		12	1200	20	AHU
	3 TON	40	1872	13		14	1200	20	AHU
	--3/4"C # 10	40	1872	15		16	1200	20	AHU
	3 TON	40	1872	17		18	1200	20	AHU
	--3/4"C # 10	40	1872	19		20	1500	20	HTR
	3 TON	40	1872	21		22	1500	20	HTR
	--3/4"C # 10	40	1872	23		24	1500	20	HTR
	SPARE	20		25		26	3789	60	REFR. COMPACTOR
	SPARE	20		27		28	3789	60	--
	SPARE	20		29		30	3789	60	1-1/2" 4#8M 1#10G

ALL WIRE IS THWN COPPER. 1/2"C. #12 MINIMUM UNLESS NOTED OTHERWISE

"WHITE BOX" PANEL RETAIL "G", "H", "I"

PANEL D	N-1	120/208V	3 PH	4W			
200 MLO	SURFACE	42 KAIC					
CKT	LOAD	BKR	WIRE	CKT	LOAD	BKR	WIRE
1	A/C #1	60/2	3/4"C#6	2	AHU-1	60/2	3/4"C#6
3	--		3/4"C#6	4	--		3/4"C#6
5	RECEPTACLE	20/1	1/2"C#12	6	--	40/2	3/4"C#8
7	RECEPTACLE	20/1	1/2"C#12	8	--		3/4"C#8
9	RECEPTACLE	20/1	1/2"C#12	10	RECEPTACLE	20/1	1/2"C#12
11	RECEPTACLE	20/1	1/2"C#12	12	RECEPTACLE	20/1	1/2"C#12
13	LTG	20/1	1/2"C#12	14	SPARE	20/1	1/2"C#12
15	LTG	20/1	1/2"C#12	16	SPARE	20/1	1/2"C#12
17	LTG	20/1	1/2"C#12	18	SPARE	20/1	1/2"C#12
19	LTG	20/1	1/2"C#12	20	SPARE	20/1	1/2"C#12
21	LTG	20/1	1/2"C#12	22	SPARE	20/1	1/2"C#12
23	SIGN	20/1	1/2"C#12	24	SPARE	20/1	1/2"C#12
25	WH	40/2	3/4"C8	26	SPARE	20/1	1/2"C#12
27	--		3/4"C8	28	SPARE	20/1	1/2"C#12
29	SPARE	20/1	1/2"C#12	30	SPARE	20/1	1/2"C#12
31	SPARE	20/1	1/2"C#12	32	SPARE	20/1	1/2"C#12
33	SPARE	20/1	1/2"C#12	34	SPARE	20/1	1/2"C#12
35	A/C #2	60/2		36	AHU-2	60/2	3/4"C#6
37	--			38	--		3/4"C#6
39				40	--	40/2	3/4"C#8
41				42	--		3/4"C#8

RETAIL "WHITE BOX" LOAD ANALYSIS

RETAIL A LOAD ANALYSIS

DESCRIPTION	SQ.FT	D.F.				
LIGHTING	5147 @	2 VA PER SQ.FT.	125%	=	12867.5	
RECEPTACLE	5147 @	1 VA PER SQ.FT.	100%	=	5147	
	QTY	LOAD				
TENANT SIGNS	1 x	1200 VA @	125%	=	1500	
HVAC HEATING	4 x	11250 VA @	100%	=	45000	
WATER HEATING	1 x	12500 VA @	100%	=	12500	
MISC LOAD	1 x	20000 VA @	100%	=	20000	
			TOTAL VA =		97,015	
		@ 120/208V, 3 PH			269	AMPS

RETAIL C LOAD ANALYSIS

DESCRIPTION	SQ.FT	D.F.				
LIGHTING	1604 @	3 VA PER SQ.FT.	125%	=	6015	
RECEPTACLE	1604 @	1 VA PER SQ.FT.	100%	=	1604	
	QTY	LOAD				
TENANT SIGNS	1 x	1200 VA @	125%	=	1500	
HVAC HEATING	1 x	11250 VA @	100%	=	11250	
WATER HEATING	1 x	4500 VA @	100%	=	4500	
MISC LOAD	1 x	10000 VA @	100%	=	10000	
			TOTAL VA =		34,869	
		@ 120/208V, 3 PH			97	AMPS

RETAIL B LOAD ANALYSIS

DESCRIPTION	SQ.FT	D.F.				
LIGHTING	1360 @	3 VA PER SQ.FT.	125%	=	5100	
RECEPTACLE	1360 @	1 VA PER SQ.FT.	100%	=	1360	
	QTY	LOAD				
TENANT SIGNS	1 x	1200 VA @	125%	=	1500	
HVAC HEATING	1 x	11250 VA @	100%	=	11250	
WATER HEATING	1 x	4500 VA @	100%	=	4500	
MISC LOAD	1 x	10000 VA @	100%	=	10000	
			TOTAL VA =		33,710	
		@ 120/208V, 3 PH			94	AMPS

RETAIL D LOAD ANALYSIS

DESCRIPTION	SQ.FT	D.F.				
LIGHTING	3322 @	3 VA PER SQ.FT.	125%	=	12457.5	
RECEPTACLE	3322 @	1 VA PER SQ.FT.	100%	=	3322	
	QTY	LOAD				
TENANT SIGNS	1 x	1200 VA @	125%	=	1500	
HVAC HEATING	2 x	11250 VA @	100%	=	22500	
WATER HEATING	1 x	4500 VA @	100%	=	4500	
MISC LOAD	1 x	10000 VA @	100%	=	10000	
			TOTAL VA =		54,280	
		@ 120/208V, 3 PH			151	AMPS

RETAIL E LOAD ANALYSIS

DESCRIPTION	SQ.FT	D.F.				
LIGHTING	1035 @	2 VA PER SQ.FT.	125%	=	2587.5	
RECEPTACLE	1035 @	1 VA PER SQ.FT.	100%	=	1035	
	QTY	LOAD				
TENANT SIGNS	1 x	1200 VA @	125%	=	1500	
HVAC HEATING	1 x	11250 VA @	100%	=	11250	
WATER HEATING	1 x	12.5 VA @	100%	=	12.5	
MISC LOAD	1 x	10000 VA @	100%	=	10000	
			TOTAL VA =		26,385	
		@ 120/208V, 3 PH			73	AMPS

RETAIL G LOAD ANALYSIS

DESCRIPTION	SQ.FT	D.F.				
LIGHTING	2636 @	3 VA PER SQ.FT.	125%	=	9885	
RECEPTACLE	2636 @	1 VA PER SQ.FT.	100%	=	2636	
	QTY	LOAD				
TENANT SIGNS	1 x	1200 VA @	125%	=	1500	
HVAC HEATING	2 x	11250 VA @	100%	=	22500	
WATER HEATING	1 x	4500 VA @	100%	=	4500	
MISC LOAD	1 x	10000 VA @	100%	=	10000	
			TOTAL VA =		51,021	
		@ 120/208V, 3 PH			142	AMPS

RETAIL F LOAD ANALYSIS

DESCRIPTION	SQ.FT	D.F.				
LIGHTING	3148 @	3 VA PER SQ.FT.	125%	=	11805	
RECEPTACLE	3148 @	1 VA PER SQ.FT.	100%	=	3148	
	QTY	LOAD				
TENANT SIGNS	1 x	1200 VA @	125%	=	1500	
HVAC HEATING	3 x	11250 VA @	100%	=	33750	
WATER HEATING	1 x	12500 VA @	100%	=	12500	
MISC LOAD	2 x	10000 VA @	100%	=	20000	
			TOTAL VA =		82,703	
		@ 120/208V, 3 PH			230	AMPS

RETAIL H LOAD ANALYSIS

DESCRIPTION	SQ.FT	D.F.				
LIGHTING	2848 @	3 VA PER SQ.FT.	125%	=	10680	
RECEPTACLE	2848 @	1 VA PER SQ.FT.	100%	=	2848	
	QTY	LOAD				
TENANT SIGNS	1 x	1200 VA @	125%	=	1500	
HVAC HEATING	2 x	11250 VA @	100%	=	22500	
WATER HEATING	1 x	4500 VA @	100%	=	4500	
MISC LOAD	1 x	10000 VA @	100%	=	10000	
			TOTAL VA =		52,028	
		@ 120/208V, 3 PH			145	AMPS

RETAIL I LOAD ANALYSIS

DESCRIPTION	SQ.FT	D.F.				
LIGHTING	2096 @	3 VA PER SQ.FT.	125%	=	7860	
RECEPTACLE	2096 @	1 VA PER SQ.FT.	100%	=	2096	
	QTY	LOAD				
TENANT SIGNS	1 x	1200 VA @	125%	=	1500	
HVAC HEATING	2 x	11250 VA @	100%	=	22500	
WATER HEATING	1 x	4500 VA @	100%	=	4500	
MISC LOAD	1 x	10000 VA @	100%	=	10000	
			TOTAL VA =		48,456	
		@ 120/208V, 3 PH			135	AMPS

RETAIL HOUSE LOAD

	QTY	LOAD				
EXTERIOR LTG	3 x	1200 VA @	125% =		4500	
EXTERIOR CONV OU	6 x	180 VA @	100% =		1080	
SERVICE GFI OUTETS	6 x	180 VA @	100% =		1080	
BLDG SIGN	1 x	1200 VA @	125% =		1500	
AC(3 TON)	3 X	2100 VA @	100% =		6300	
AC(1.5 TON)	1 X	1200 VA @	100% =		1200	
ELEC HEATERS ***	3 X	1500 VA @	100%		4500	
		25% LARGEST	100% =		525	
			TOTAL VA =		20,685	
		@ 120/208V, 3 PH			57	AMPS

LIGHTING SCHEDULES (UNITS)

SYMBOL	MATERIAL	AREA/ LOCATION	VENDOR	PATTERN NAME / NUMBER	COLOR	FINISH / SIZE	MISCELLANEOUS / NOTES
	Decorative Lighting						
	L-200	Entry, Office & Hall Ceiling Mount Fixture	Per GC	ACT141	Satin Nickel	13 x 12	2-Light Ceiling Mount Fixture. (2) CFL 13W bulbs. Refer to Sheet ID-4.1-4.4 for Decorative Reflected Ceiling Plans. Can be made to be Energy Star Rated or certified.
	L-201	Dining Pendant	Per GC	ACT138	Satin Nickel	14 x 20	2-Light Ceiling Fixture. (2) CFL 13W medium base bulbs. Refer to Sheet ID-4.1-4.4 for Decorative Reflected Ceiling Plans.
	L-202	Kitchen Bar/Island Mini Pendants	Per GC	ACT140	Satin Nickel	44H x 5.25W	1-Light Mini Pendant. (1)CFL 13W bulb Mounting height to be 2'-6" above finished counter. Refer to Sheet ID-4.1-4.4 for Decorative Reflected Ceiling Plans. Can be made to be Energy Star Rated or certified.
	L-203	Kitchen Track Light	Per GC	PT4104BN	Brushed Nickel	32-7/8W X 4.75EXT X 6-1/8H	4-Light Track. (4) 40W Gu10 Bulbs. Refer to Sheet ID-4.1-4.4 for Decorative Reflected Ceiling Plans. Can be made to be Energy Star Rated or certified
	L-204	Utility & Closet Ceiling Mount Fixture	Per GC	10429BN-13W	Brushed Nickel	7.5W X 4.75H	1-Light Ceiling Mount Fixture. (1) CFL 13W bulb. Refer to Sheet ID-4.1-4.4 for Decorative Reflected Ceiling Plan. Can be made to be Energy Star Rated or certified.
	L-205	Bathroom Vanity Light	Per GC	ACT139	Satin Nickel	8H x 22.5W x 6.75	3-Light Vanity Light. (3) CFL 13W bulbs. Mounting height to be 6" above finished mirror. Mounting position down. Refer to Sheet ID-4.1-4.4 for Decorative Reflected Ceiling Plans. Can be made to be Energy Star Rated or certified.
	L-206	Bedroom & Living Room Ceiling Fan	Per GC	D552BN Fan ESLK562 Light Kit	Brushed Nickel/Maple	52"Blades	Energy Star. Cat Eye Blade Arm. 60W E12 Candelabra base. Screw in CFL will fit into A-19 socket. Refer to Sheet ID-4.1-4.4 for Decorative Reflected Ceiling Plan.
	L-207	Bathroom Ceiling Mount	Per GC	ESCM560-26-WH	White Acrylic	11" Dia	Energy Star. CFL 13w 4 pin. included. Damp Rated (1) 22W circline. Refer to Sheet ID-4.1-4.4 for Decorative Reflected Ceiling Plan. Energy Efficient

LIGHTING LEGEND & SCHEDULES (CLUB HOUSE)

SYMBOLS	MATERIAL	AREA/ LOCATION	VENDOR	PATTERN NAME / NUMBER	COLOR	FINISH / SIZE	MISCELLANEOUS / NOTES
	Decorative Lighting						
	L-100	Foyer & Rear Foyer Pendants	Per GC	Item: ACT135	Exterior Finish: BZ Bronze Interior Finish: PT Sherwin Williams SW6347 Chrysanthemum Glass: CL	14w 36h	(4) CFL 13W Bulbs. Bottom of fixture to be installed at be installed 7'-6" A.F.F. Refer to Sheet ID-4.0 for Decorative Reflected Ceiling Plan for locations, and Sheet ID-7.0 Interior Elevations.
	L-101	Clubroom Chandelier	Per GC	Item: ACT136	Finish: Hand Rubbed Bronze Fabric: 614IVY Ivory Silk Dupioni	28 x 5	Bottom of fixture to be installed at 6'-6" A.F.F. Refer to Sheet ID-4.0 for Decorative Reflected Ceiling Plan for location.
	L-102	Kitchen Pendants	Per GC	Item: ACT137	Finish: Hand Rubbed Bronze Fabric: 692 BRZ Bronze Crepe	7 x 7 x 16	Refer to Sheet ID-4.0 for Decorative Reflected Ceiling Plan. Refer to Sheet ID-7.0 for Interior Elevations. Pendants to be mounted 2'-6" above finished counter to bottom of fixture.
	L-103	Restroom Sconces	Per GC	Item: ACT132	Finish: Hand Rubbed Bronze Fabric 1: 614IVY Ivory Silk Duponi Fabric 2: 614 NPY New Penny Silk	9 x 11 x 12.5	CFL 13W Bulb (not included). Refer to Sheet ID-4.0 for Decorative Reflected Ceiling Plan & ID-7.0 Interior Elevations for locations. Bottom of sconce to be 6'-6" A.F.F.
	L-104	Fitness Ceiling Fans	Fanimation 888.567.2055	The Huxley FP5620OB	Oil Rubbed Bronze Finish Walnut Blades	52"	Refer to Sheet ID-4.0 for Decorative Reflected Ceiling Plan for locations. Energy Star Rated
	L-105	Fitness Fluorescents	Pinnacle Lighting Contact: Lighting Alliance Sheila Myers 972-456-9800 ext. 8841	Edge EX44S Direct 4x4/Staggered Lamp/Acrylic Lens Model#: EX44-A-N-2T5-4-UNV-AC48JB-1C-CC	Custom finish to match oil rubbed bronze	4"Wx8'L	Refer to Sheet ID-4.0 for Decorative Reflected Ceiling Plan for locations. Lamps: MR16
	L-106	Cyber Café Pendants	Per GC	Item: ACT133	Finish: Hand Rubbed Bronze Fabric: 328 Beige Linen	8 x 8 x 17	Qty 11 lights. Stagger heights, ranging from: 7'-0" to 8'-0" A.F.F. Max wattage is 100w, but it will accept lower wattage bulbs to help meet requirements. Refer to Sheet ID-4.0 for Decorative Reflected Ceiling Plan.
	L-107	Exterior Cave	Fanimation 888.567.2055	ZONIX™ FP4640 Wet Location	Oil Rubbed Bronze Finish Cherry Blades	52"	Qty 2 lights. To be used with Light Kit LK4620OB. Refer to Sheet ID-4.0 for Decorative Reflected Ceiling Plan.
	L-108	Office Restroom	Per GC	106138BN-252 3x13W CFL & 105252 Faux Alabaster Glass	Brushed Nickel w/ Faux Alabaster Glass	24"Wx6-5/8"Hx7"Ext	Qty 4 lights 100w Inc.

RETAIL SERVICE B (1) LINE - 208V, 3Ø - 4 W

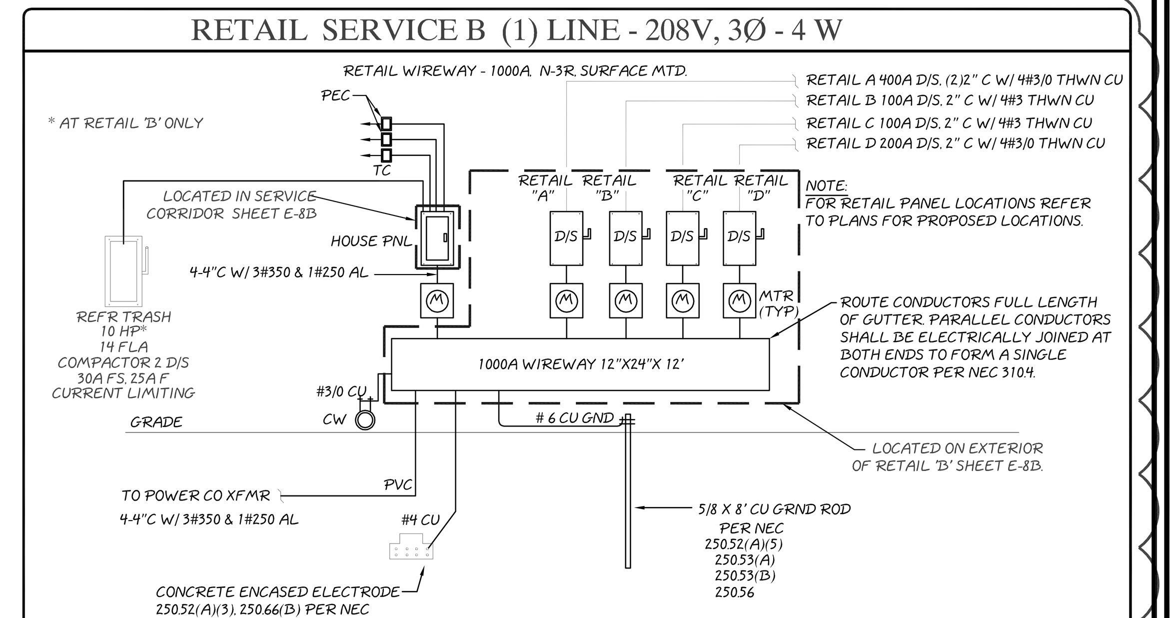

RETAIL SERVICE A (1) LINE - 208V, 3Ø - 4 W

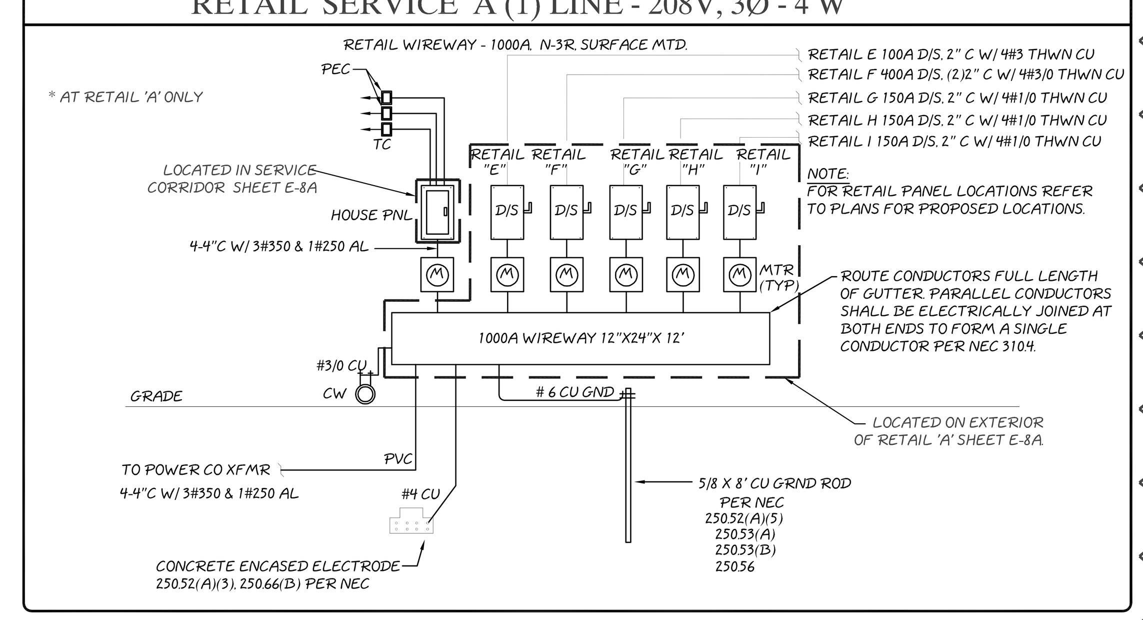

HGE CONSULTING, INC.
MEP ENGINEERS
F-7762
15603 GLEN CHASE
HOUSTON, TEXAS 77095
PHONE: 281-856-7682
FAX: 281-856-2438
EMAIL:
MEP@HGECONSULTING.COM

IF ANY OR ALL OF THIS DOCUMENT IS REPRODUCED, MODIFIED OR WRONGLY DISTRIBUTED, YOU WILL BE IN VIOLATION OF CONTRACT AND INFRINGE ON COPYRIGHT LAWS. IF YOU FEEL THAT THIS DOCUMENT HAS REACHED YOU IN ERROR PLEASE CONTACT THE ABOVE OWNER AND DESTROY THE DOCUMENT. IF YOU CHOSE NOT TO DO SO, YOU WILL BE SUBJECT TO PROSECUTION UNDER THE CURRENT COPYRIGHT LAWS.

NUMBER	DATE	REVISION	BY:
A	08/05/2011	ADDENDUM A	JG
C	10/28/2011	ADDENDUM C	JG
3	4/30/2012	COORDINATION REV#3	JG
4	7/6/2012	REFI#12 UNIT LTG FIXTURE REV	JG
15	8/27/2012	RFI#95 CARPORT OWNER REV.	JG
19	9/25/2012	RFI ELEC. AND PLUMBING	JG
20	11/12/2012	RFI-80	JG

THE HIGH GROVE APARTMENTS

BATON ROUGE, LOUISIANA

High Grove Baton Rouge, LLC.

STATE OF LOUISIANA
JAIRZINHO VASQUEZ
License No. 31867
PROFESSIONAL ENGINEER
IN
ELECTRICAL ENGINEERING
11/12/2012

○ 100% CD SET
○ PERMIT ISSUE
● CONSTRUCTION ISSUE

DRAWN BY:	JV
DATE:	08-05-2011
CHK'D BY:	JV
JOB :	589-10

E-19