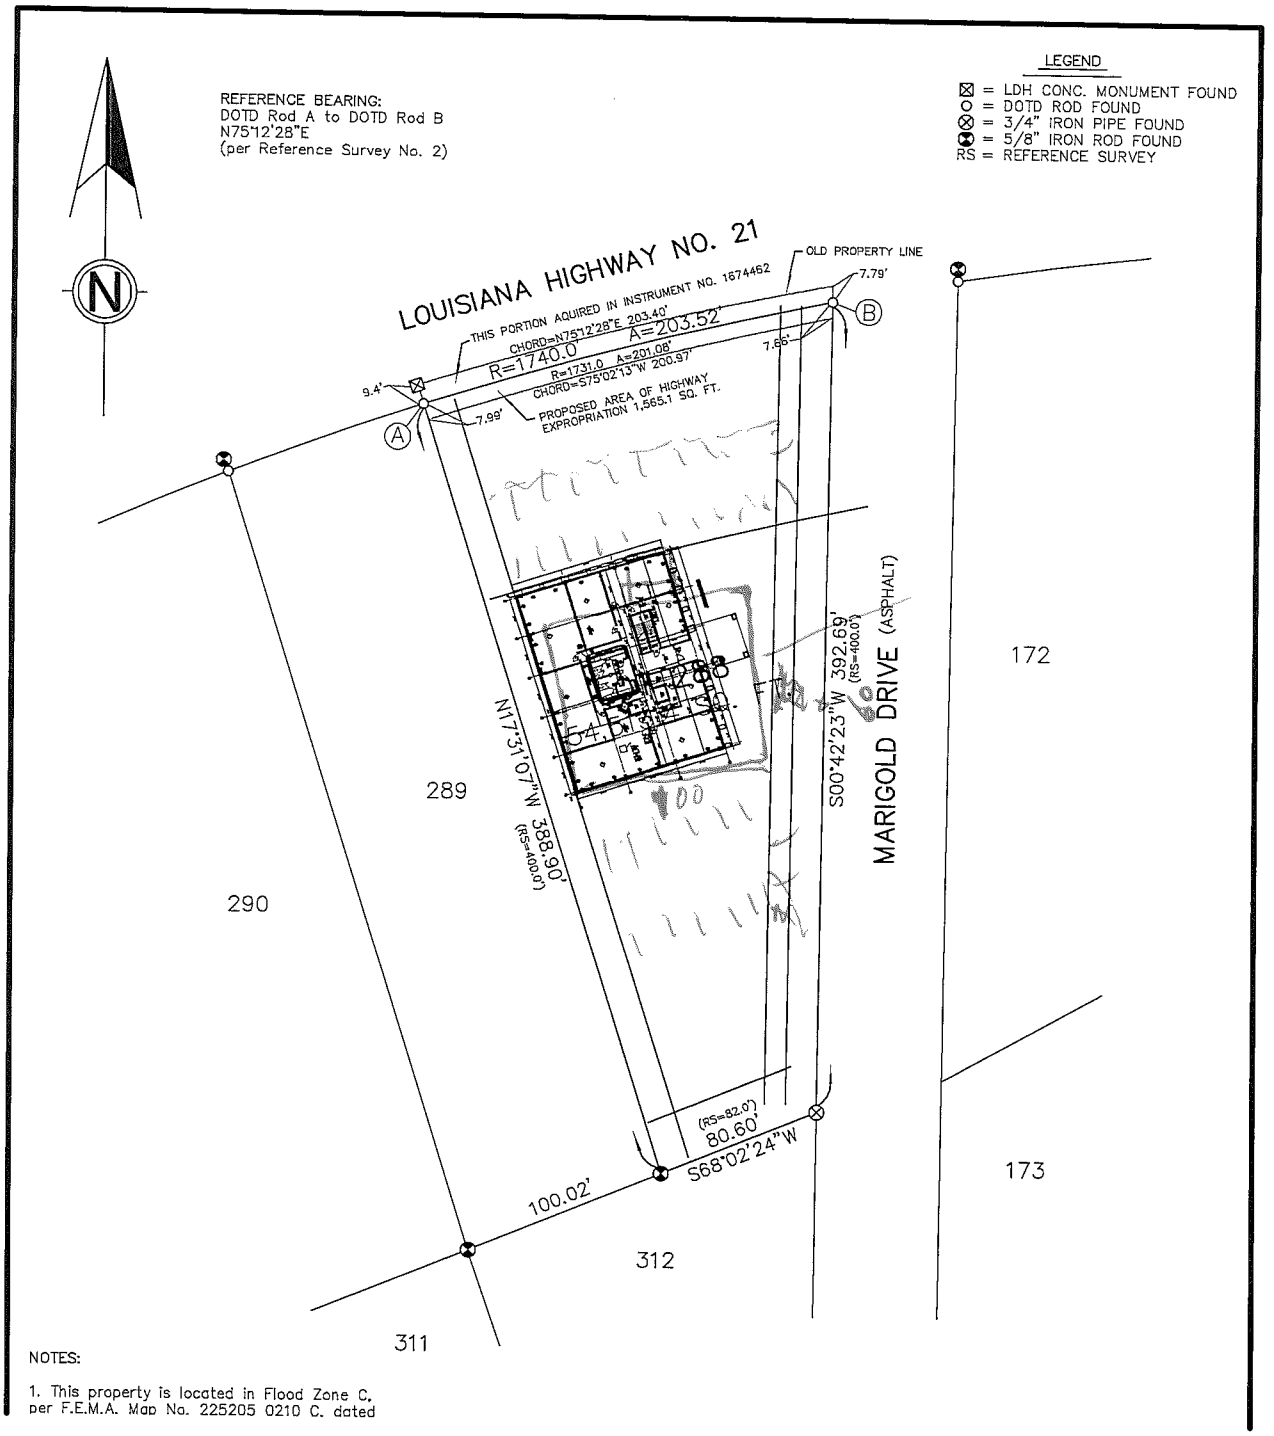

NOTES:

1. This property is located in Flood Zone C, per F.E.M.A. Map No. 225205 0210 C, dated