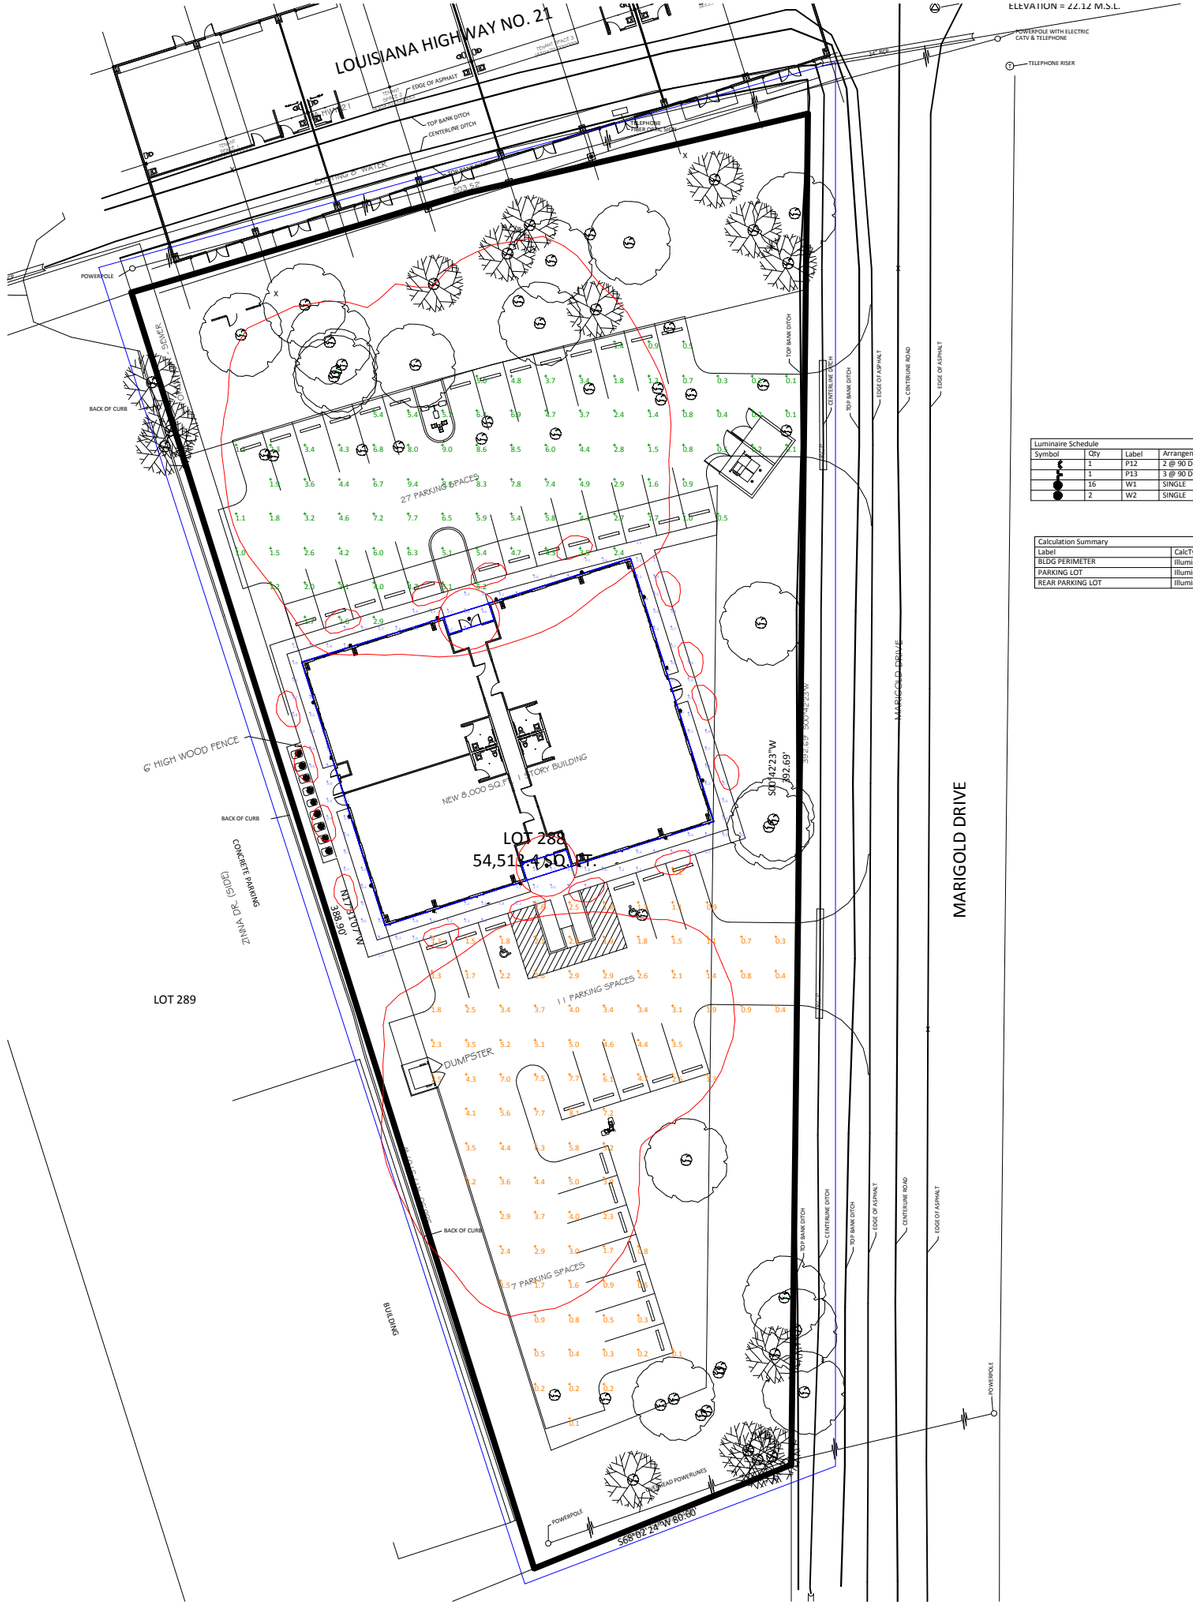

Luminaire Schedule				
Symbol	Qty	Label	Arrangement	Description
	1	P12	2 @ 90 DEGREES	LUMARK: MPTR-SL-400-MT-XX / 2@90 / SSS5A2SSFM-XX
	1	P13	3 @ 90 DEGREES	LUMARK: MPTR-SL-400-MT-XX / 3@90 / SSS5A2SSFM-XX
	16	W1	SINGLE	EVERGREEN: BAR2206_2-PL26
	2	W2	SINGLE	EVERGREEN: BAR3206_2-PL26

Calculation Summary							
Label	CalcType	Units	Avg	Max	Min	Avg/Min	Max/Min
BLDG PERIMETER	Illuminance	Fc	1.54	5.2	0.2	7.70	26.00
PARKING LOT	Illuminance	Fc	3.68	9.4	0.1	36.80	94.00
REAR PARKING LOT	Illuminance	Fc	2.69	8.1	0.1	26.90	81.00