
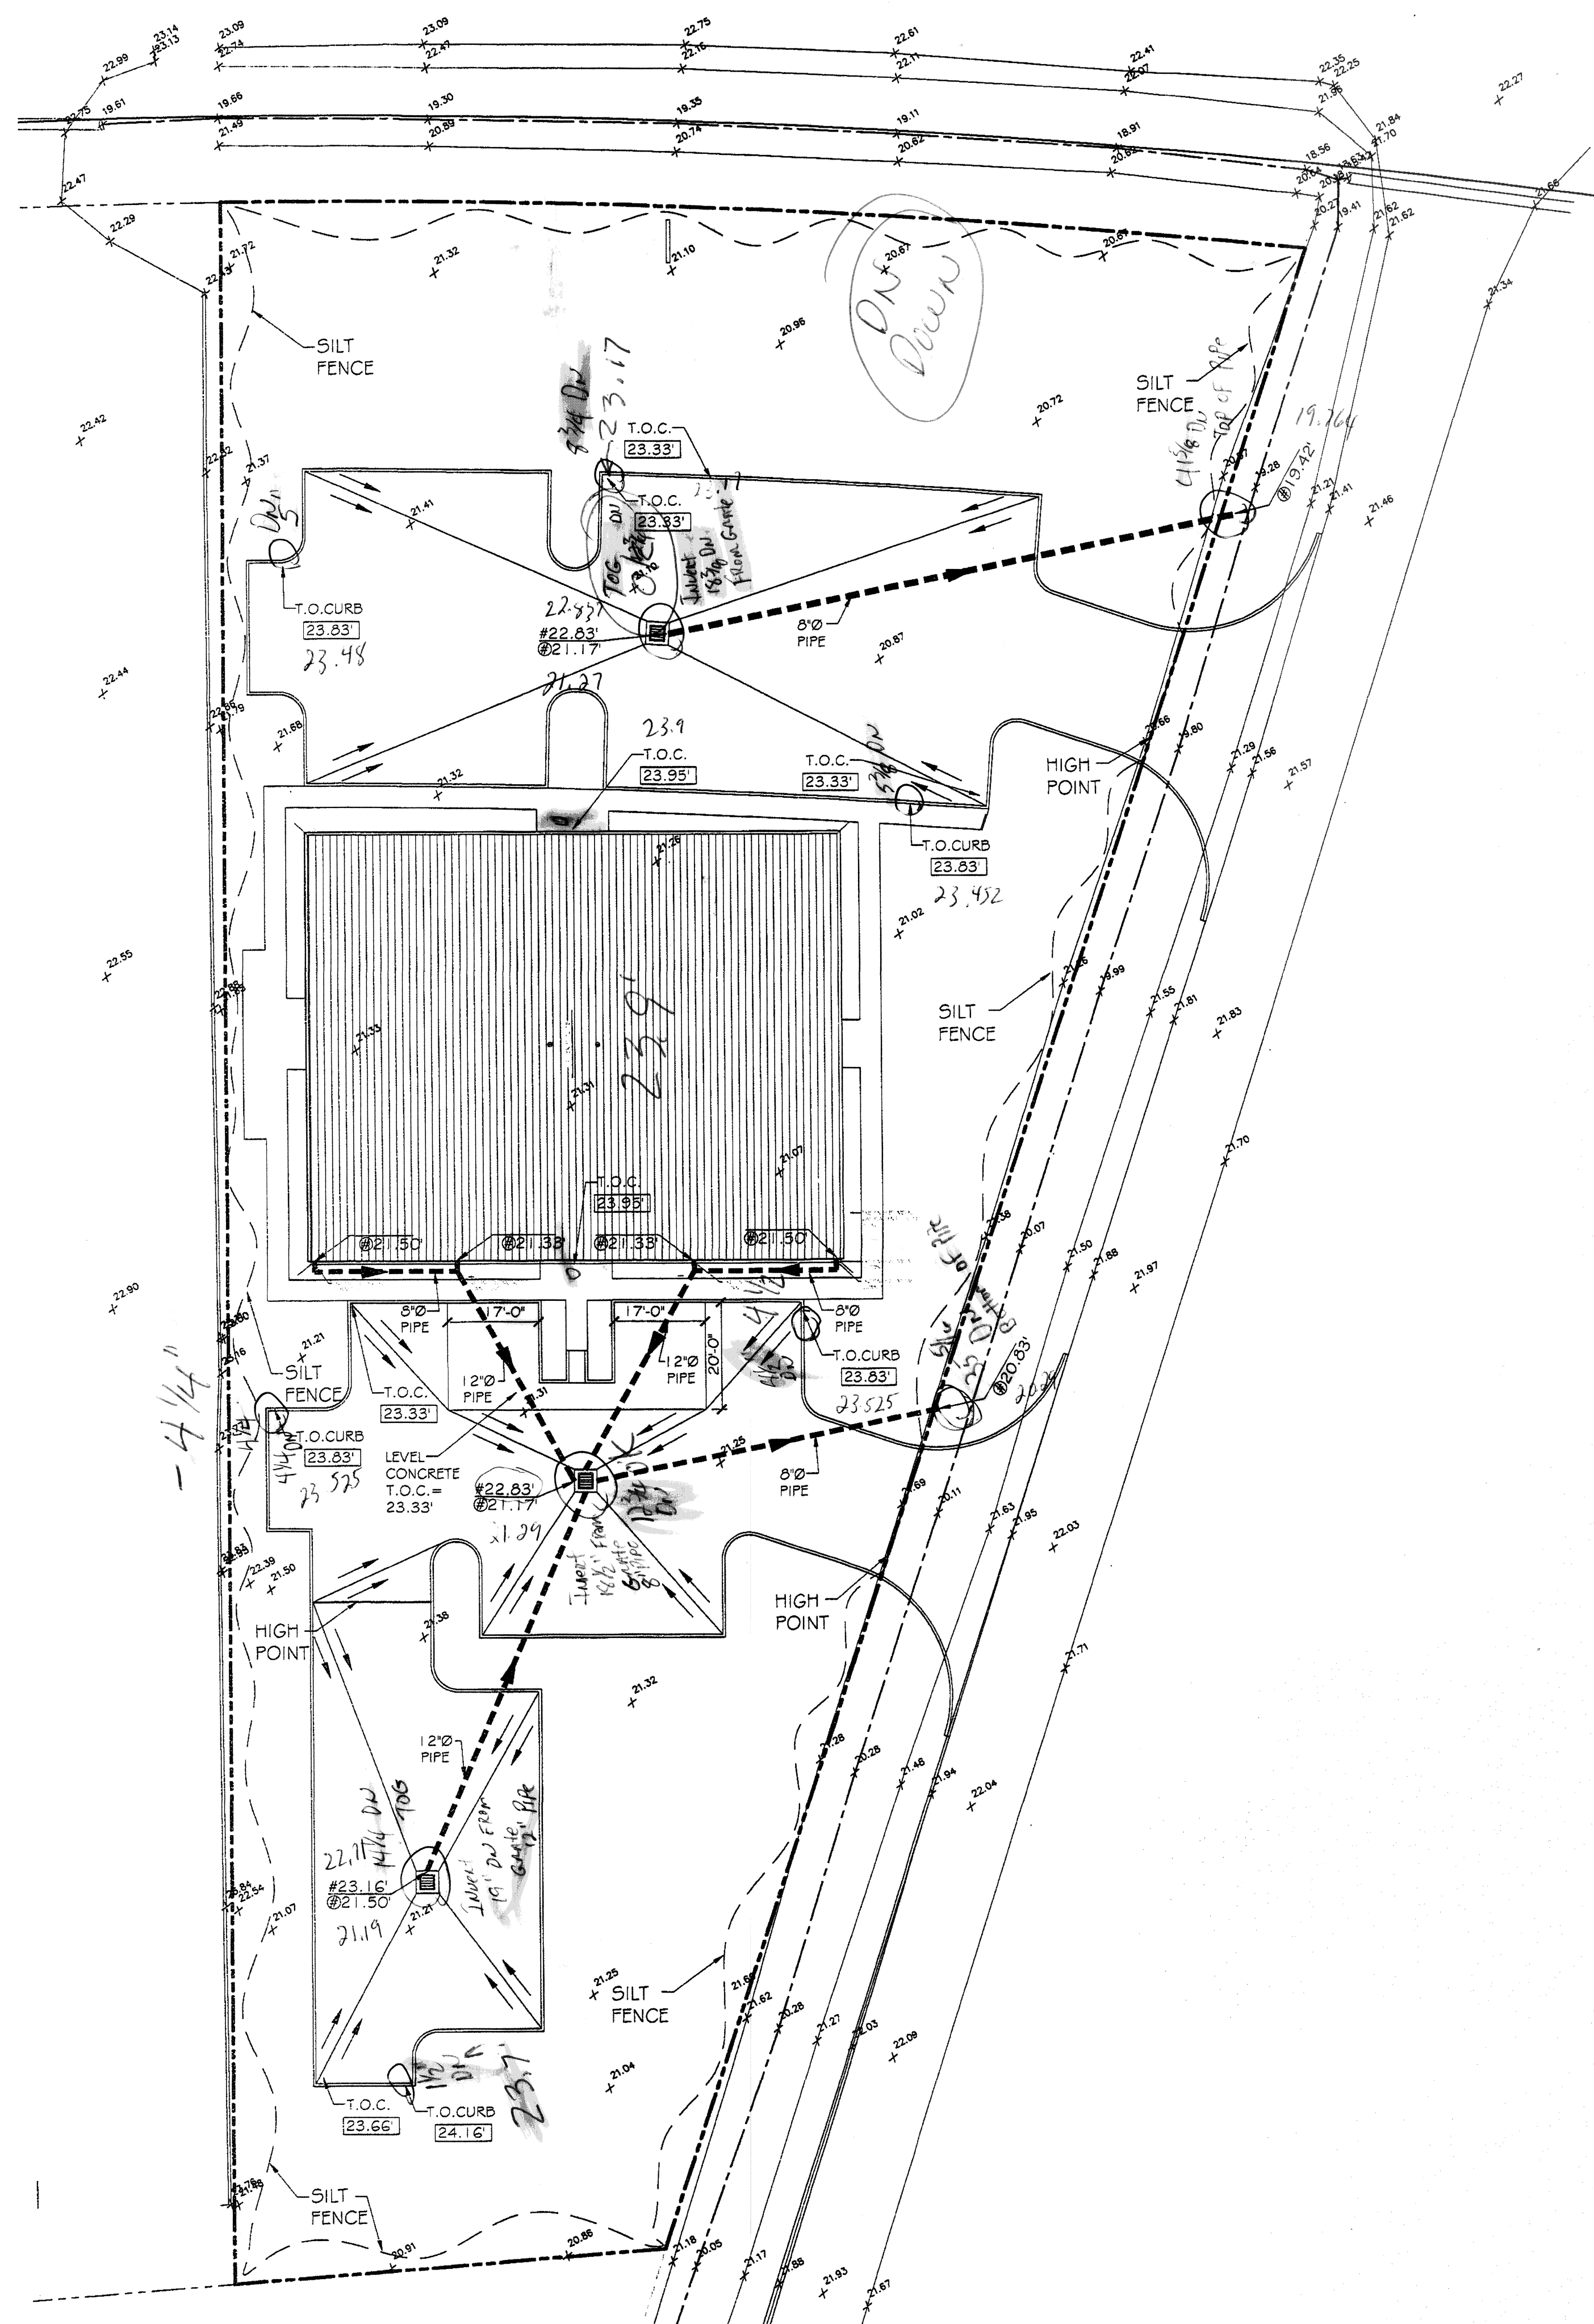


GUTTERS AND DOWN SPOUTS TO BE SEAMLESS ALUMINUM 24 GAUGE, COLOR TO BE SELECTED BY OWNER. GUTTERS TO BE "OGEE" IN CROSS SECTION, MINIMUM 6" WIDTH.

PROJECT: ADULI			
STORMWATER RUN-OFF CALCULATIONS			
Formulas used: [1] RATIONAL METHOD: $Q = AiC$			
where: Q = Peak discharge of watershed in cubic feet per second (cfs) due to maximum storm assumed.			
A = Area of watershed in acres.			
C = Coefficient of run-off [2].			
i = Intensity of rainfall in inches per hour based on concentration time [3].			
[4] $TC = \left(\frac{L}{48.3} \right)^{0.77} (1.483 S^{-0.1054})$			
where: TC = Time of concentration time required for rain falling at most remote point to reach discharge point.			
L = Site run-off coefficient based on conditions shown.			
S = Percent slope of overland flow.			
PRIOR DEVELOPMENT 25 Year Frequency			
$Q_1 = AiC$			
Watershed Surfaces $c(1) =$	0.9	sqft =	0.000 Acres
Gravel Surface $c(2) =$	0.25	sqft =	0.000 Acres
Green Space $c(3) =$	0.15	sqft =	1.251 Acres
Summary $c =$	0.15	sqft =	1.251 Acres
Duration (D) = Time of concentration (TC)			
where: $L = 385$ run-off length ft			
$c = 0.15$ run-off coef			
$S = 0.2577$ percent slope			
therefore $TC = D = 24.69$ minutes			
Expected rainfall intensity $i = 3.64$ in/hr			
$Q_1 = 0.663$ cfs			
POST DEVELOPMENT 25 Year Frequency			
$Q_2 = AiC$			
Watershed Surfaces $c(1) =$	0.9	sqft =	0.365 Acres
Gravel Surface $c(2) =$	0.25	sqft =	0.000 Acres
Green Space $c(3) =$	0.15	sqft =	0.867 Acres
Summary $c =$	0.50	sqft =	1.251 Acres
Duration (D) = Time of concentration (TC)			
where: $L = 170$ run-off length ft			
$c = 0.50$ run-off coef			
$S = 0.8824$ percent slope			
therefore $TC = D = 10.22$ minutes			
Expected rainfall intensity $i = 3.64$ in/hr			
$Q_2 = 0.276$ cfs			
DETENTION REQUIREMENTS			
Detention required $Q_2 - Q_1 = 0.387$ cfs			
ONE HOUR DETENTION: 5745.9 cuft			
DETENTION DIMENSIONS: WIDTH 84 feet, LENGTH 188 feet, DEPTH 0.37 feet			
DISCHARGE END AREA REQUIREMENTS 10 Year Frequency			
[5] $A = \frac{Q}{C_v \sqrt{2gh}}$			
where: A = Discharge Area required			
C_v = Acceleration of gravity			
C_d = Discharge coefficient			
h = Hydraulic head			
Q = Flow volume from run-off			
Pipe Servicing Site Drainage: $Q = 0.663$ cfs, $h = 1.50$ feet, $C_d = 0.62$ coefficient, $A = 0.031$ sqft, $g = 32.16$ ft/sec ²			
REQUIRED CONDUIT = 12" DIA. RIBBON ROPE			
References: 1. Chen, W. F. The Civil Engineering Handbook, 1995, Eq # 31.1, pg. 1036 2. Seelye, Elwyn E. Data Book for Civil Engineers, Vol. 1, 1960, Vol. 8, pg. 18-02 3. Seelye, Elwyn E. Data Book for Civil Engineers, Vol. 1, 1960, Fig. 8, pg. 18-01 4. Chen, W. F. The Civil Engineering Handbook, 1995, Vol. 31.2 Region Equation (n=0.013) 5. Chen, W. F. The Civil Engineering Handbook, 1995, Eq # 28.32, pg. 969			

- NOTES:
- 1) DRAIN PIPE & FITTINGS WITHIN PROPERTY LINE SHALL BE POLYVINYL CHLORIDE PLASTIC PIPE, MEETING CLASS 100 C-900 PVC.
 - 2) ELEVATIONS SHOWN ARE M.S.L.
 - 3) FIELD VERIFY ALL ELEVATIONS AND DRAINAGE SYSTEM PLACEMENT PRIOR TO START OF WORK.
 - 4) MUCK OUT 24" DEEP FOR FOUNDATION PAD MINIMUM, OR TO UNDISTURBED SOIL CAPABLE OF 1500 PSF BEARING.
 - 5) DOWN SPOUTS SHALL FLOW INTO SUB-SURFACE DRAINAGE.
 - 6) THERE IS NO EVIDENCE OF EXISTING OFF-SITE FLOW CROSSING THE PROPERTY. NEW DRAINAGE CALCULATIONS ARE DETERMINED ACCORDINGLY.

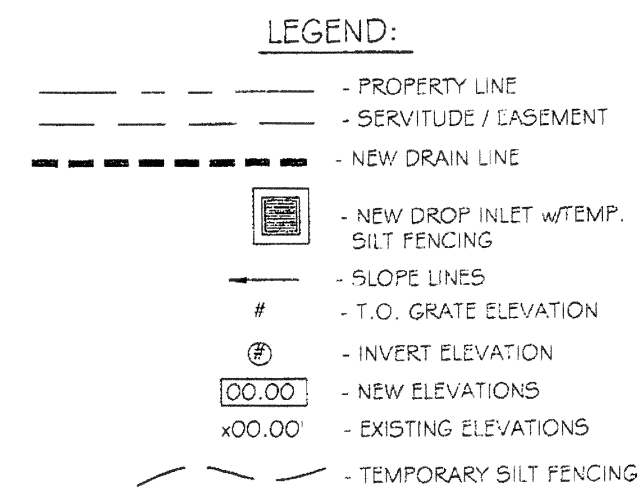

SITE DRAINAGE PLAN
SCALE: 1" = 20'

DAMMON ENGINEERING, INC.
Architects & Engineers

NEW COMMERCIAL BUILDING
DR. FARHAD ADULI
LOT 288 MARGOLD DRIVE
COVINGTON, LA

DATE: 09-23-2013
CHECKED BY: KJK

JOB NO: 2178
DRAWN BY: JTL

REVISIONS: # DESCRIPTION DATE

9/23/13

SITE DRAINAGE PLAN & DETAILS

SHEET No: 8 of 22

C4