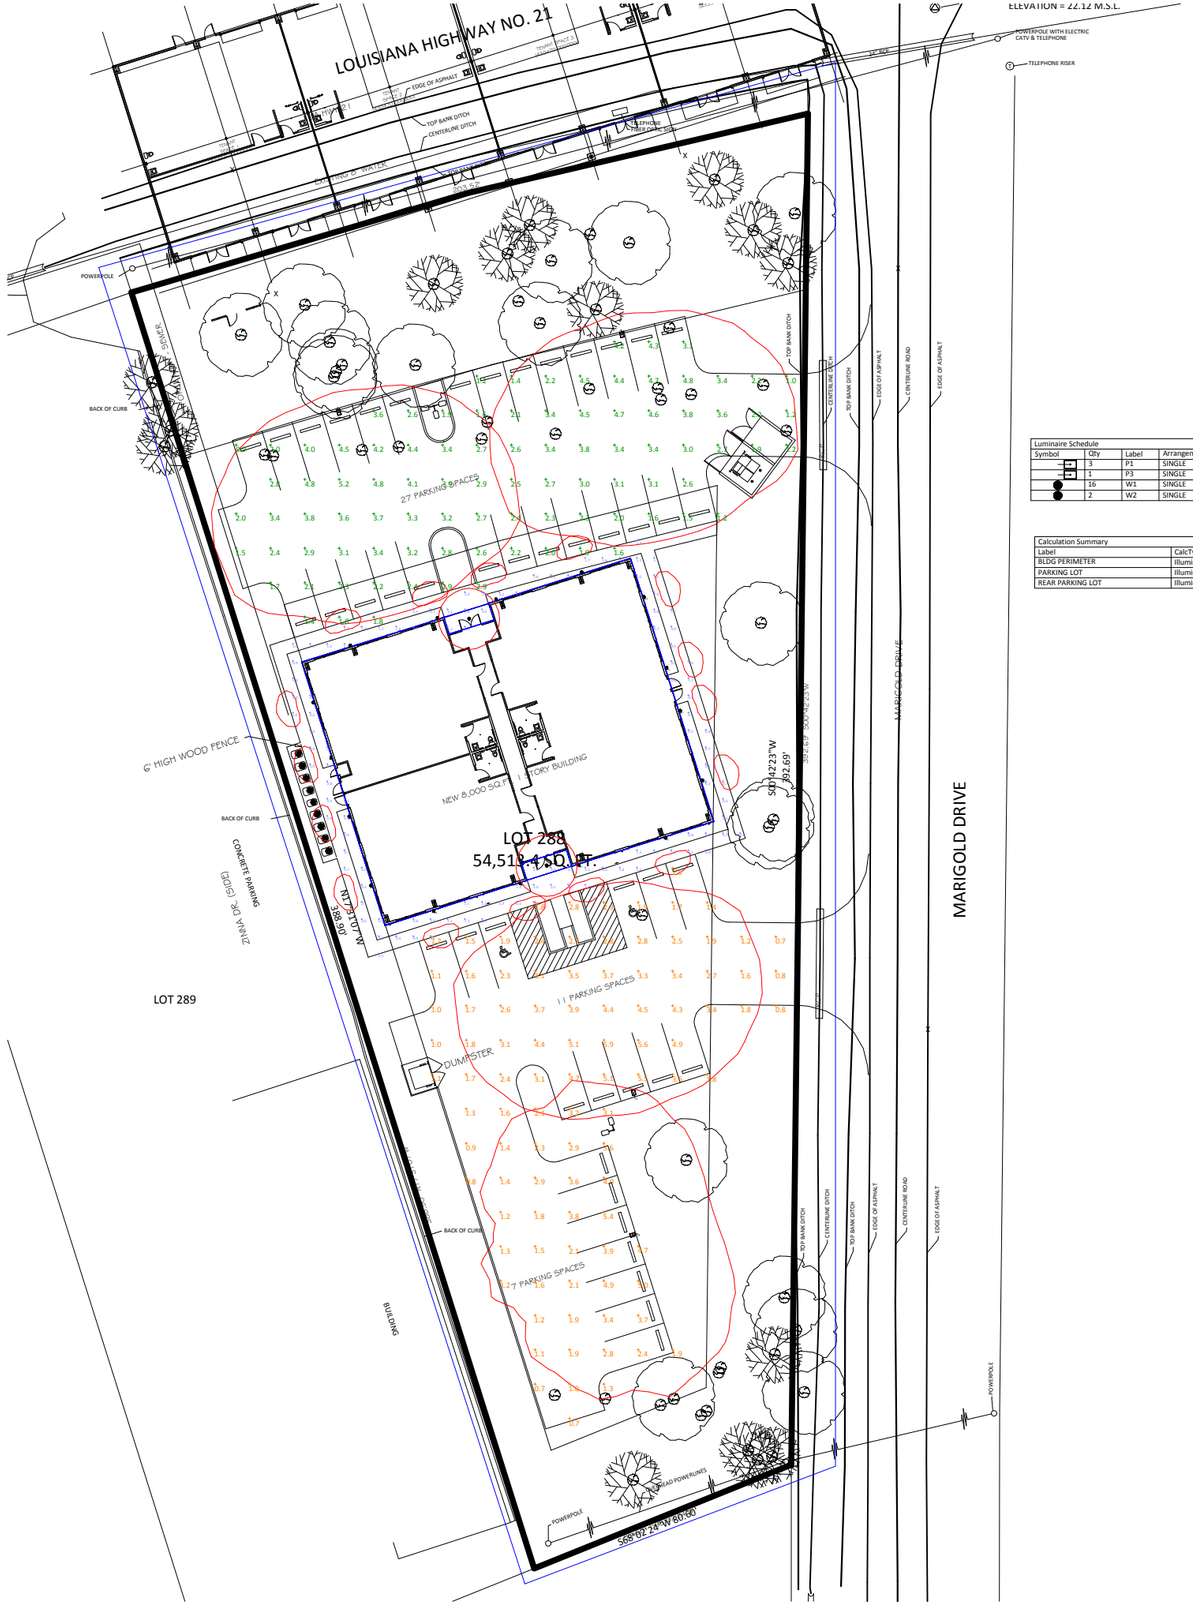

Luminaire Schedule				
Symbol	Qty	Label	Arrangement	Description
	3	P1	SINGLE	LUMARK: MPTR-SL-400-MT-XX / SSSSA2SSFM-XX
	1	P3	SINGLE	LUMARK: MPTR-3S-400-MT-XX / SSSSA2SSFM-XX
	16	W1	SINGLE	EVERGREEN: BAR220L_2-PL26
	2	W2	SINGLE	EVERGREEN: BAR320L_2-PL26

Calculation Summary							
Label	CalcType	Units	Avg	Max	Min	Avg/Min	Max/Min
BLDG PERIMETER	Illuminance	Fc	1.31	3.4	0.2	6.55	17.00
PARKING LOT	Illuminance	Fc	2.88	5.2	0.9	3.20	5.78
REAR PARKING LOT	Illuminance	Fc	2.59	5.9	0.7	3.70	8.43