Move out to pole
to make Drive Lane
larger than 30'

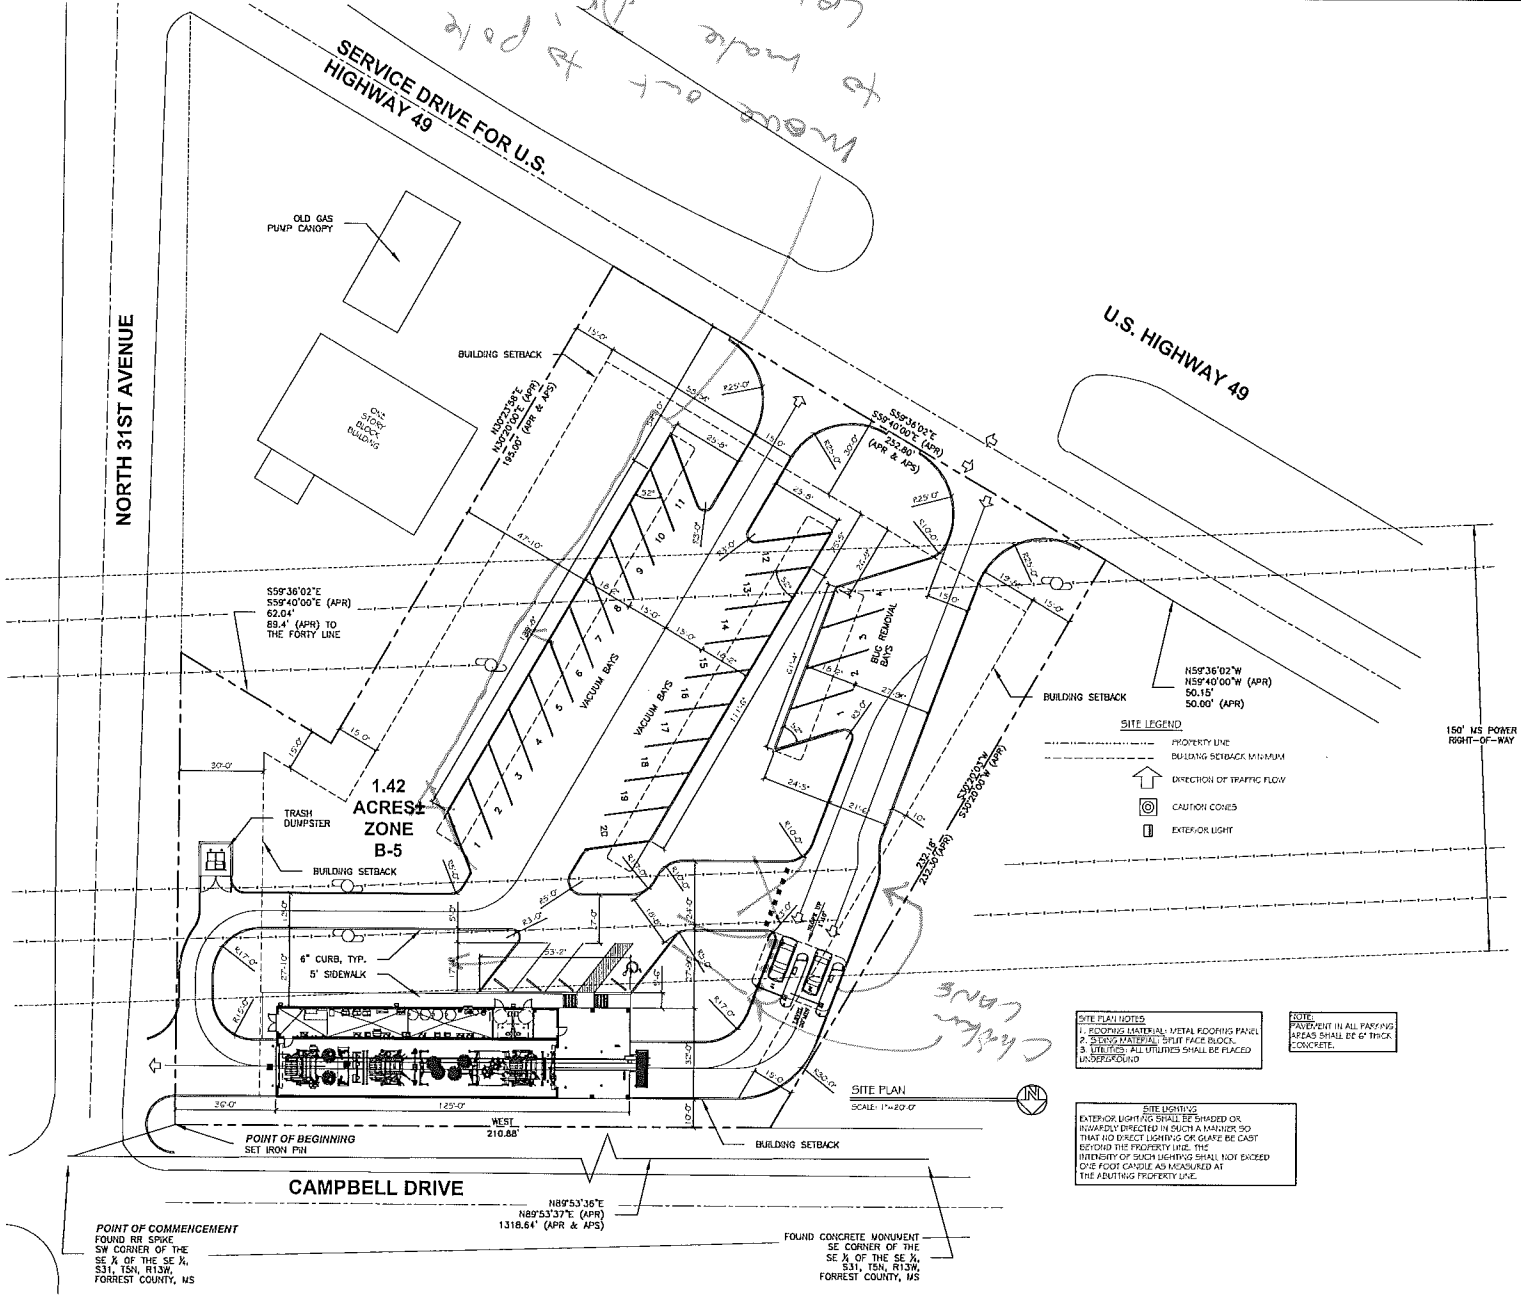

DAMMON ENGINEERING INC.
architects & Engineers

dammonengineering.com
dammon@bellsouth.net
PHONE: 601-545-5930
FAX: 601-544-5930
CHIEF ENGINEER: BRIAN WESTON, P.E.
CHIEF ARCHITECT: KEVIN KINCHEN
6147 U.S. HIGHWAY 49
SUMRALL, MS 39482

RAINFOREST CARWASH #2
6435 U.S. HWY. 49

HATTIESBURG, MISSISSIPPI

JOB No:	2212	DATE: 07-16-2014
DRAWN BY:	CKD	CHECKED BY: CKD

REVISIONS		
#	DESCRIPTION	DATE

SITE PLAN

SHEET No: 00 OF 00

C1