




A STAFF DINING HALL / LAUNDRY
BUILDING
FOR:

**CHRISTWOOD
RETIREMENT
COMMUNITY**

100 CHRISTWOOD BLVD,
COVINGTON, LA 70443

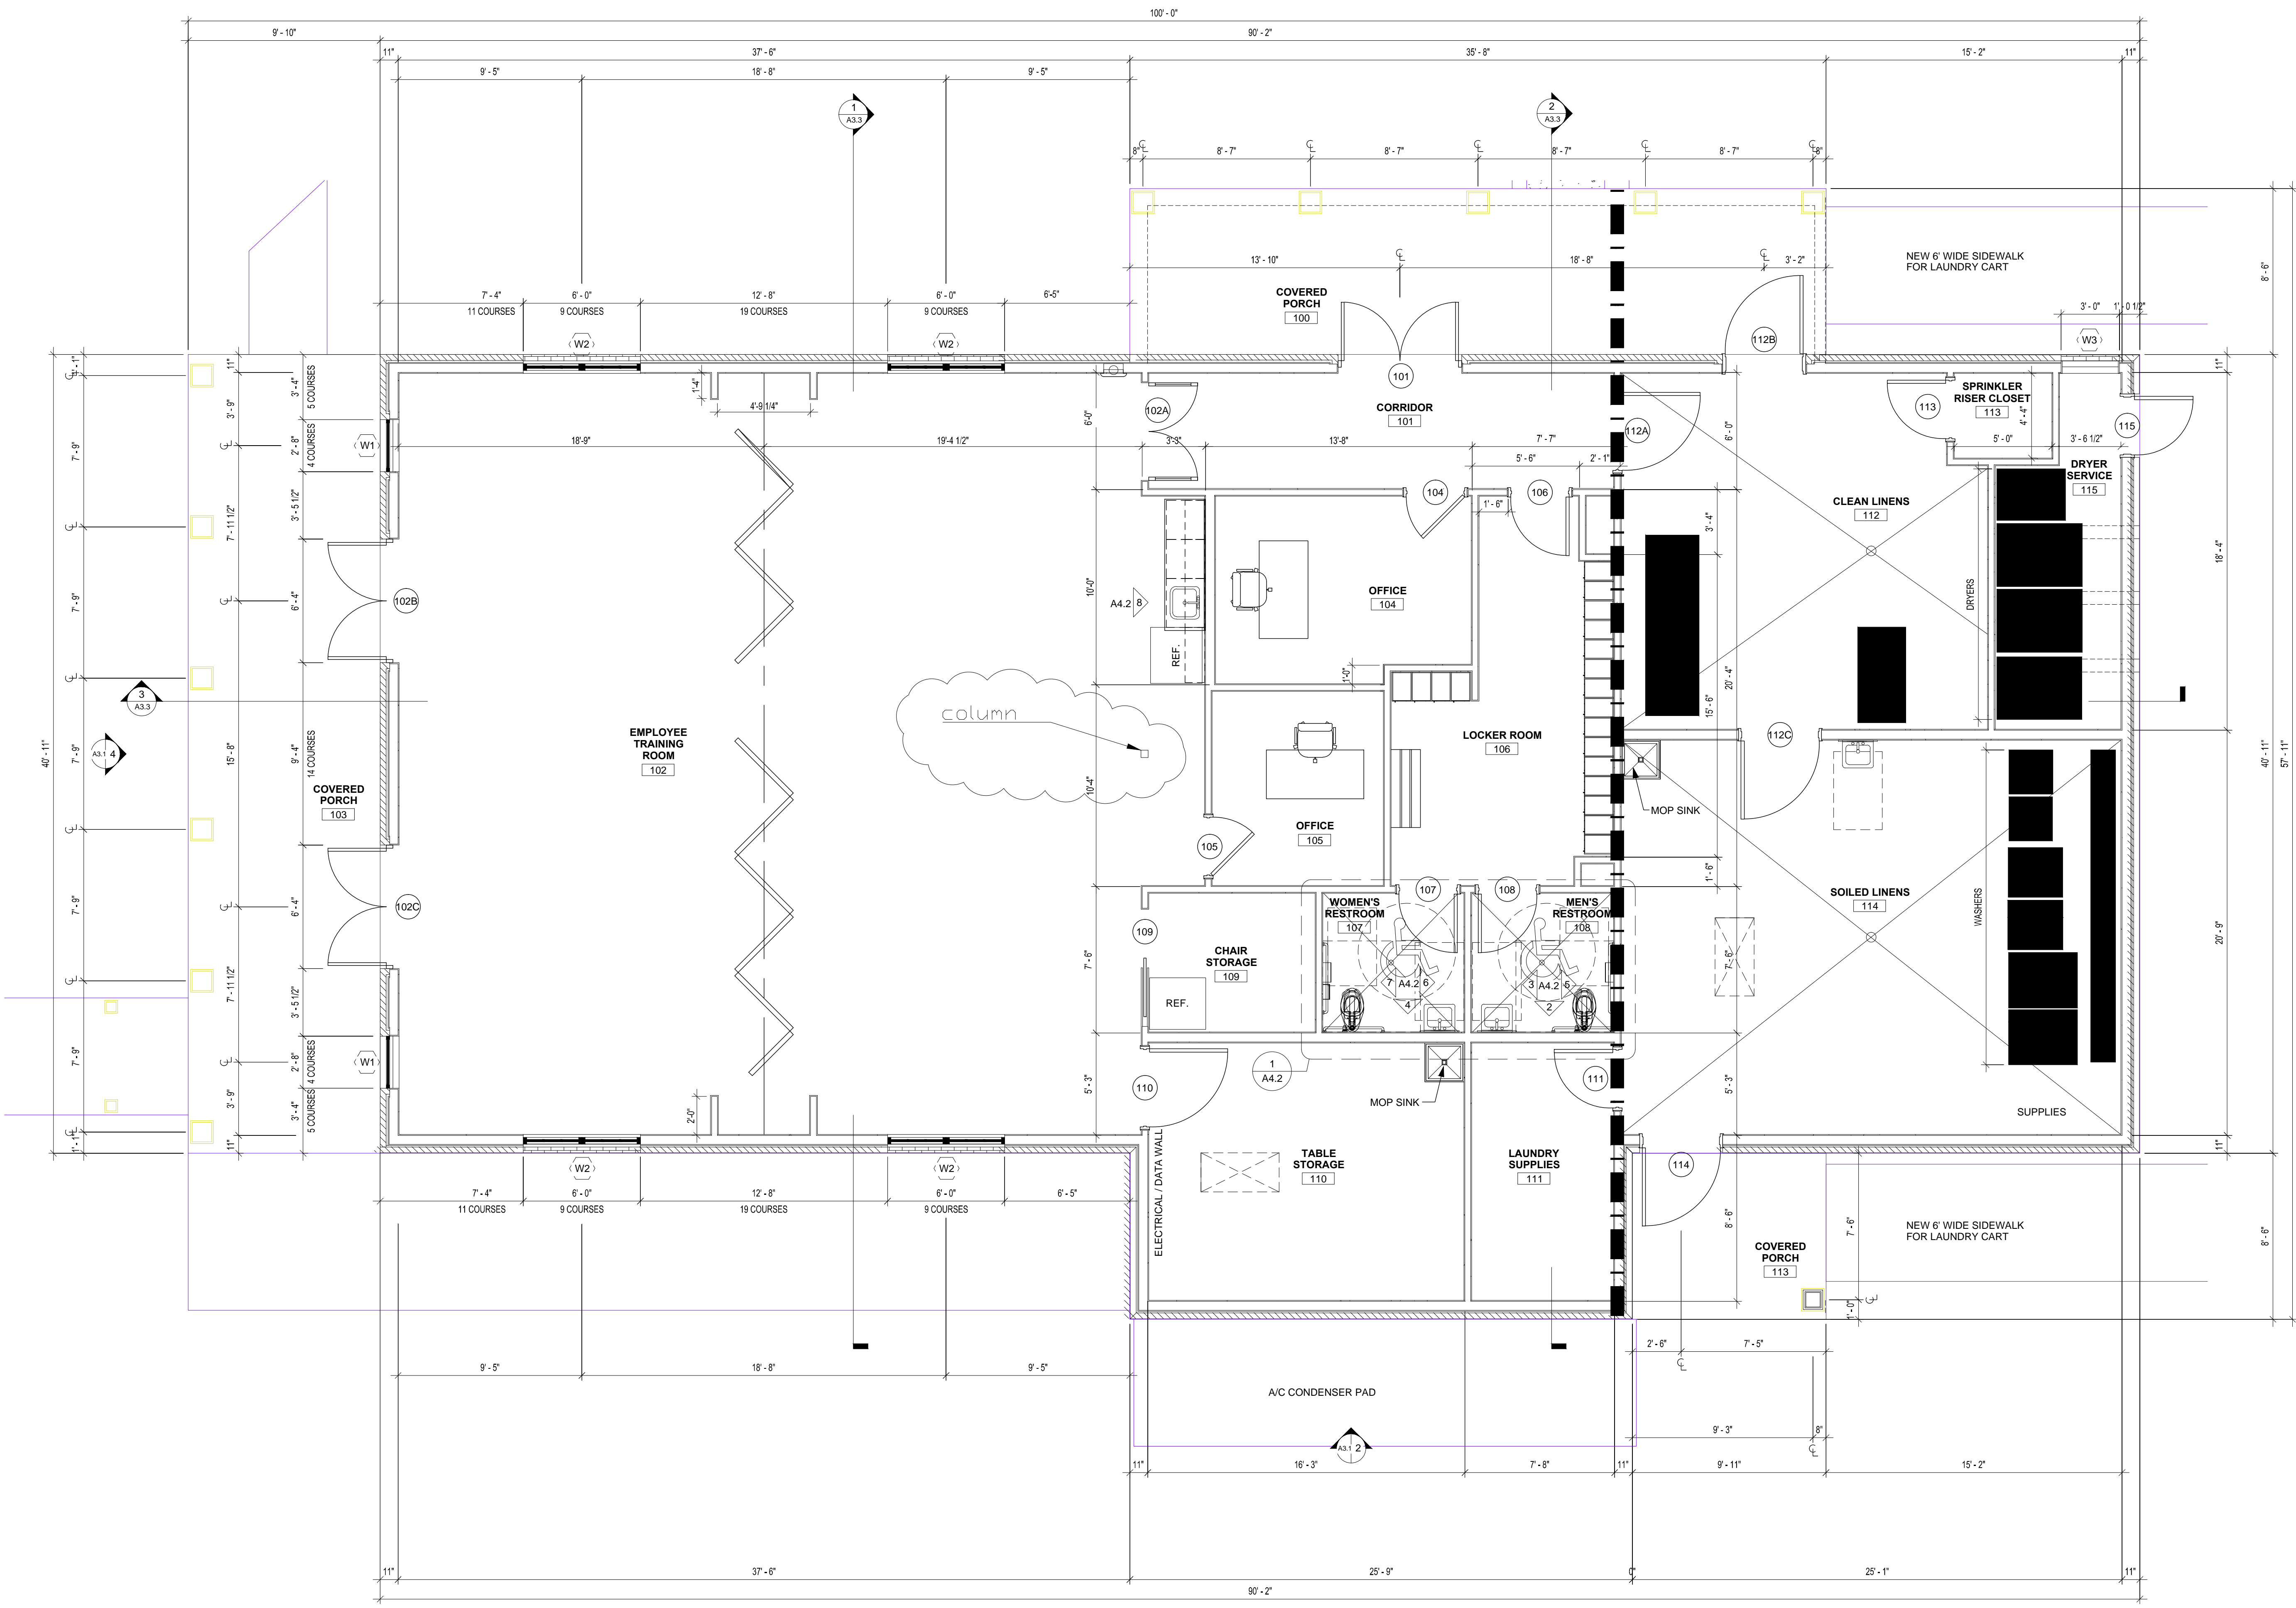

THESE DRAWINGS ARE THE SOLE PROPERTY OF FAUTLEROY LATHAM
WELDON BARRÉ ARCHITECTS, APC, AND ARE ISSUED AS INSTRUMENTS
OF SERVICE. THESE DRAWINGS SHALL NOT BE COPIED, REPRODUCED
OR USED IN ANY MANNER WITHOUT WRITTEN CONSENT OF
FAUTLEROY LATHAM WELDON BARRÉ ARCHITECTS, APC.

Issue	Date	Remark

FIRST FLOOR PLAN

PERMIT SET

Job No.	214005.01	Sheet No.	
Drawn by	JMG		
Checked by	KJW		
Date	12.8.2014		

A2.1

1 FLOOR PLAN
A2.1 1/4" = 1'-0"