



Control Panel

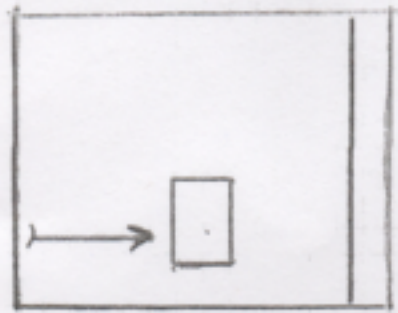


FRONT SIDE

35"

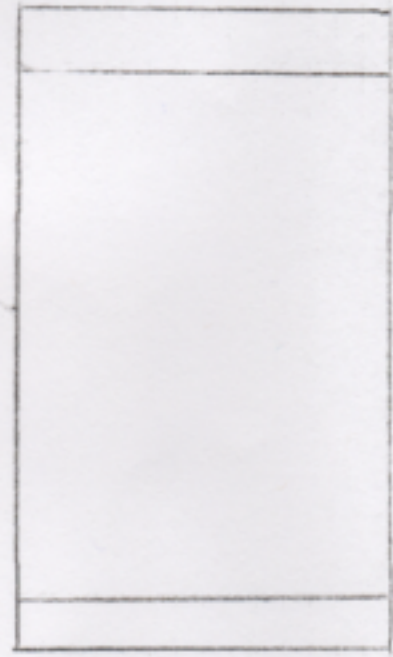

RIGHT / LEFT SIDE

76.8"

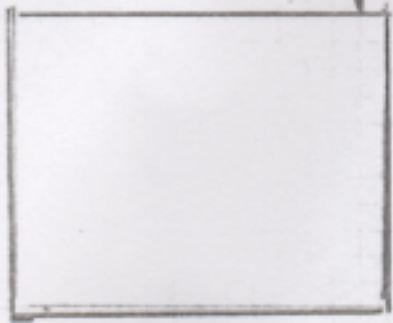


REAR SIDE

35"

EXHAUST

46"

3" x 3" x 1/4" ANGLE IRON

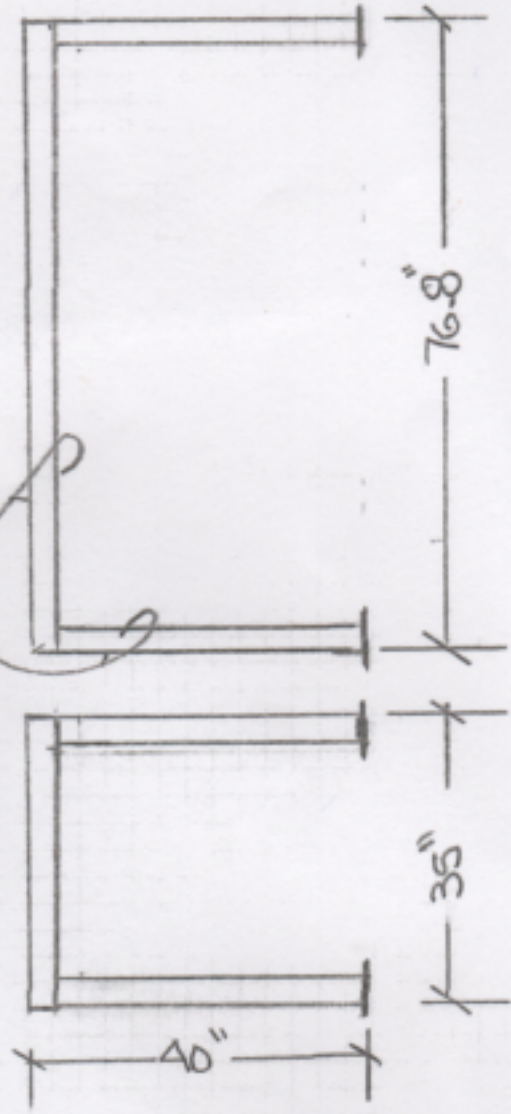

ELECTRICAL CONNECTION PORTS

GENERATOR PLAT FORM

MAPLEST
NOLA