

SURVEYED IN ACCORDANCE WITH THE LOUISIANA STANDARDS OF PRACTICE FOR PROPERTY BOUNDARY SURVEYS FOR A CLASS C SURVEY.


THE SERVITUDES AND RESTRICTIONS SHOWN ON THIS SURVEY ARE LIMITED TO THOSE SET FORTH IN THE DESCRIPTION FURNISHED ME AND THERE IS NO REPRESENTATION THAT ALL APPLICABLE SERVITUDES AND RESTRICTIONS ARE SHOWN HEREON. THE SURVEYOR HAS MADE NO TITLE SEARCH OR PUBLIC RECORD SEARCH IN COMPILING THE DATA FOR THIS SURVEY.

THIS SURVEY HAS BEEN PREPARED WITHOUT THE BENEFIT OF A TITLE SEARCH


REFERENCE BEARING RECORD BEARINGS.

REFERENCE MATERIAL:

DESCRIPTION FURNISHED BY CLIENT. SURVEY OF WEST PORTIONS OF LOTS 9 & 10, SQ. 2 LINDBERG GLEN ANNEX NO. 1 BY JV BURKES DATED 6-20-2000.

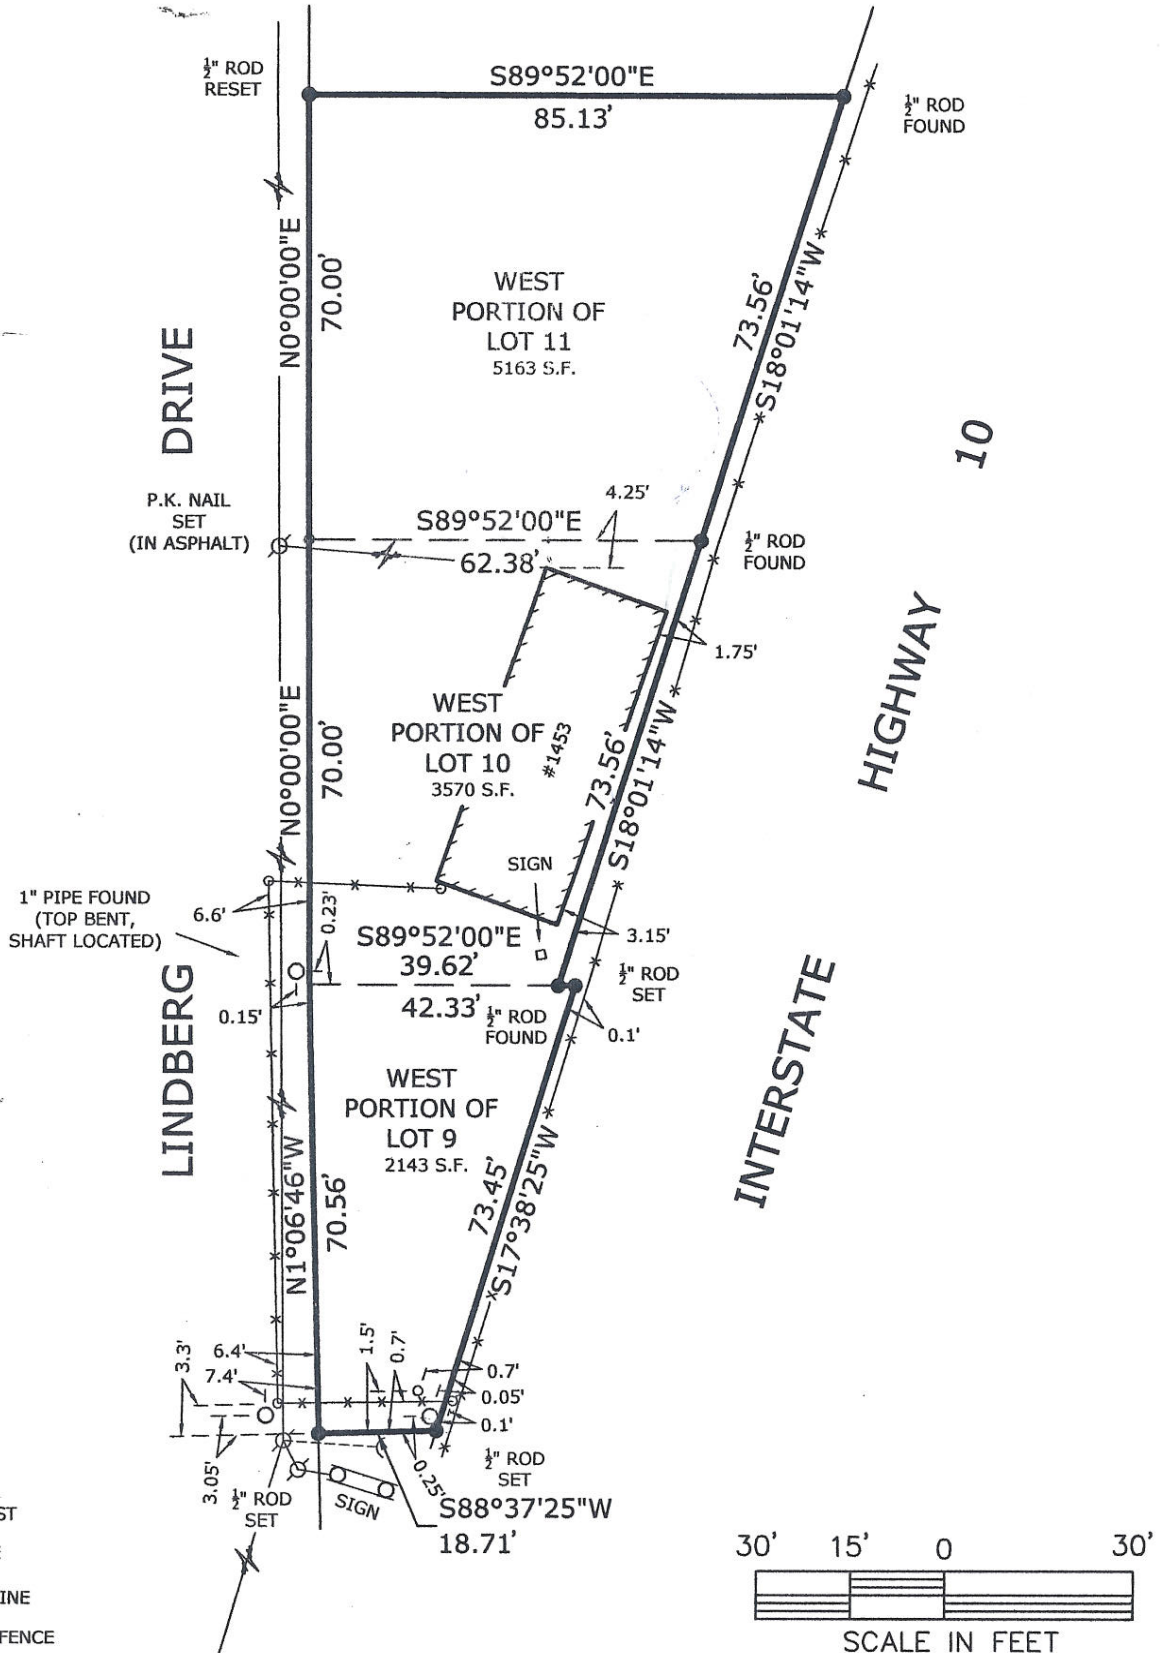

- = 4" STEEL POST
- ⊙ = POWER POLE
- +— = OVERHEAD LINE
- ⊗ = CHAIN LINK FENCE

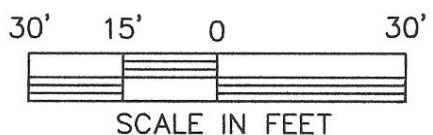

SURVEYOR'S CERTIFICATE
STATE OF LOUISIANA
PARISH OF ST. TAMMANY

**WEST PORTIONS OF LOTS 9, 10 & 11, SQUARE 2
LINDBERG GLEN ANNEX NO. 1
ST. TAMMANY PARISH, LA**

I, Lester H. Martin Jr. Professional Surveyor do hereby certify that I have surveyed, computed and plotted the property shown hereon located in Lindberg Glen Annex No. 1, St. Tammany Parish, LA. Surveyed at the request of Mike J. Boeur.

DATE: 8-14-11 SCALE: 1"=30' JOB #: 11L-0112 DWG. BY: LMJ

Witness my signature on this, the 14th day of August, 2011.

LESTER H. MARTIN, JR.
REG. No. 4758
REGISTERED PROFESSIONAL
LAND SURVEYOR

Lester H. Martin Jr.
License #4758

LESTER MARTIN JR.
& Associates LLC
822 Kostmayer Avenue
Slidell, Louisiana 70458
Mobile: (985) 285-9099 Fax: 1 (208) 279-0935
E-mail: LMSurveyor@aol.com