


**FOUNDATION PLAN**  
 SCALE: 1/16" = 1'-0"

NOTE: WAREHOUSE FLOOR SLAB SHALL BE FINISHED SPECIFICATION FINISH. FINISH THICKNESS AND LEADERS F.L. = 23'

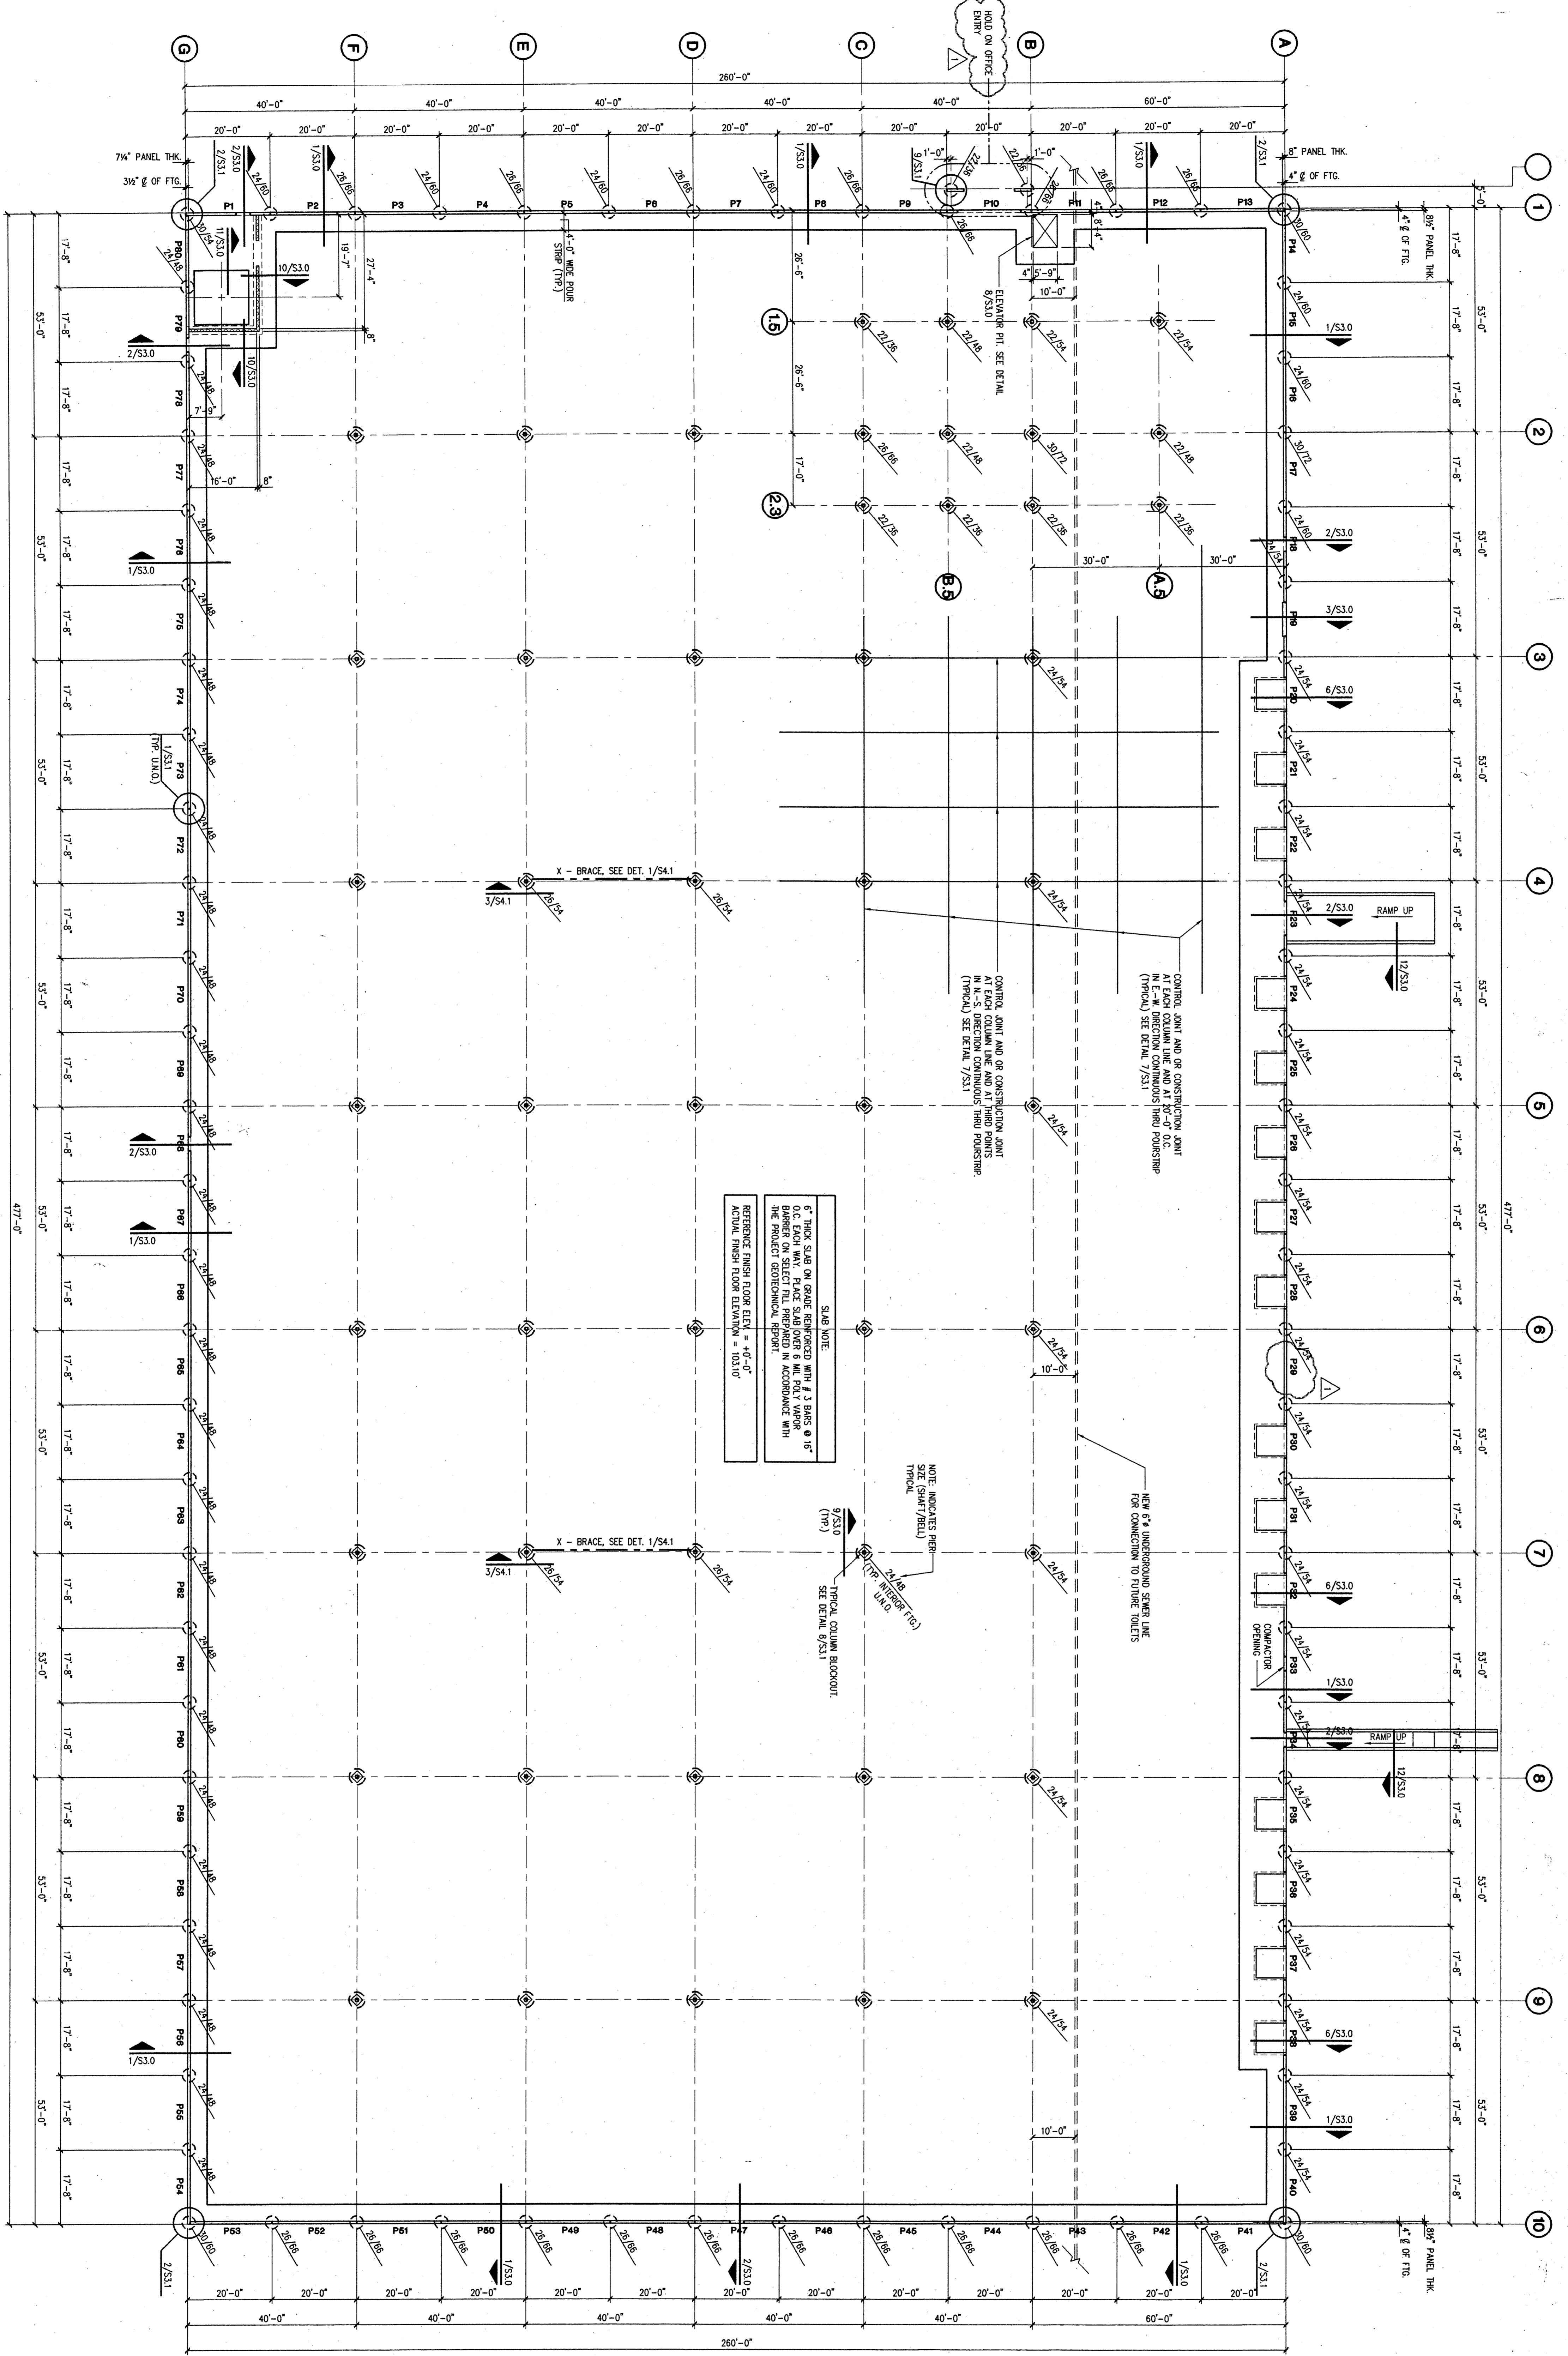

SAB NOTE:  



CONTROL JOINT AND OR CONSTRUCTION JOINT AT EACH COLUMN LINE AND AT HARD POINTS IN E-W DIRECTION. CONTINUOUS THRU POUNDRS (TYPICAL) SEE DETAIL 7/S3.1

CONTROL JOINT AND OR CONSTRUCTION JOINT AT EACH COLUMN LINE AND AT HARD POINTS IN N-S DIRECTION. CONTINUOUS THRU POUNDRS (TYPICAL) SEE DETAIL 7/S3.1



HAHNES  
 Structural Engineering  
 811 Rock Street  
 Suite 101  
 Houston, Texas 77002  
 713-227-4811  
 713-227-4812 fax

Owens & Minor Medical, Inc.

HRM# 95079  
 Issues / Revisions  
 FOUNDATION PERMIT 22 January 1996  
 ISSUE FOR PERMIT 20 February 1996  
 REVISIONS 14 March 1996

House Reh Burwell Architects