


**ROOF FRAMING PLAN**

SCALE: 1/16" = 1'-0"

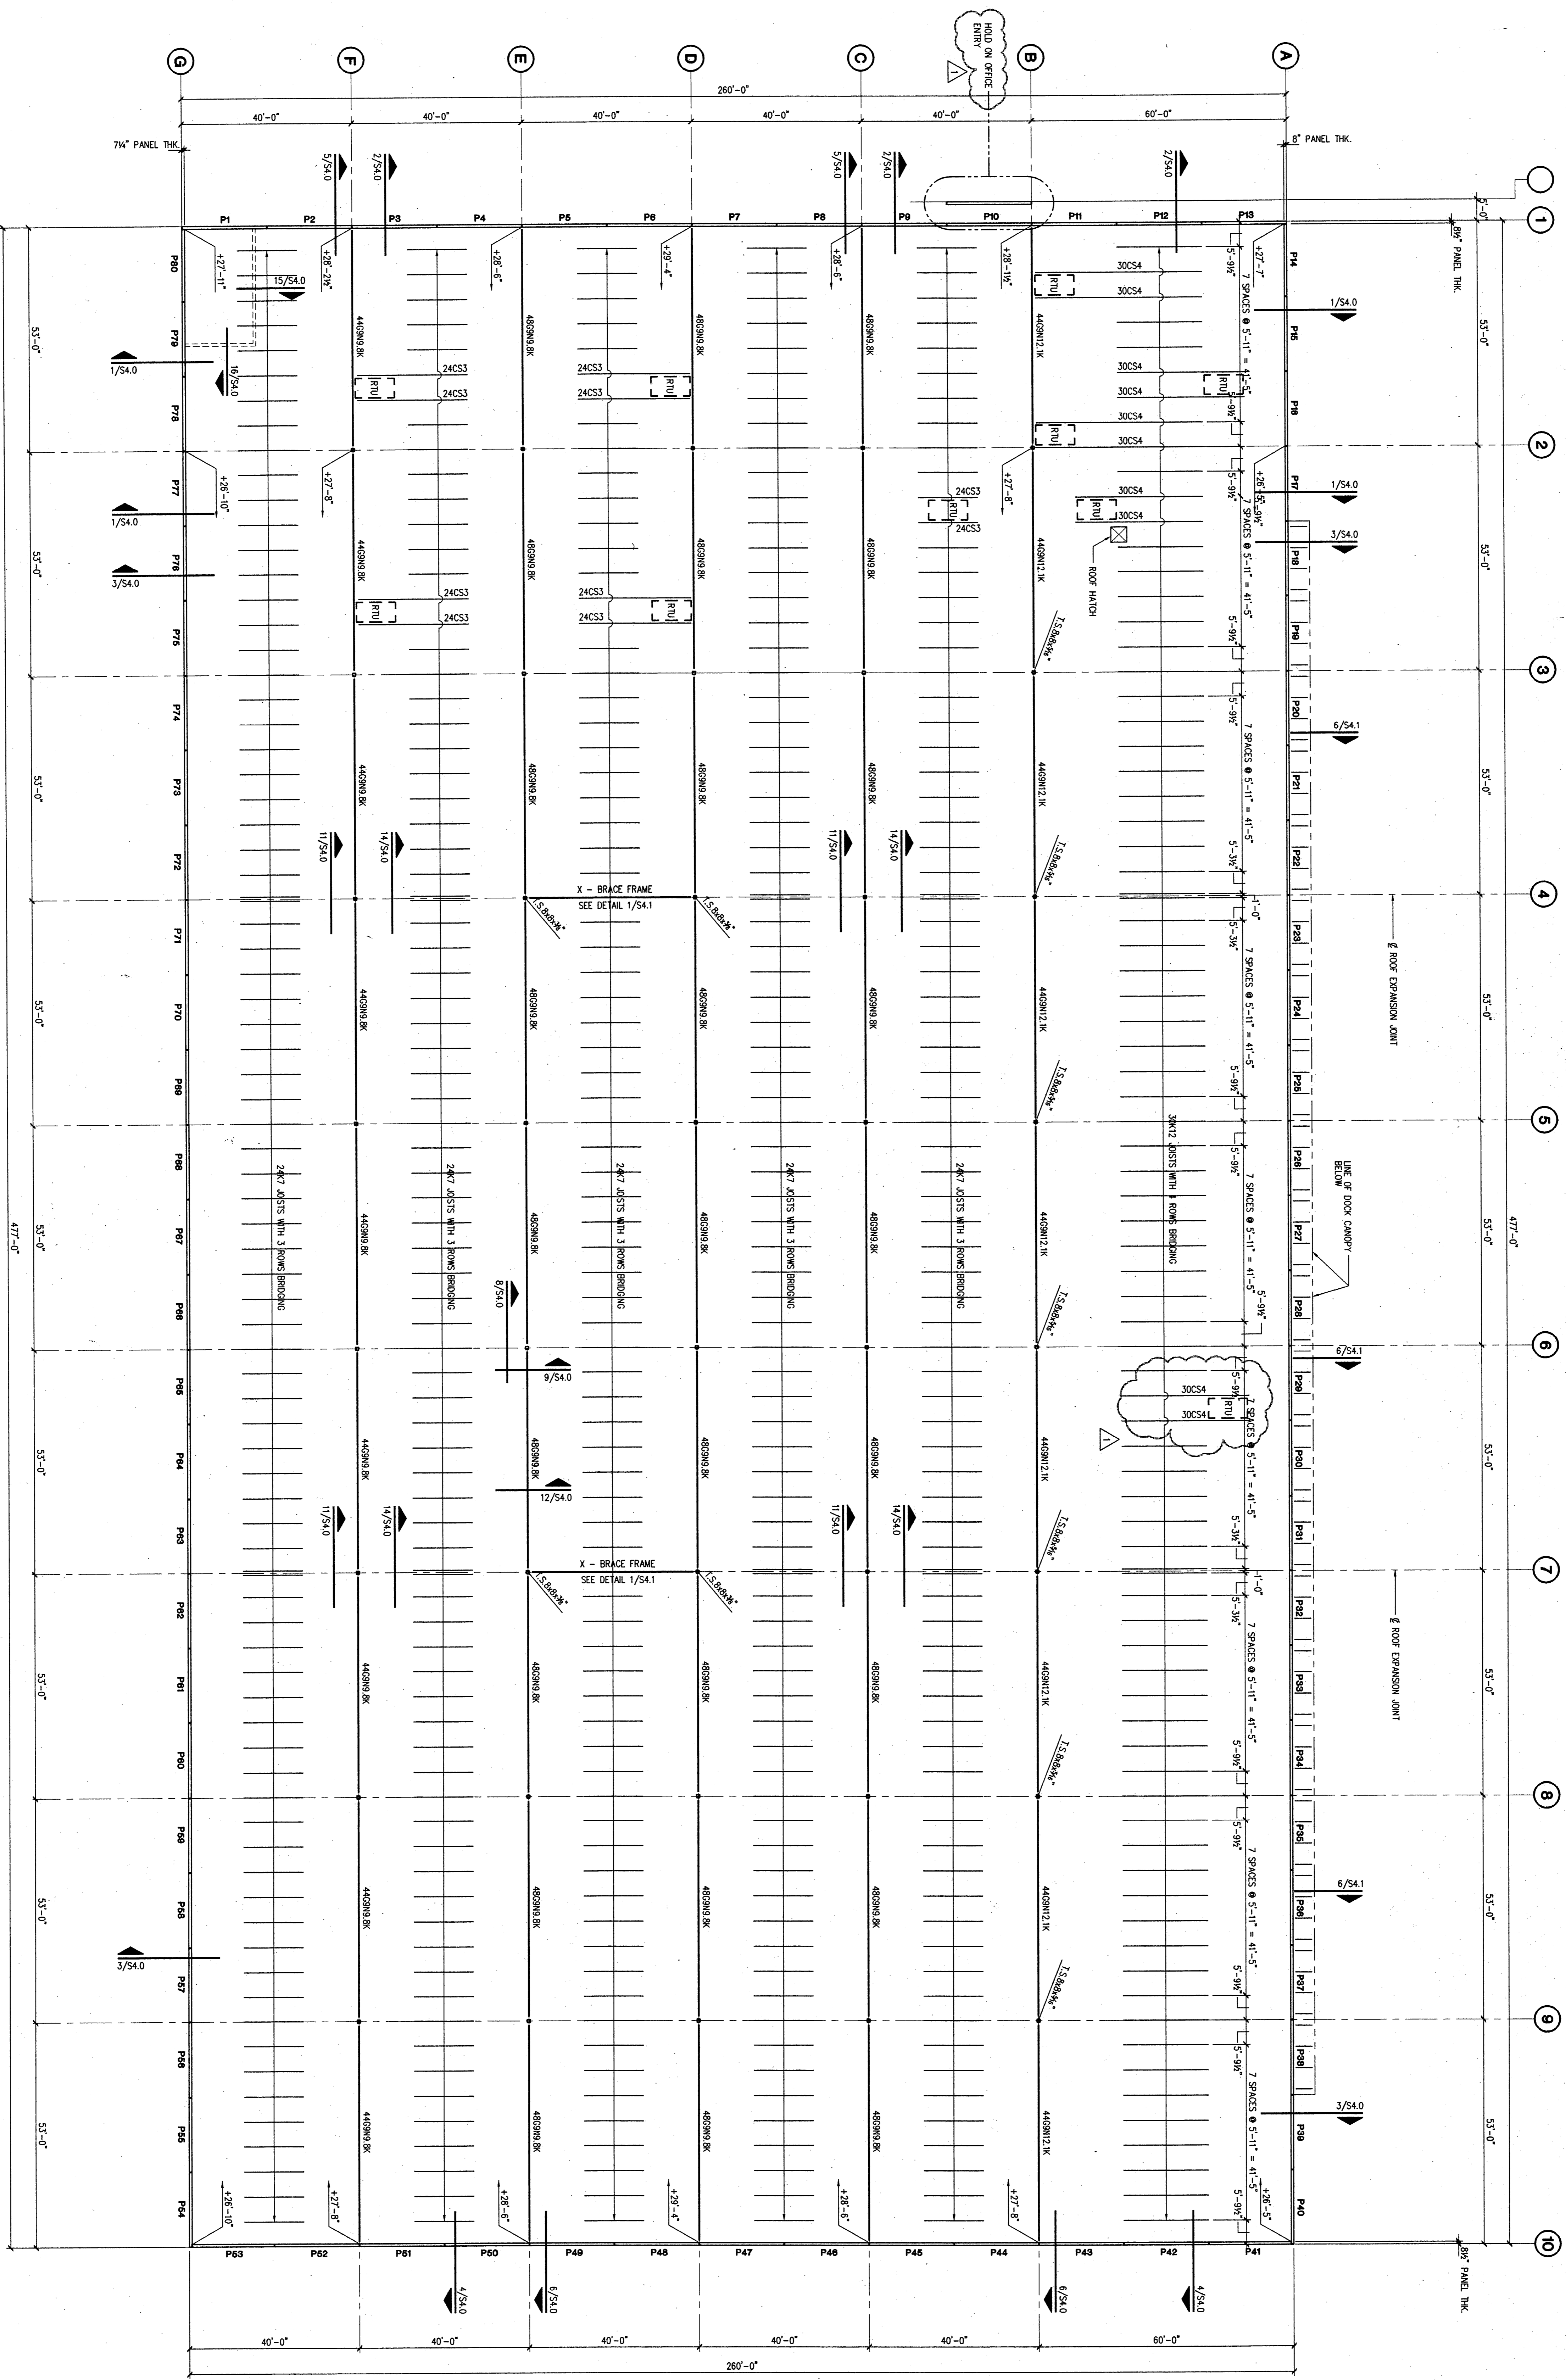

PROVIDE ADDITIONAL JOIST BRACING AS NECESSARY TO RESIST A NET UPLIFT FORCE OF 100 P.S.F.

- NOTES TO BEAMING:**
- ELEVATIONS SHOWN THIS (+) 28'-6" (EXAMPLE) - ARE JOIST BEARING WITH RESPECT TO REF. FIN. E.L. OF 0'-0".
  - REF. FIN. E.L. OF 0'-0".
  - UNLESS NOTED OTHERWISE ALL COLUMNS ARE 12" DIA.
  - ROOFING DETAIL ABOVE BEAMS FOR JOIST SPACING AS REQUIRED BY THE MANUFACTURER. SEE DETAILS FOR ATTACHMENT TO WALL PANELS AND JOISTS.
  - ALL OPENINGS IN THE ROOF DECK LARGER THAN 12" OR SO MUST BE SUPPORTED ON AN ANGLE FRAME 3/4" DIA. FIELD WELDED TO THE ADJACENT JOIST. SEE DETAIL 10/54.0.
  - JOIST SEALS SHALL BE "CAULKED" OR "FOAMED" WHEN NECESSARY TO PROVIDE A LEAK PROOF BEARING SURFACE.
  - ALL ROOF FRAMING MEMBERS SHALL BE PROPERLY BRACED BY THE CONTRACTOR/ERECTOR UNDER THE SUPERVISION OF THE DESIGNER TO RESIST WIND UPLIFT. CONSULT THE MANUFACTURER FOR WALL PANELS AND JOISTS.
  - REF. TO SHEET S-1.0 FOR GENERAL NOTES & DIMENSIONED PLATES.



Owen C. House, Jr., PE  
 Edward W. Rein, Jr., PE  
 William M. Burwell, PE

811 Rock Street  
 Suite 101  
 Houston, Texas 77002  
 713-277-0811  
 713-277-0812 fax

HAVNESS WHALEY ASSOCIATES, INC.  
 Structural Engineering  
 Reston, Virginia  
 HVA# 98-313-00

House Rein Burwell Architects

Owens & Minor Medical, Inc.

RHB# 95079  
 Issues / Revisions  
 ISSUE FOR PERMIT 20 February 1996  
 REVISIONS 14 March 1996