
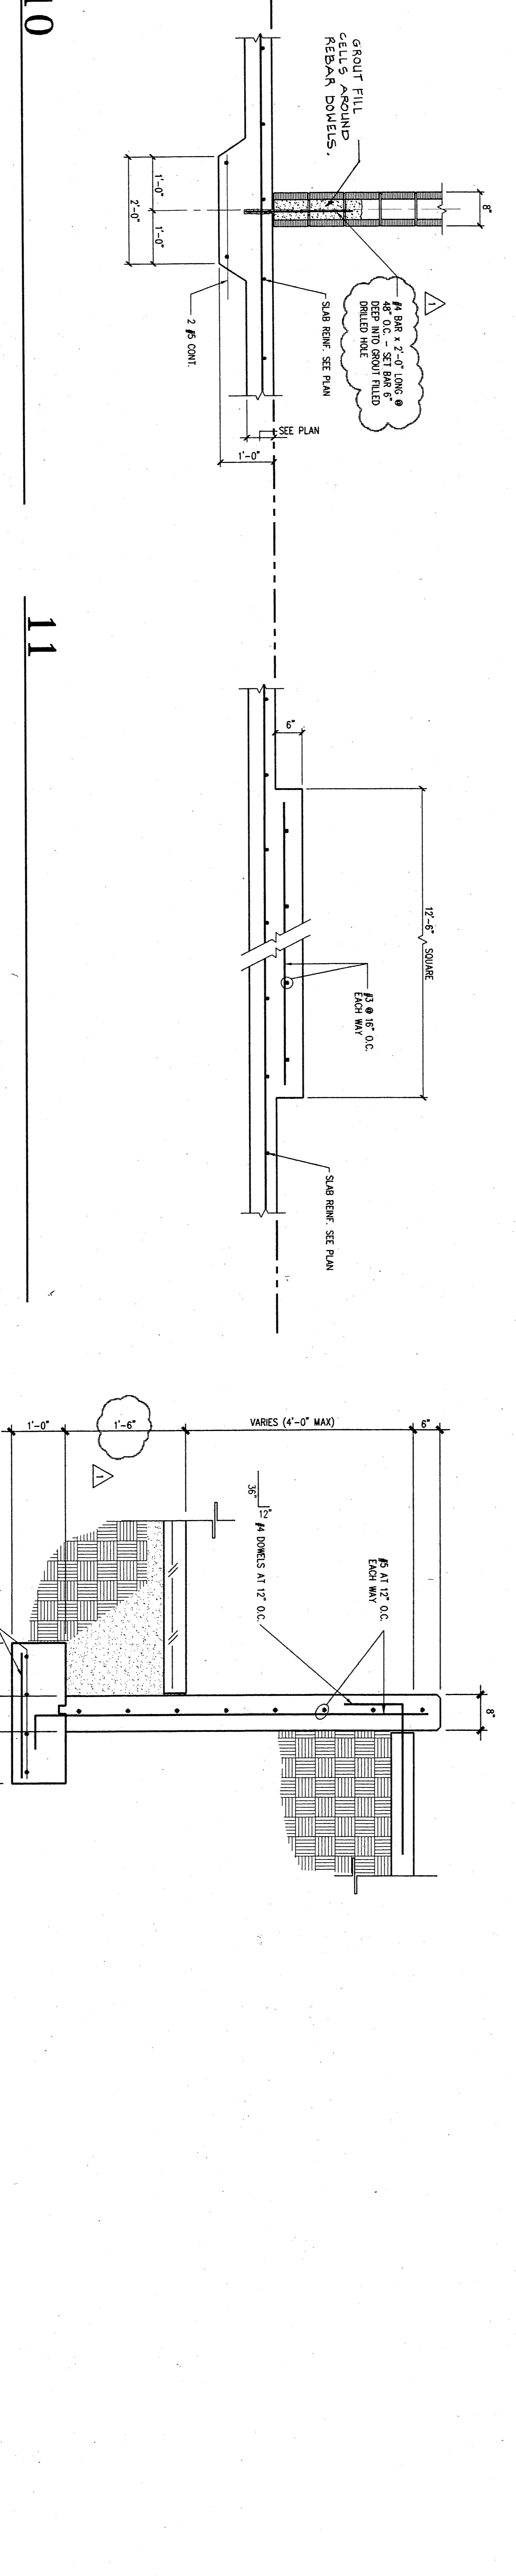


FOOTING SCHEDULE


SHAFT DIA.	VERTICAL REINFC.	YES	NO	NOTES

NOTE: NOTIFY STRUCTURAL ENGINEER FOR REVISIONS TO DRILLING & FOOTING FOOTINGS

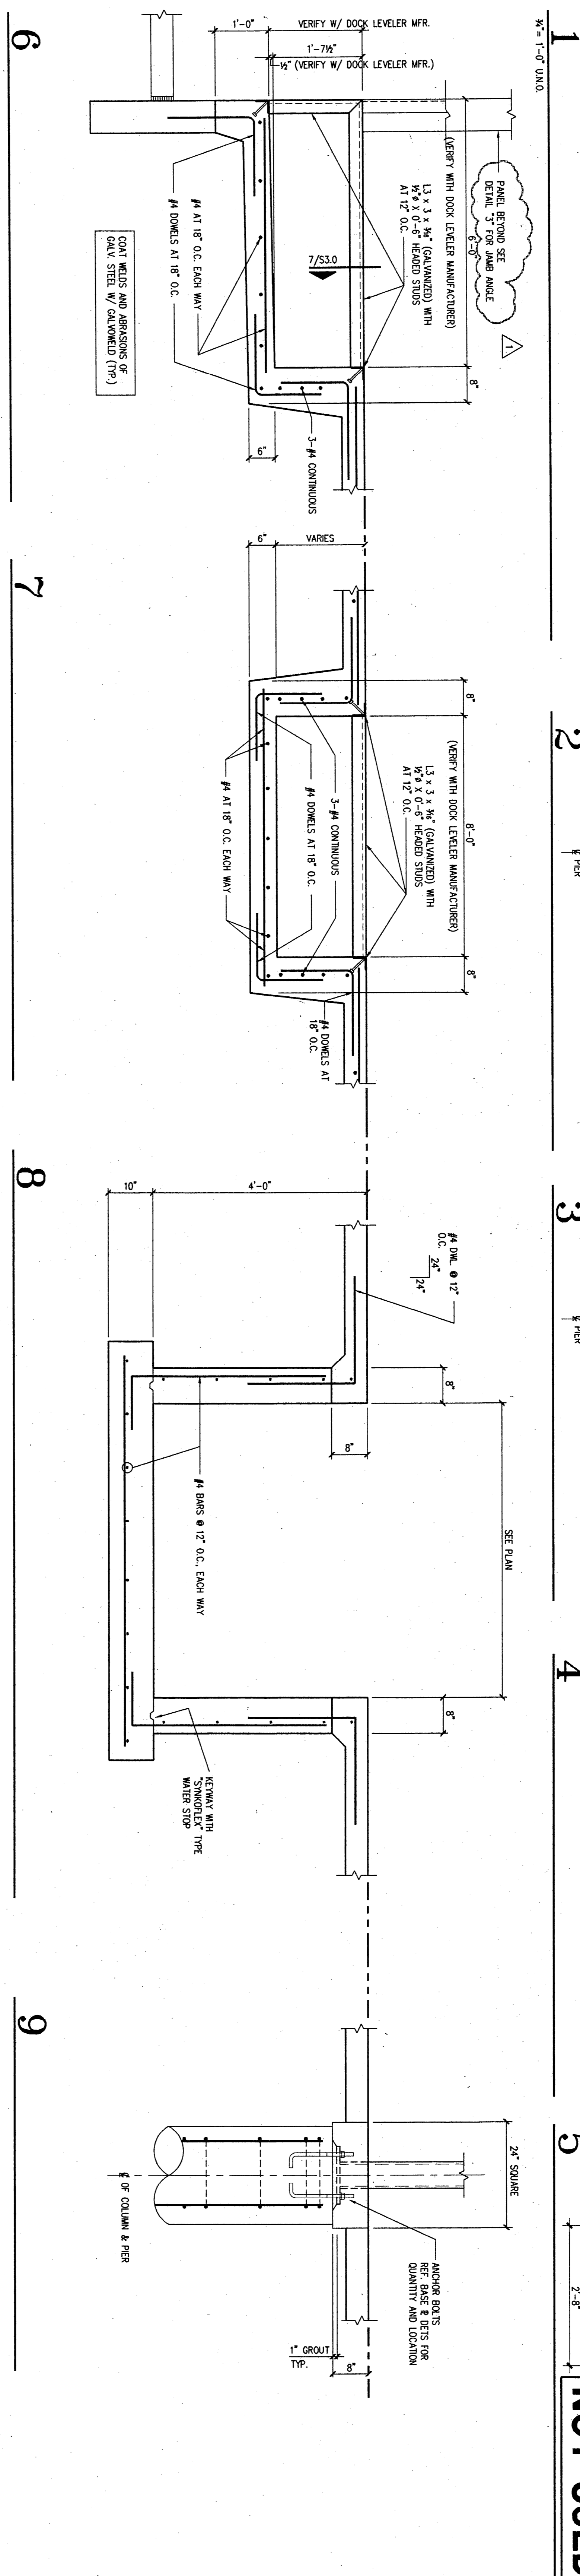

Oliver C. House, Jr., M.A.
 Edward W. Reh, Jr., M.A.
 William M. Burrell, M.A.
 811 Rock Street
 Suite 101
 Houston, Texas 77002
 713-277-0811
 713-277-0812 fax

HAYNES WHALEY ASSOCIATES, INC.
 Structural Engineering
 1000 West Loop West
 Suite 1000
 Houston, Texas 77027
 HVA# 95-315-00

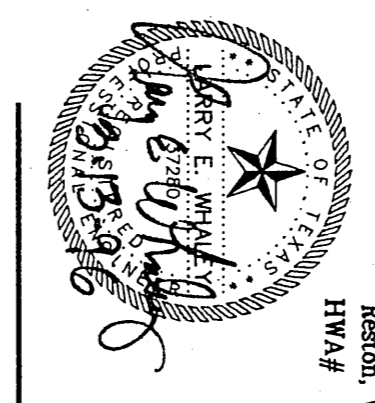

Owens & Minor Medical, Inc.

HBA# 95079
 Issues / Revisions
 FOUNDATION PERMIT
 ISSUE FOR PERMIT
 22 January 1996
 20 February 1996
 14 March 1996