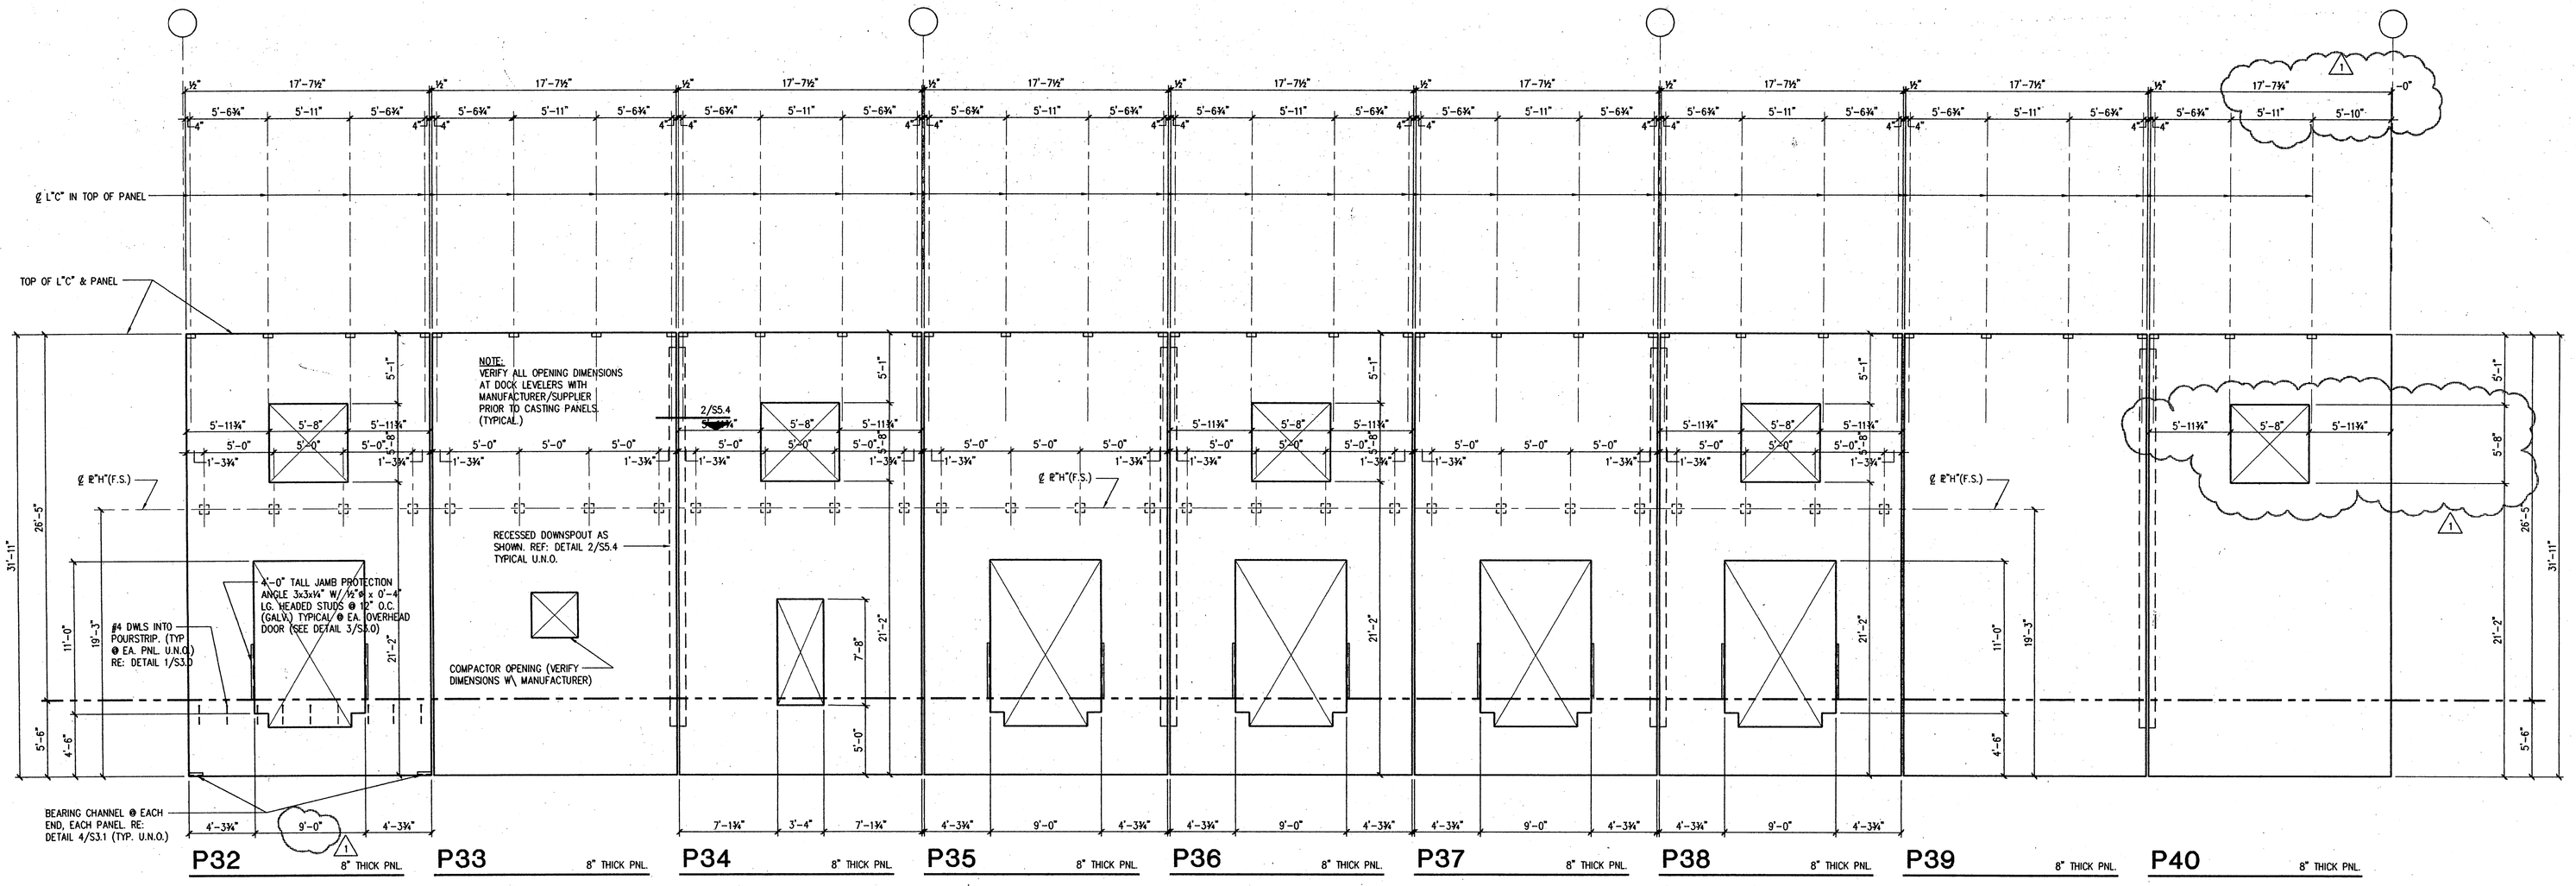

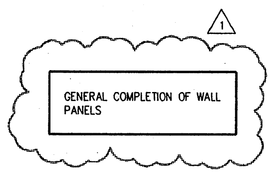

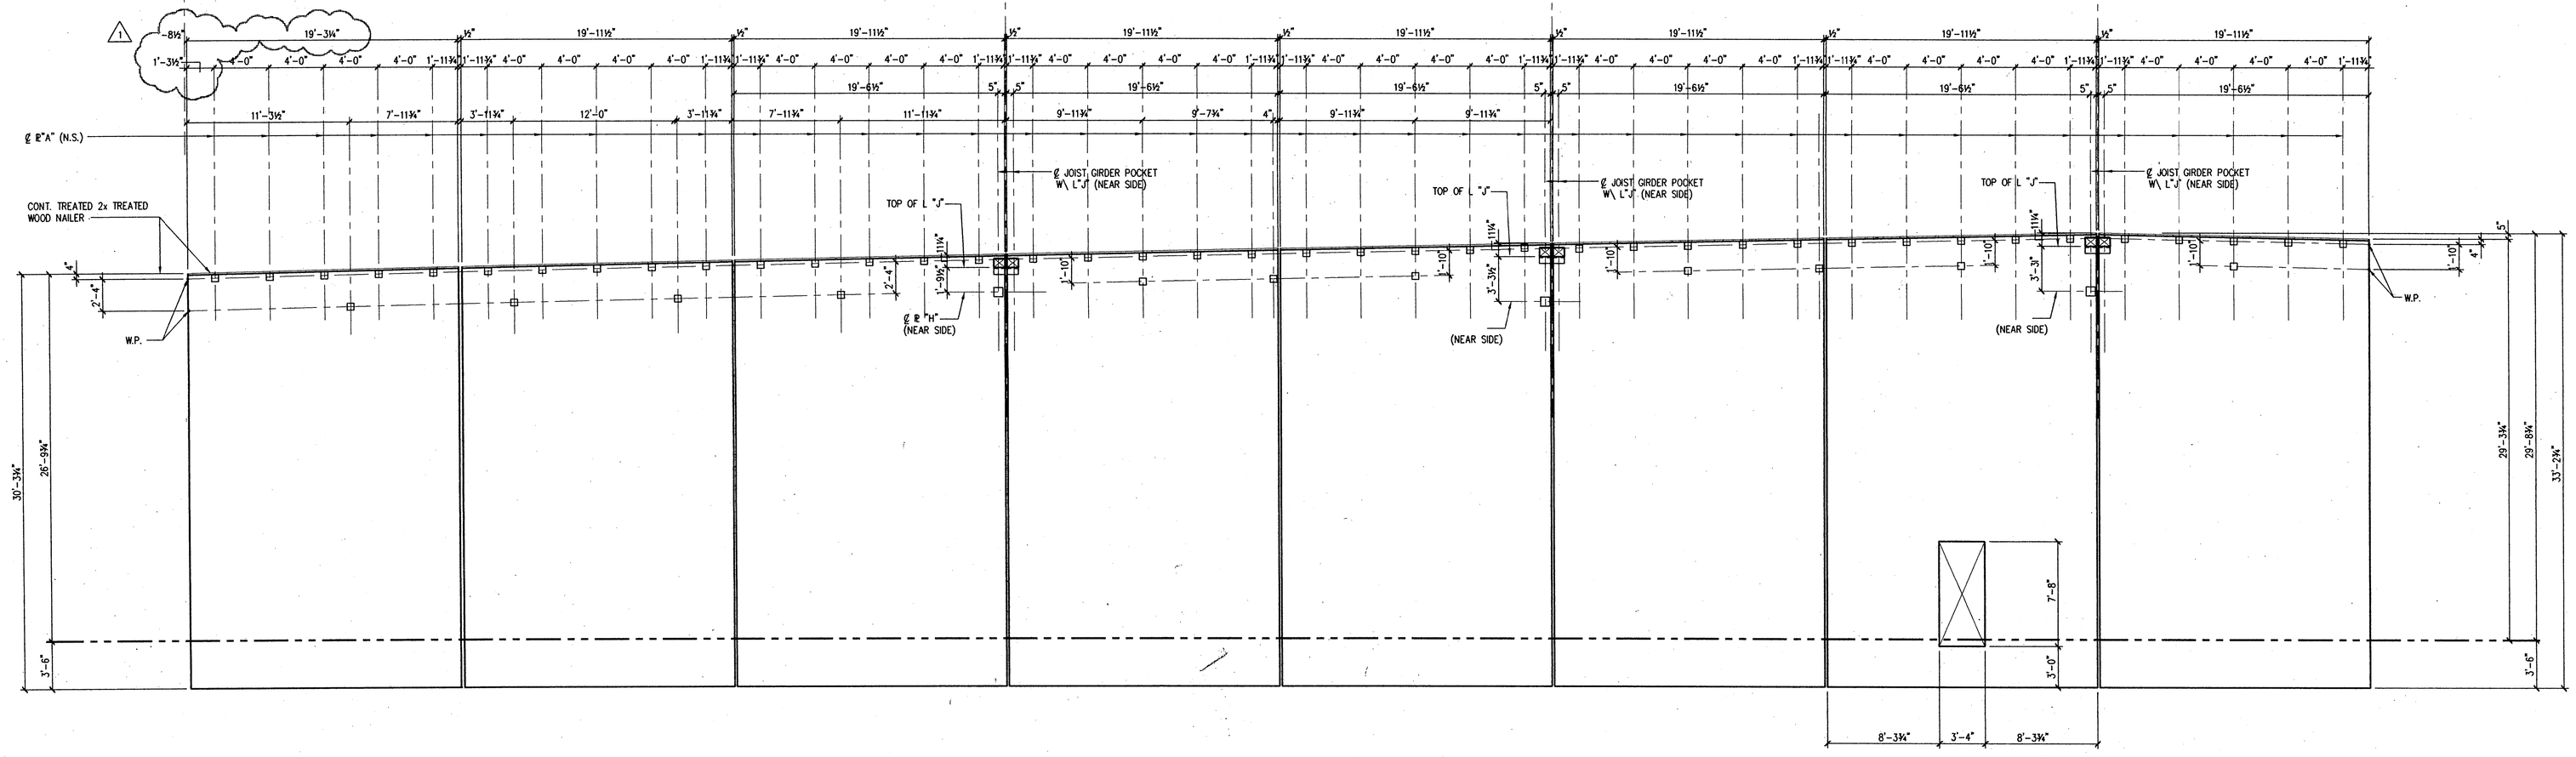

House Reh Burwell Architects

Glenn C. House, Jr. AIA
Edward M. Reh, Jr. AIA
William M. Burwell AIA

811 Rusk Street
Suite 101
Houston, Texas 77002
713-227-0811
713-227-0812 fax

HAYNES WHALEY ASSOCIATES, INC.
Structural Engineering
Houston, Texas
Reston, Virginia
HWA# 95-315-00

STATE OF TEXAS
HARRY E. WHALEY
Jan 6 1996

Owens & Minor Medical, Inc.

HRBA# 95079

Issues / Revisions

ISSUE FOR PERMIT	20 Febuary 1996
1 REVISIONS	14 March 1996

PLOT SCALE: 1:64
PLOT DATE: 13 MAR 96
CAD FILE: 95315S5.0.DWG

S5.2