



GENERAL NOTES:


1. WELDING ELECTROD SHALL BE E70 OR APPROVED EQUAL
2. BOLTS SHALL CONFORM TO ASTM 325, HIGH STRENGTH. THREADS SHALL NOT BE IN THE SHEAR PLANE.

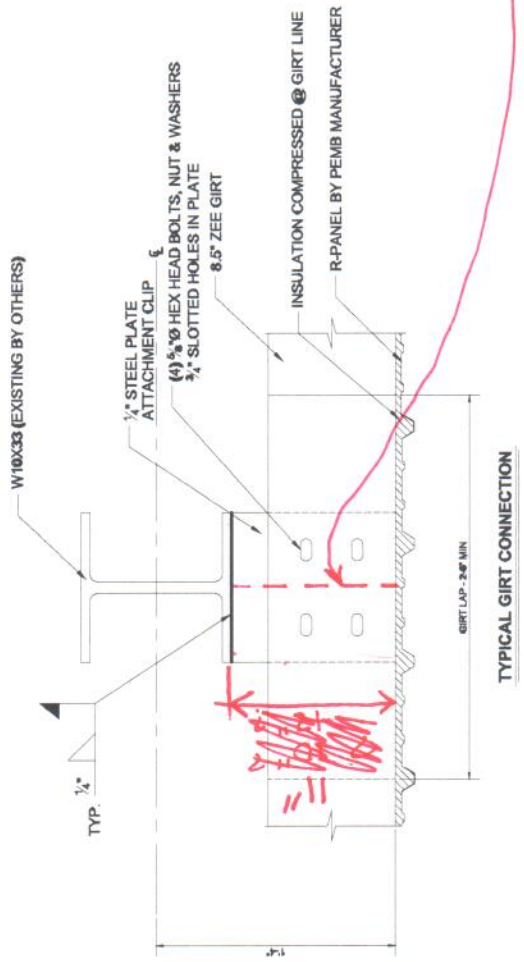

TYPICAL GIRT CONNECTION

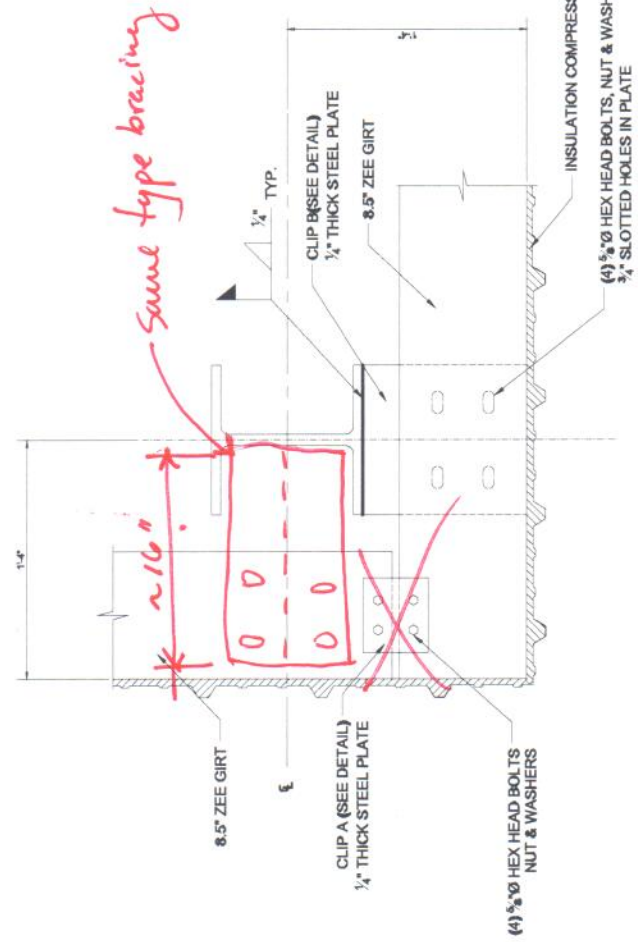


TYPICAL CORNER GIRT CONNECTION

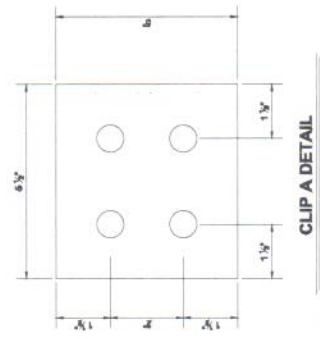

CLIP A DETAIL

cut a wedge of 1/4" pl. and weld to bottom of horz plate and flange of column

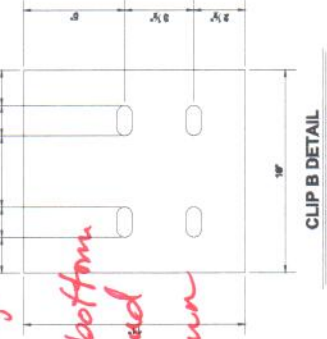

CLIP B DETAIL



1090 Old Spanish Trail
Suite. 8 Slidell, La 70458

PNK PINNACLE CASINO	
MANHATTAN CONSTRUCTION CO	
BAYON ROUGE	LOUISIANA
CENTRAL PLANT - GIRT ATTACHMENT	
DESIGN: JFJ	DRAWN: HNC
CHECK:	DATE: 6-28-2011
BRT. NO.	SEQ. NO.
S-01	1 OF 1