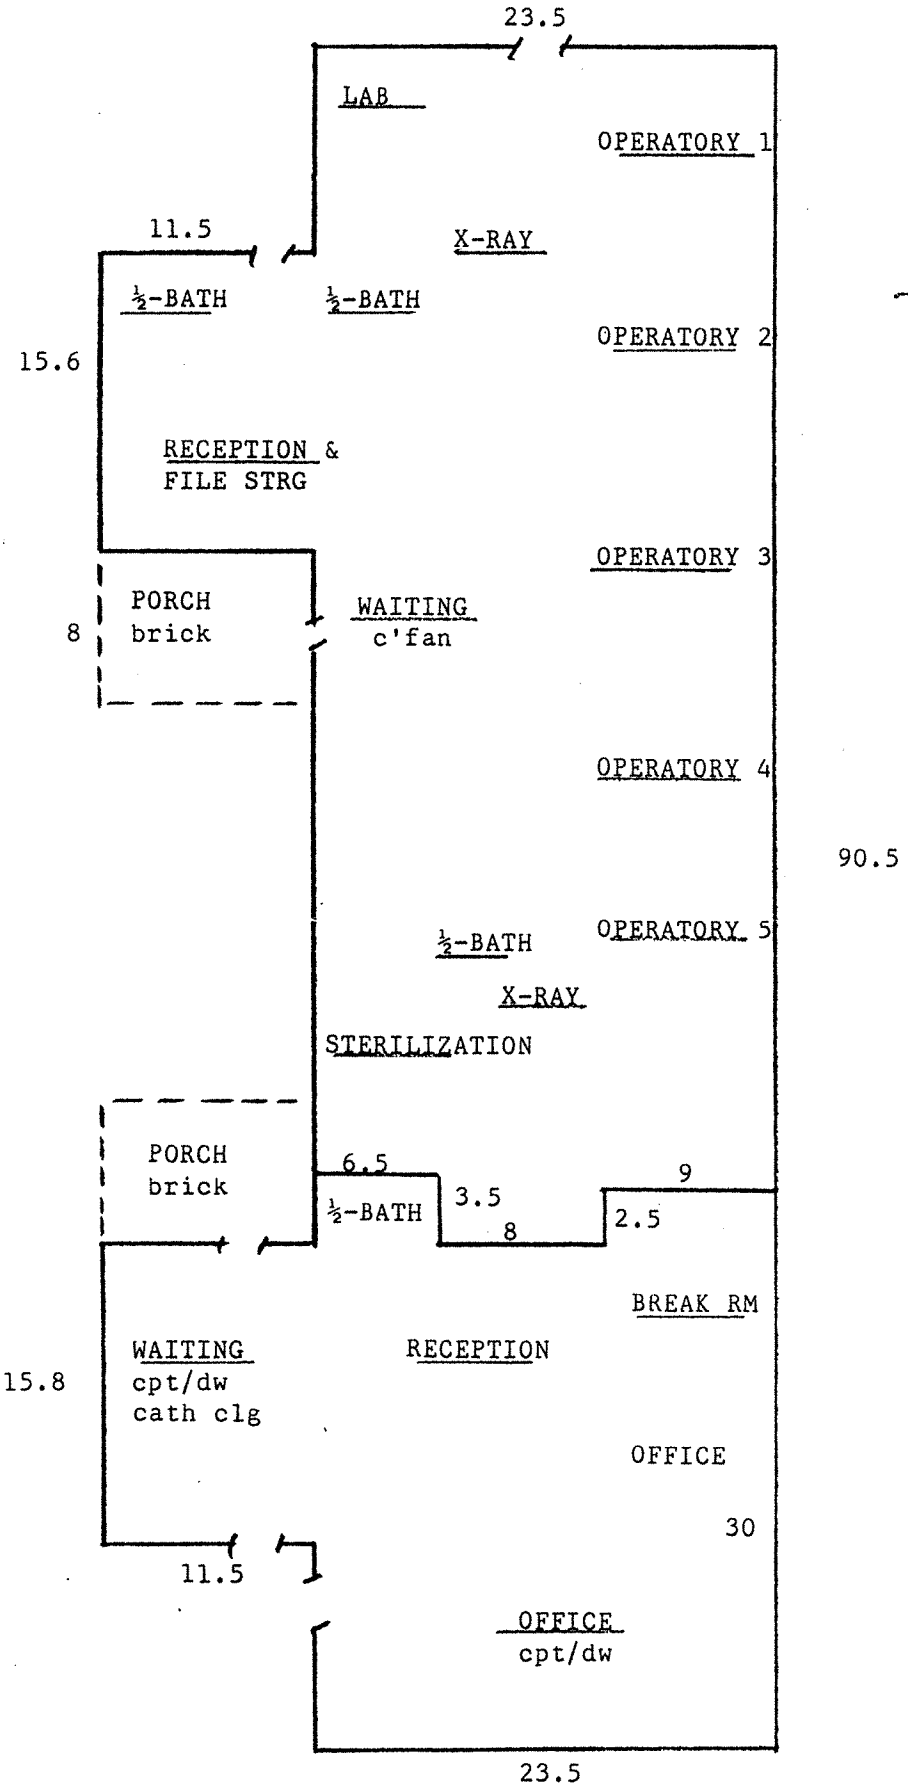
23.5
LAB
OPERATORY 1
11.5
X-RAY
½-BATH
½-BATH
OPERATORY 2
15.6
RECEPTION &
FILE STRG
OPERATORY 3
PORCH
brick
8
WAITING
c'fan
OPERATORY 4
90.5
½-BATH
OPERATORY 5
X-RAY
STERILIZATION
PORCH
brick
6.5
9
3.5
½-BATH
8
2.5
BREAK RM
WAITING
cpt/dw
cath clg
15.8
RECEPTION
OFFICE
30
11.5
OFFICE
cpt/dw
23.5