

Survey Map

of
 Lot 59 SQ. 7 in PINECREST SUBDIVISION

in
 CITY OF SLIDELL
 St. Tammany Parish, Louisiana




for
AUGUST JOHN MAGGIORE, JR.

This Survey is Certified True and Correct by

Ivan M. Borgen
 No. 686

Survey Number: 48208
 Date: DEC. 14, 1987
 Revision:

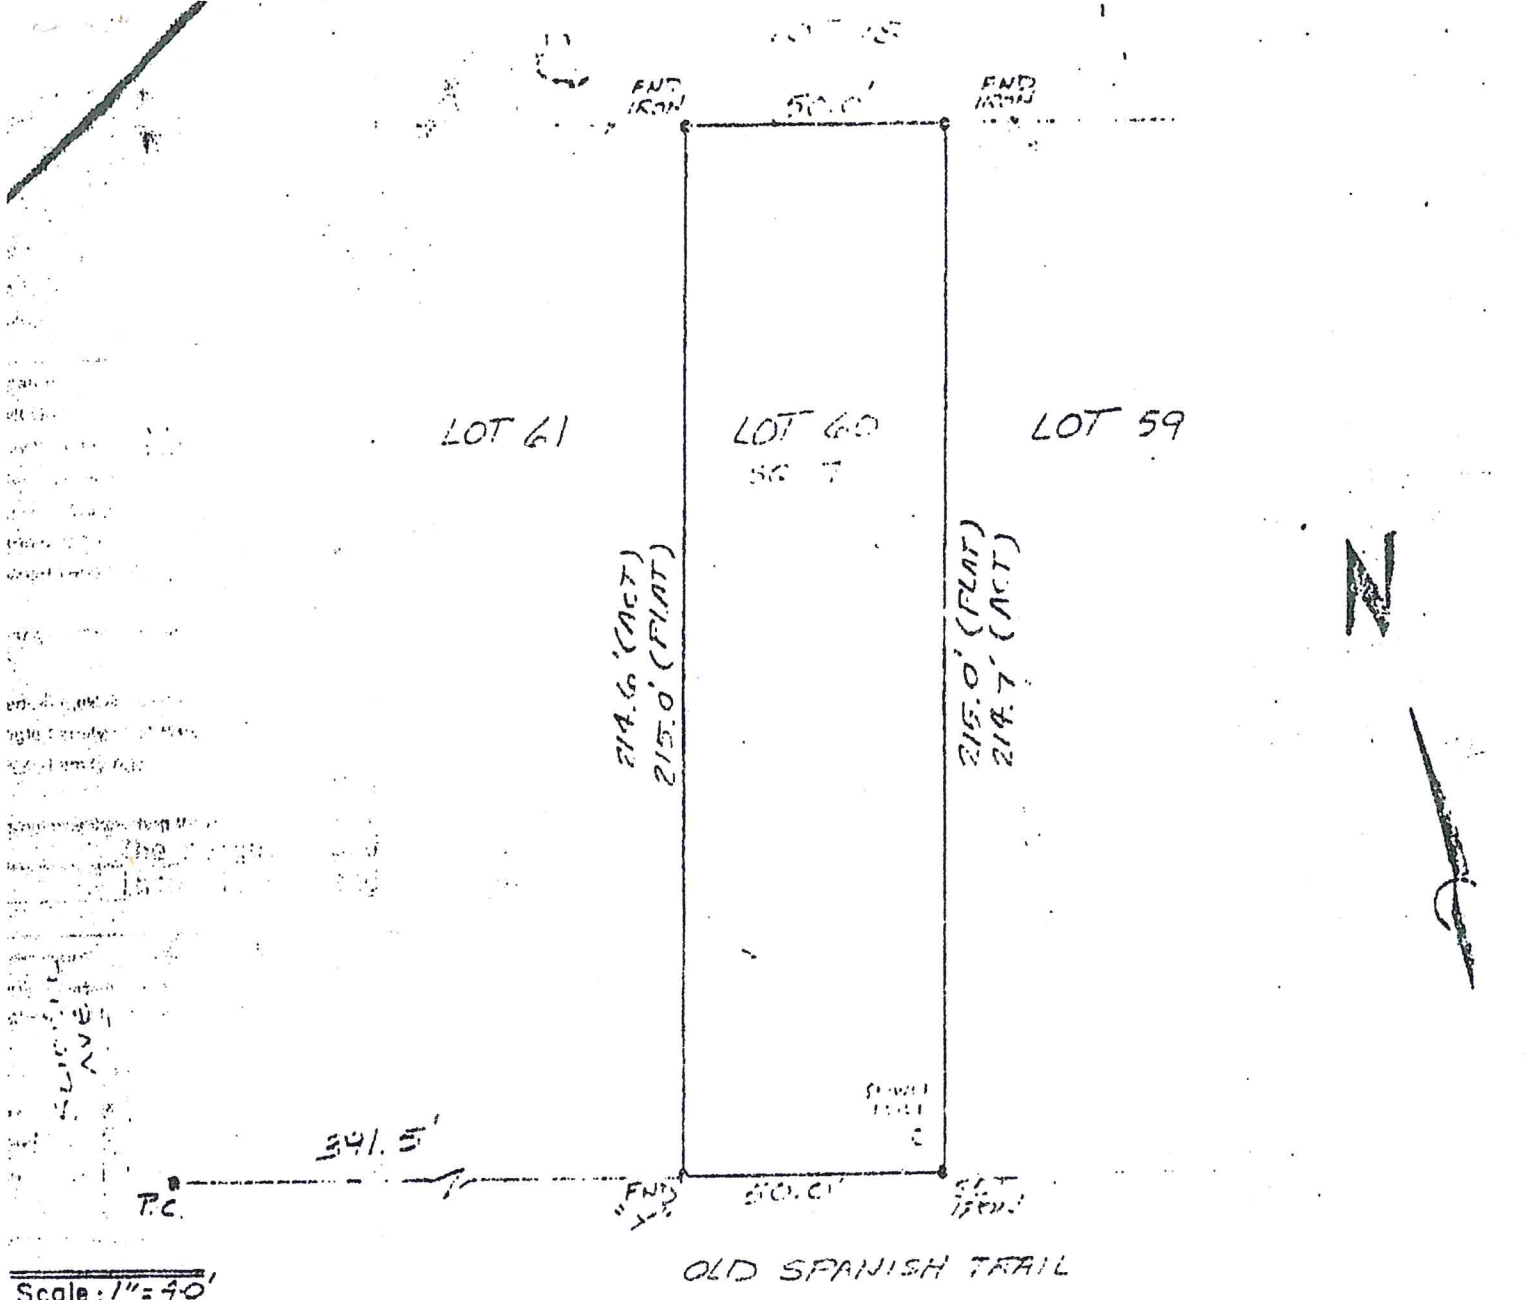

Scale: 1" = 40'

OLD SPANISH TRAIL

Survey Map


of
 Lot 60-SQUARE 7 in PINE CREST S/D - CITY OF ELICELL

in

St. Tammany Parish, Louisiana

for

THOMAS G. GANT

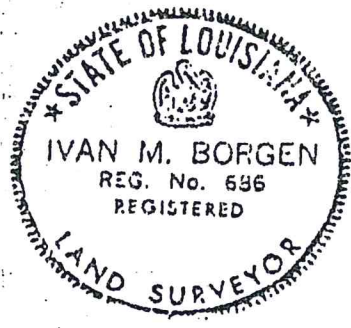

Survey Number: 39110
 Date: 11/1, 1924
 Revision:

Thomas G. Gant

This Survey is Certified True and Correct

Ivan M. Borgen

Ivan M. Borgen
 No. 686